


25/90

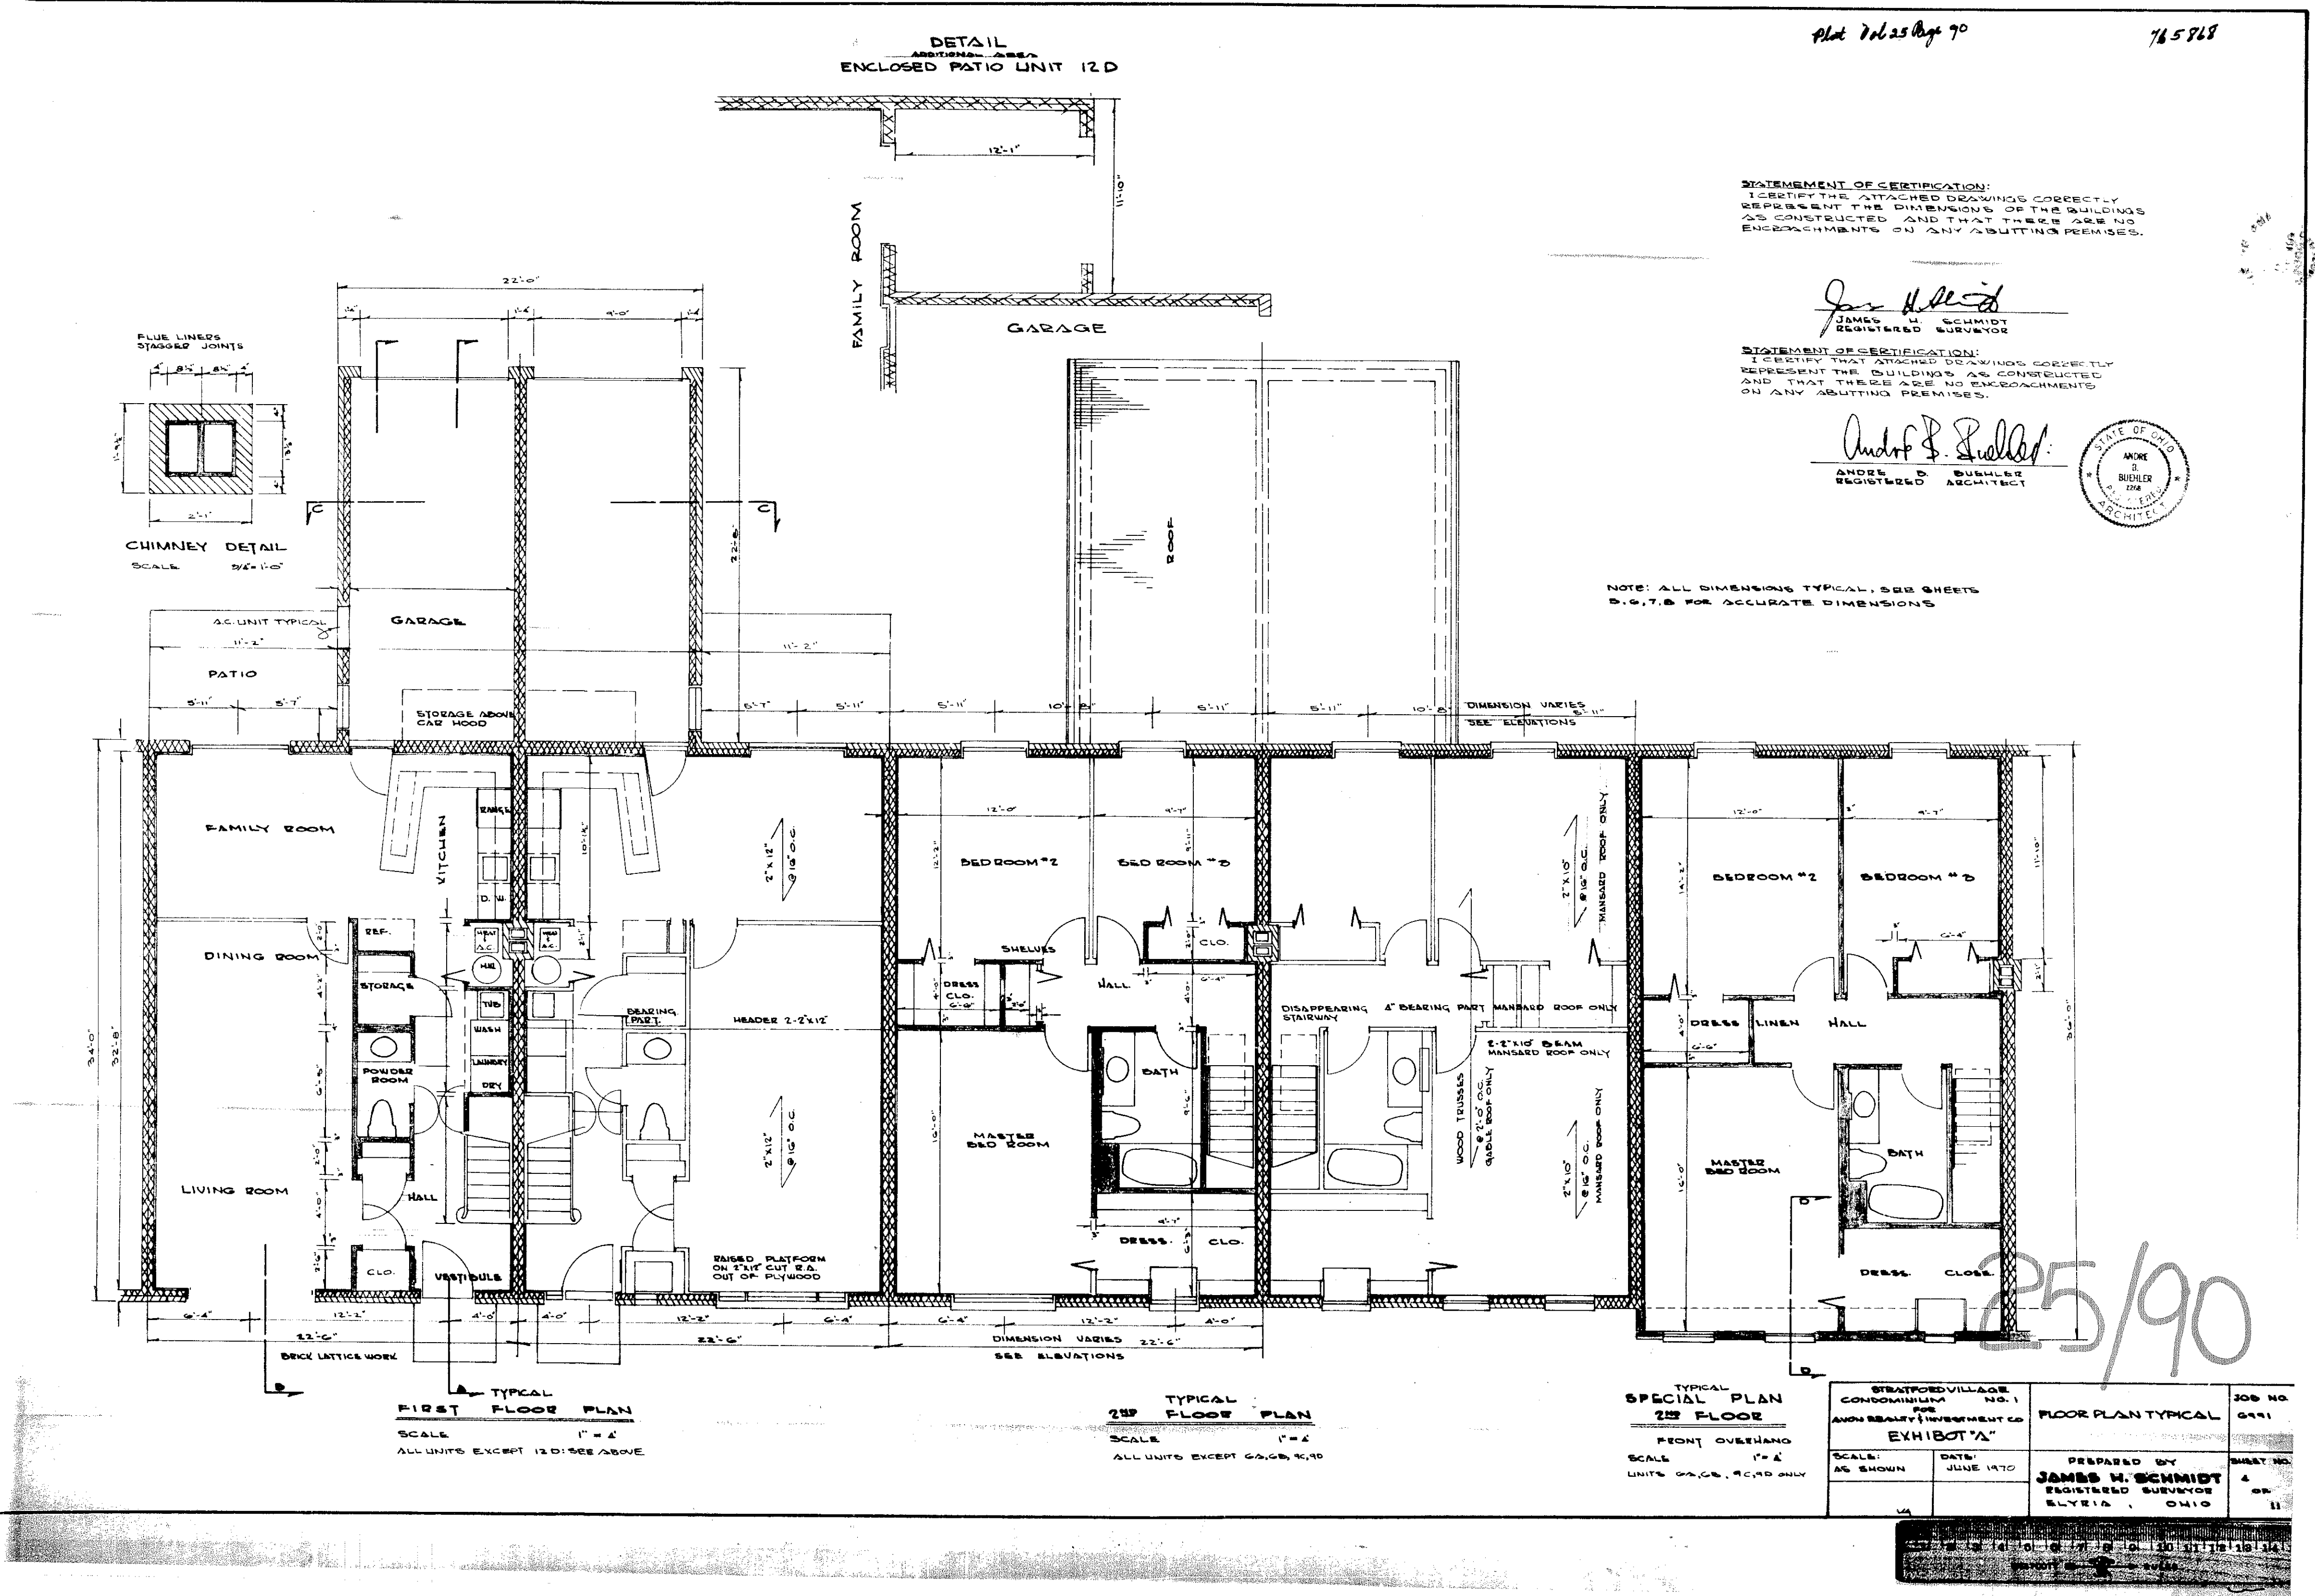

25/90

25/90