25/92

Plat Vol 25 Pg 92 76586

STATEMENT OF CERTIFICATION:
I CERTIFY THAT THE ATTACHED DRAWINGS CORRECTLY REPRESENT THE DIMENSIONS OF THE BUILDINGS AS CONSTRUCTED AND THAT THERE ARE NO ENCROACHMENTS ON ANY ABUTTING PREMISES.

JAMES H. SCHMIDT
REGISTERED SURVEYOR

STATEMENT OF CERTIFICATION:
I CERTIFY THAT THE ATTACHED DRAWINGS CORRECTLY REPRESENT THE BUILDINGS AS CONSTRUCTED AND THAT THERE ARE NO ENCROACHMENTS ON ANY ABUTTING PREMISES.

STATE OF OHIO · ANDRE B. BUEHLER · REGISTERED ARCHITECT

ANDRE B. BUEHLER
REGISTERED ARCHITECT

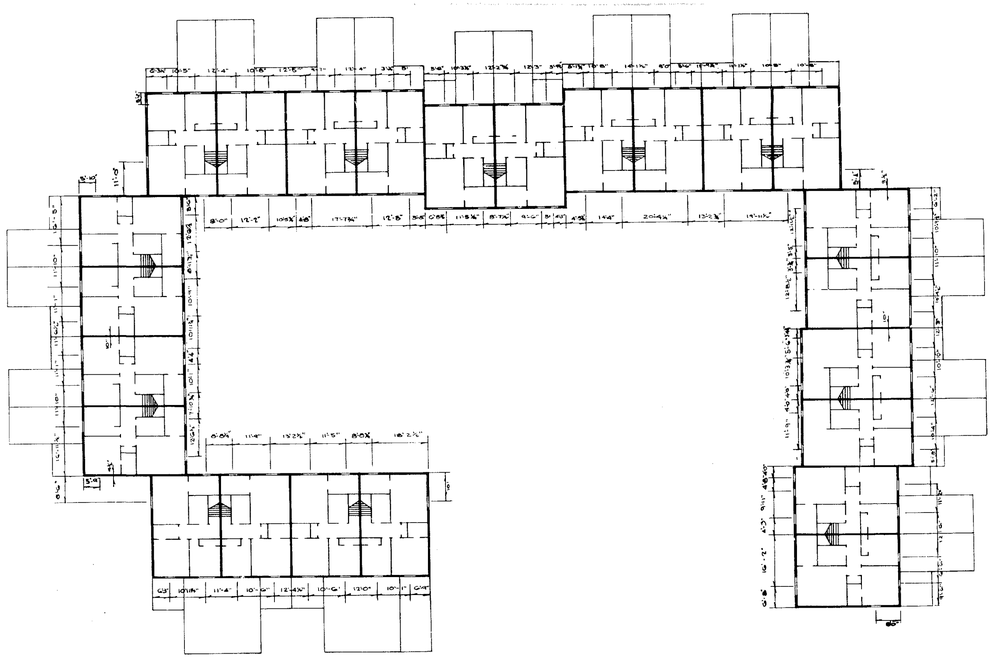

SECOND FLOOR PLAN
SCALE: 1/16" = 1'-0"

MACBETH COURT

NOTE: PATIOS ARE LIMITED COMMON AREA.

25/92

STRATFORD VILLAGE CONDOMINIUM NO. 1 FOR AMON REALTY & INVESTMENT EXHIBIT "A"		2ND FLOOR MACBETH CT.	JOB NO. 6791
SCALE: AS SHOWN	DATE: JUNE 1970	PREPARED BY JAMES H. SCHMIDT REGISTERED SURVEYOR ELYRIA, OHIO	SHEET NO. 9 OF 11

25/92

25/92