25/95

Plat Vol 25 Pg 95

765868

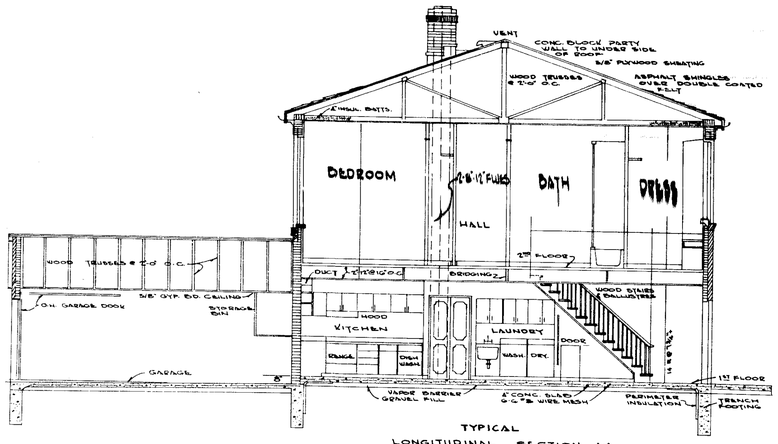

TYPICAL
LONGITUDINAL SECTION A-A
SCALE 1" = 4'

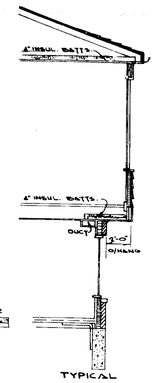

TYPICAL
SECTION of OVERHANG
SCALE 1" = 2'

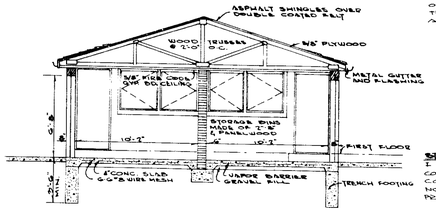

TYPICAL
GARAGE CROSS SECTION C-C
SCALE 1" = 2'

STATEMENT OF CERTIFICATION:

I CERTIFY THAT THE ATTACHED DRAWINGS CORRECTLY REPRESENT THE DIMENSIONS OF THE BUILDINGS AS CONSTRUCTED AND THAT THERE ARE NO ENCROACHMENTS ON ANY ABUTTING PREMISES.

JAMES H. SCHMIDT
REGISTERED SURVEYOR

STATE OF OHIO

STATEMENT OF CERTIFICATION:

I CERTIFY THAT THE ATTACHED DRAWINGS CORRECTLY REPRESENT THE BUILDINGS AS CONSTRUCTED AND THAT THERE ARE NO ENCROACHMENTS ON ANY ABUTTING PREMISES.

STATE OF OHIO
ANDRE D. BUEHLER
REGISTERED ARCHITECT

ANDRE D. BUEHLER
REGISTERED ARCHITECT

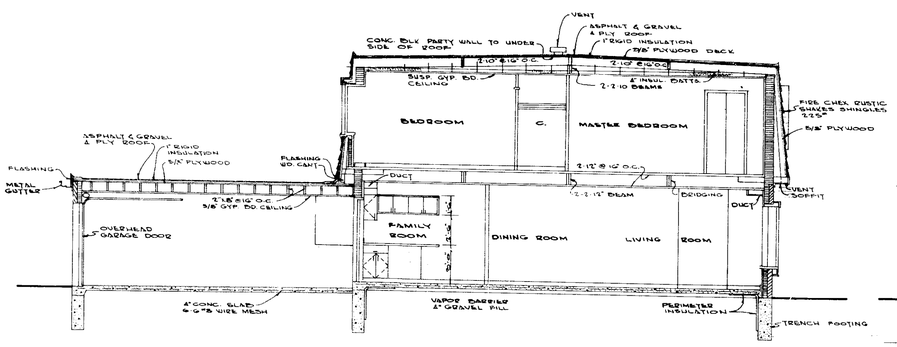

TYPICAL
LONGITUDINAL SECTION D-D
SCALE 1" = 2'

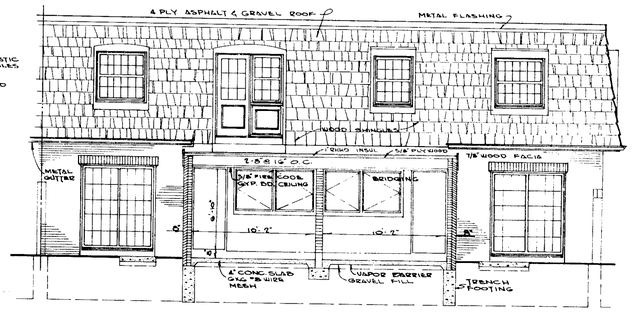

TYPICAL
GARAGE CROSS SECTION
SCALE 1" = 2'

25/95

STRATFORD VILLAGE CONDOMINIUM NO. 1 FOR ANSON REALTY & INVESTMENT CO. EXHIBIT "A"		SECTIONS DETAILS	JOB NO. 6991
SCALE: AS SHOWN	DATE: JUNE 1972	PREPARED BY JAMES H. SCHMIDT REGISTERED SURVEYOR ELYRIA, OHIO	SHEET NO. 4 OF 4

25/95