198412

198412

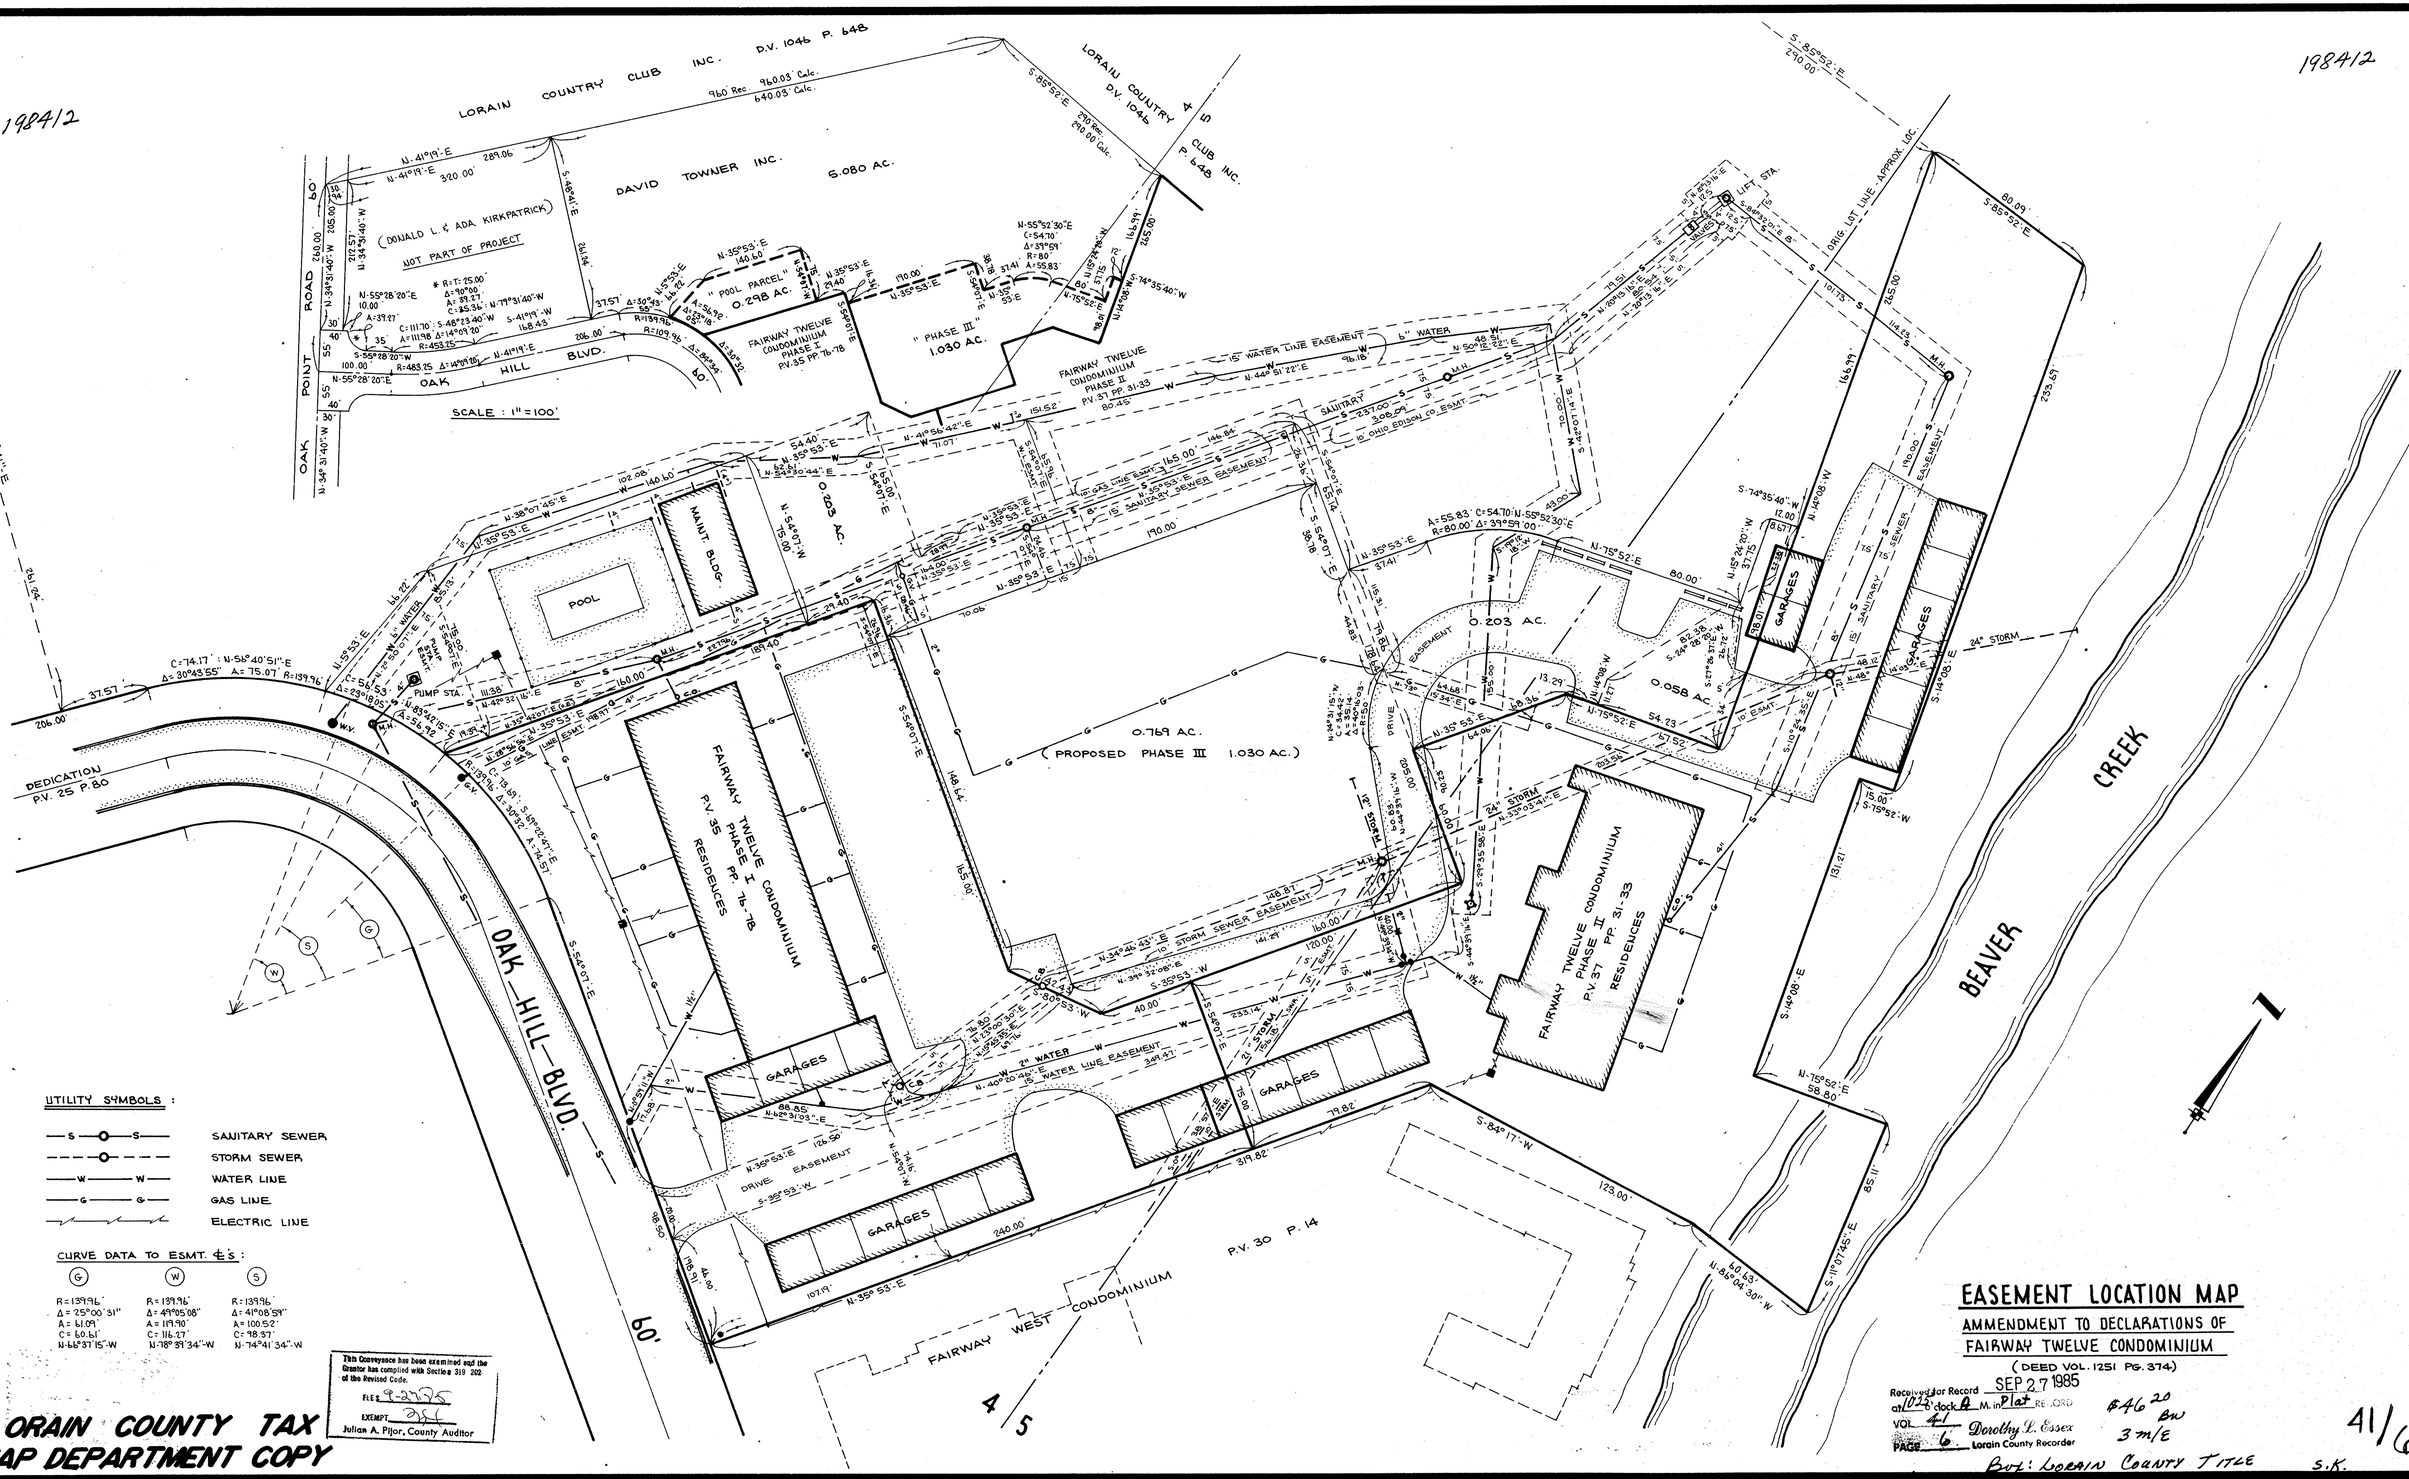

UTILITY SYMBOLS :

- S — S — SANITARY SEWER
- ---- STORM SEWER
- W — W — WATER LINE
- G — G — GAS LINE
- ELECTRIC LINE

CURVE DATA TO ESMT. E'S :

G	W	S
R = 1399.96'	R = 139.96'	R = 1399.96'
Δ = 25°00'31"	Δ = 49°05'08"	Δ = 41°08'59"
A = 61.09'	A = 119.90'	A = 100.52'
C = 60.61'	C = 116.27'	C = 98.37'
N-68°37'15"-W	N-78°31'34"-W	N-74°41'34"-W

This Conveyance has been examined and the Grantor has complied with Section 319.202 of the Revised Code.
FEE $ 9.2525
EXEMPT
Julian A. Pijor, County Auditor

LORAIN COUNTY TAX MAP DEPARTMENT COPY

EASEMENT LOCATION MAP

AMMENDMENT TO DECLARATIONS OF FAIRWAY TWELVE CONDOMINIUM
(DEED VOL. 1251 PG. 374)

Received for Record SEP 27 1985
at 10:22 o'clock A M. in Plat RE. ORD
VOL. 41 PAGE 6
Dorothy L. Essex, Lorain County Recorder
$46.20 BW
3 m/E

Bvt: LORAIN COUNTY TITLE S.K.

41/6











