
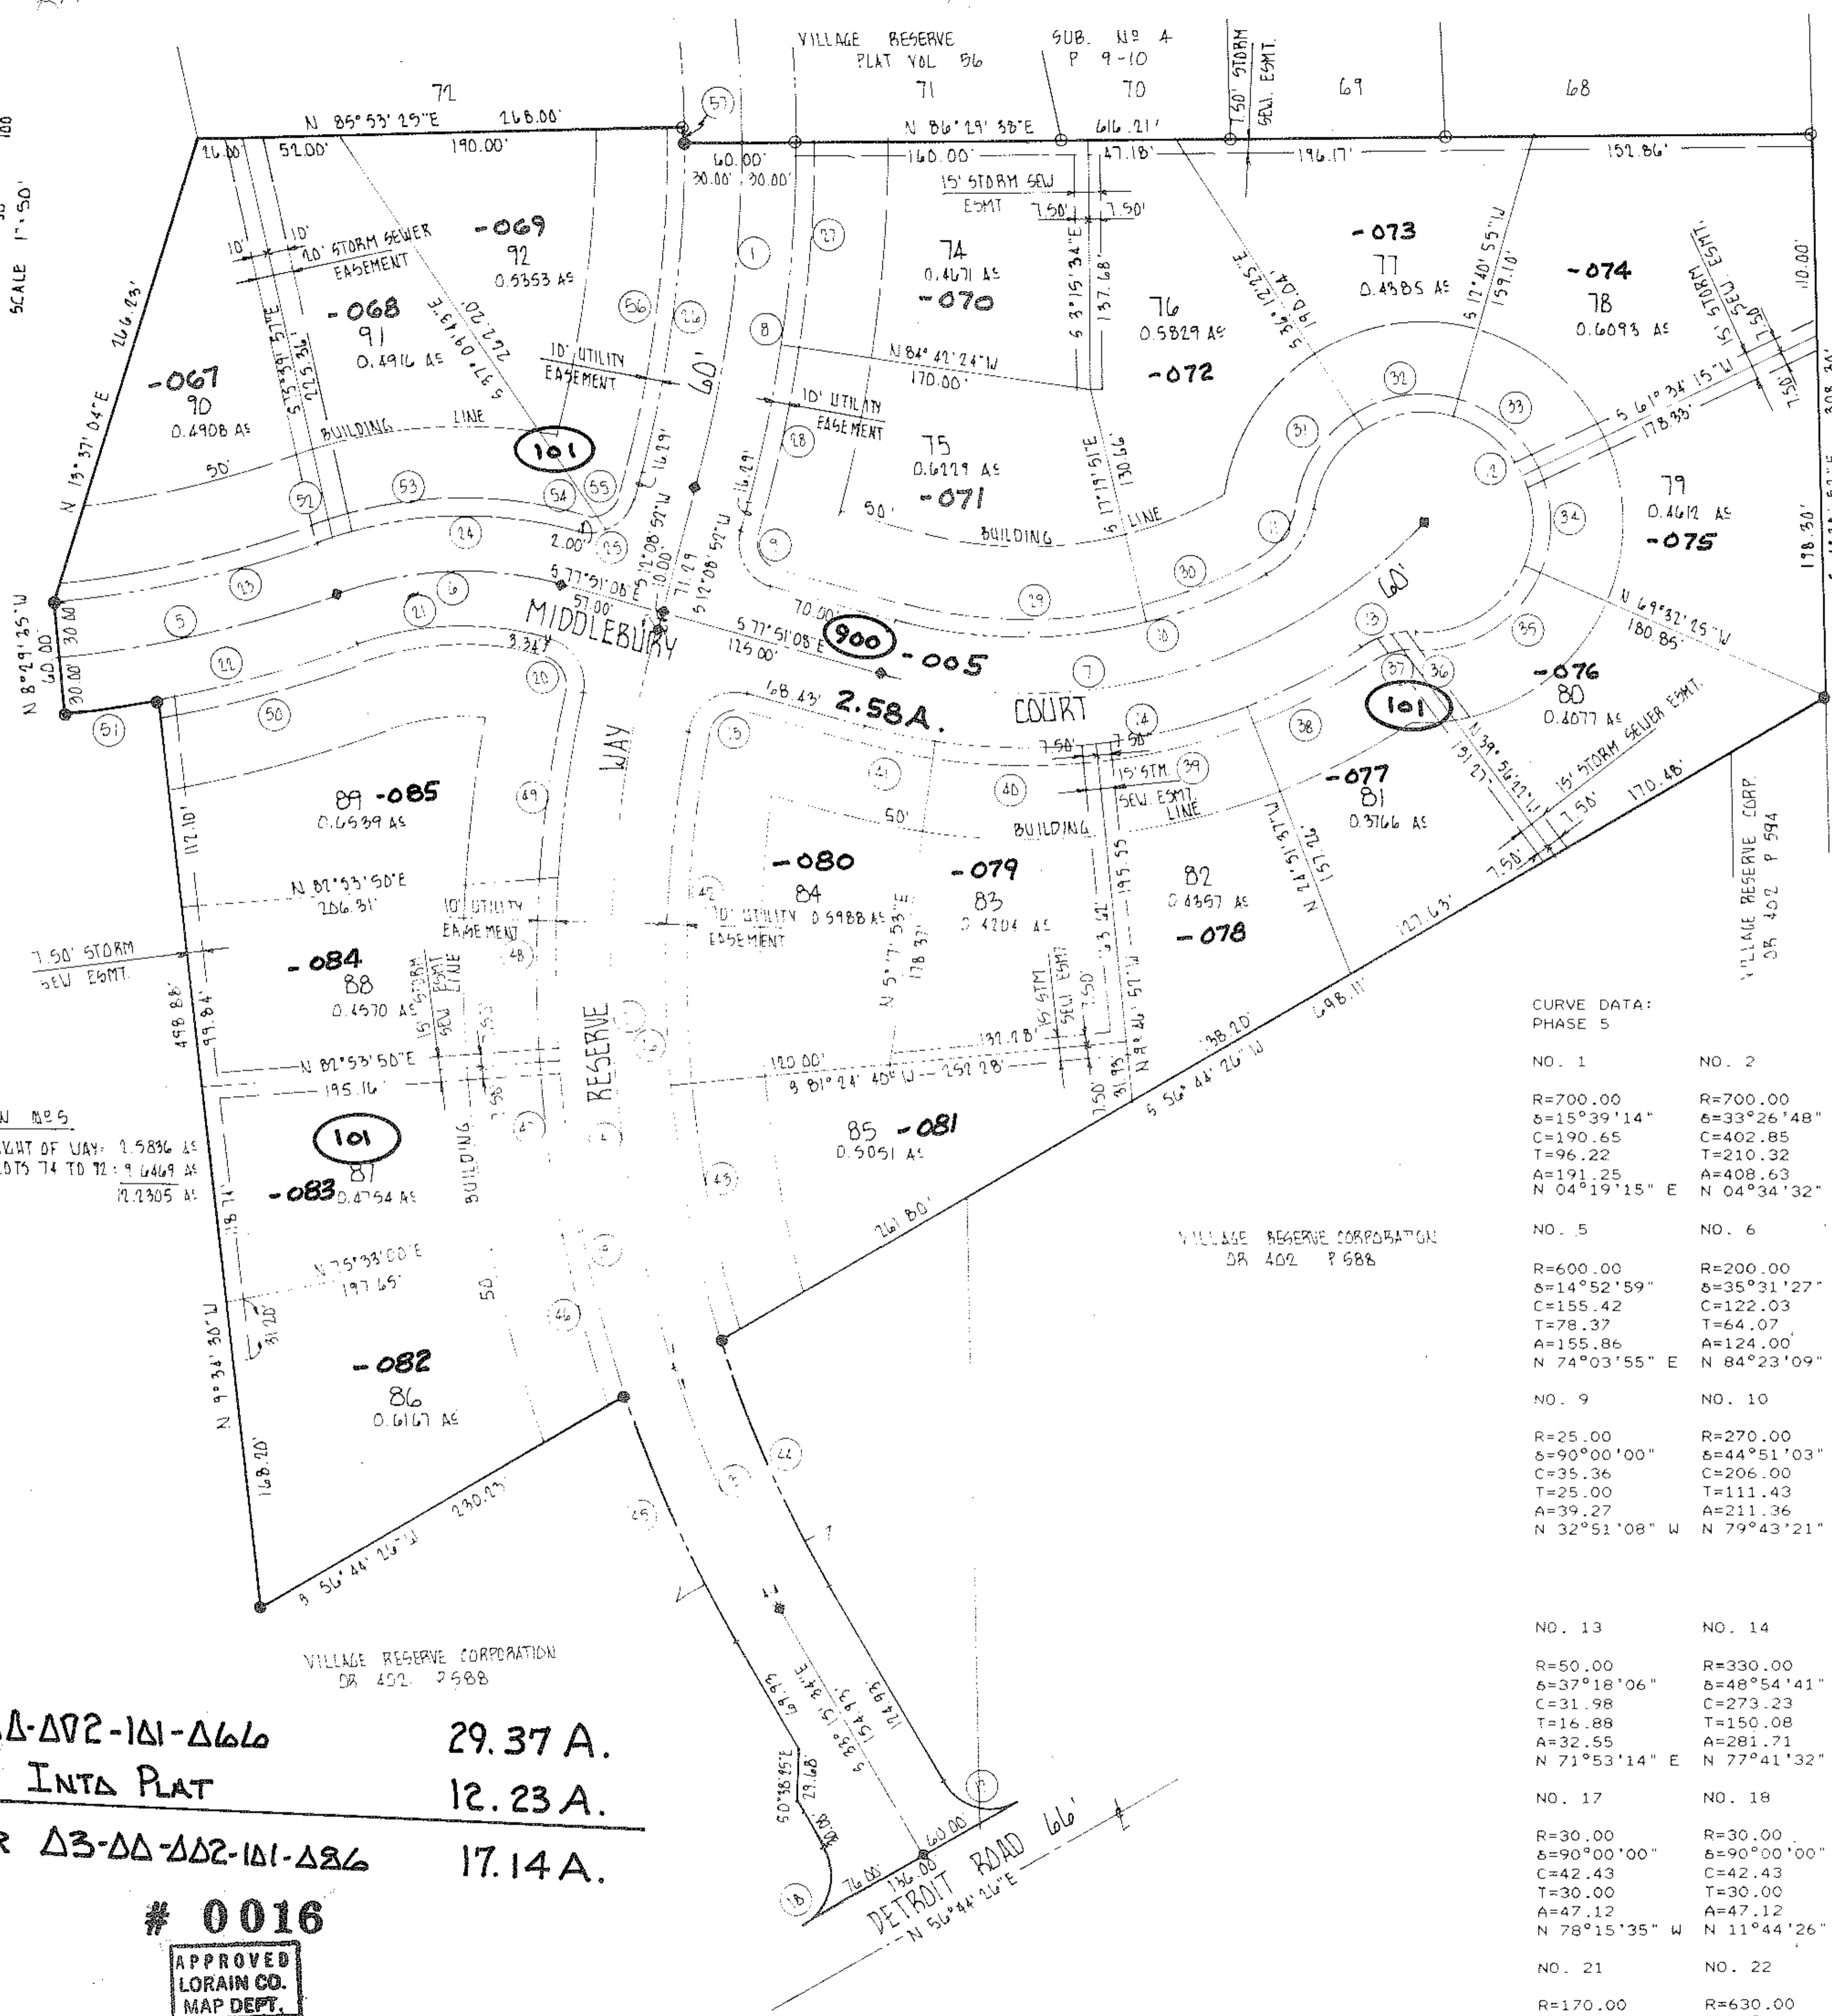


# VILLAGE RESERVE SUBD. NO. 5

3  
20

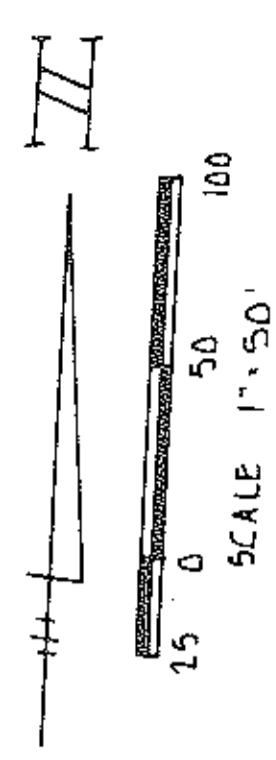

3-00-002-101-047  
STANLEY & PRISCILLA BOGALA  
BY 1077 P. 248

SUBDIVISION MAP  
AREA IN RIGHT OF WAY: 1.5836 AC  
AREA IN LOTS 74 TO 72: 9.6469 AC  

VILLAGE RESERVE CORPORATION  
DR 402 P 688

### CURVE DATA: PHASE 5

NO. 1 R=700.00 δ=15°39'14" C=190.65 T=96.22 A=191.25 N 04°19'15" E	NO. 2 R=700.00 δ=33°26'48" C=402.85 T=210.32 A=408.63 N 04°34'32" W	NO. 3 R=700.00 δ=11°57'38" C=145.86 T=73.33 A=146.13 N 27°16'45" W	NO. 4 R=700.00 δ=45°24'26" C=540.35 T=292.87 A=554.75 N 10°33'21" W	NO. 5 R=600.00 δ=14°52'59" C=155.42 T=78.37 A=155.86 N 74°03'55" E	NO. 6 R=200.00 δ=35°31'27" C=122.03 T=64.07 A=124.00 N 84°23'09" E	NO. 7 R=300.00 δ=61°45'00" C=307.90 T=179.37 A=323.32 N 71°16'22" E	NO. 8 R=730.00 δ=15°39'14" C=198.82 T=100.35 A=199.44 N 04°19'15" E	NO. 9 R=25.00 δ=90°00'00" C=35.36 T=25.00 A=39.27 N 32°51'08" W	NO. 10 R=270.00 δ=44°51'03" C=206.00 T=111.43 A=211.36 N 79°43'21" E	NO. 11 R=50.00 δ=52°26'47" C=44.19 T=24.63 A=45.77 N 31°04'25" E	NO. 12 R=60.00 δ=265°41'15" C= T= A=278.23 N	NO. 13 R=50.00 δ=37°18'06" C=31.98 T=16.88 A=32.55 N 71°53'14" E	NO. 14 R=330.00 δ=48°54'41" C=273.23 T=150.08 A=281.71 N 77°41'32" E	NO. 15 R=25.00 δ=94°00'03" C=36.57 T=26.81 A=41.02 N 55°08'51" E	NO. 16 R=670.00 δ=41°24'24" C=473.73 T=253.22 A=484.20 N 12°33'22" W	NO. 17 R=30.00 δ=90°00'00" C=42.43 T=30.00 A=47.12 N 78°15'35" W	NO. 18 R=30.00 δ=90°00'00" C=42.43 T=30.00 A=47.12 N 11°44'26" E	NO. 19 R=730.00 δ=41°59'25" C=523.10 T=280.15 A=534.99 N 12°15'52" W	NO. 20 R=25.00 δ=86°34'58" C=34.29 T=23.55 A=37.78 N 34°33'39" W	NO. 21 R=170.00 δ=35°31'27" C=103.72 T=54.46 A=105.40 N 84°23'09" E	NO. 22 R=630.00 δ=14°52'59" C=163.19 T=82.29 A=163.65 N 74°03'55" E	NO. 23 R=570.00 δ=14°52'59" C=147.65 T=74.45 A=148.06 N 74°03'55" E	NO. 24 R=230.00 δ=95°31'27" C=140.33 T=73.68 A=142.60 N 84°23'09" E	NO. 25 R=25.00 δ=90°00'00" C=35.36 T=25.00 A=39.27 N 57°08'52" E	NO. 26 R=670.00 δ=15°39'14" C=182.48 T=92.10 A=183.05 N 04°19'15" E	NO. 27 R=730.00 δ=08°47'57" C=112.00 T=56.17 A=112.11 N 00°53'37" E	NO. 28 R=730.00 δ=06°51'16" C=87.28 T=43.72 A=87.33 N 08°43'14" E	NO. 29 R=270.00 δ=29°28'44" C=137.39 T=71.03 A=138.92 N 87°24'30" E	NO. 30 R=270.00 δ=15°22'20" C=72.22 T=36.44 A=72.44 N 64°58'59" E	NO. 31 R=60.00 δ=48°56'33" C=49.71 T=27.31 A=51.25 N 29°19'19" E	NO. 32 R=60.00 δ=48°53'20" C=49.66 T=27.27 A=51.20 N 78°14'15" E	NO. 33 R=60.00 δ=48°53'20" C=49.66 T=27.27 A=51.20 N 52°52'25" W	NO. 34 R=60.00 δ=48°53'20" C=49.66 T=27.27 A=51.20 N 03°59'05" W	NO. 35 R=60.00 δ=68°04'42" C=68.90 T=42.07 A=73.39 N 55°29'56" E	NO. 36 R=50.00 δ=15°04'42" C=13.55 T=6.84 A=13.60 N 82°44'57" E	NO. 37 R=50.00 δ=21°43'25" C=18.84 T=9.59 A=18.96 N 64°05'53" E	NO. 38 R=330.00 δ=11°54'13" C=86.44 T=34.40 A=86.56 N 59°11'17" E	NO. 39 R=330.00 δ=15°04'45" C=86.60 T=43.68 A=86.85 N 72°40'46" E	NO. 40 R=330.00 δ=15°04'45" C=86.60 T=43.68 A=86.85 N 87°45'31" E	NO. 41 R=330.00 δ=06°50'59" C=39.43 T=19.75 A=39.45 N 81°16'37" W	NO. 42 R=670.00 δ=16°44'09" C=195.01 T=100.82 A=142.27 N 00°13'15" W	NO. 43 R=670.00 δ=12°09'58" C=142.00 T=71.40 A=142.27 N 14°40'19" W	NO. 44 R=670.00 δ=12°30'17" C=145.94 T=73.40 A=146.23 N 27°00'26" W	NO. 45 R=730.00 δ=11°27'44" C=145.80 T=73.26 A=146.04 N 27°31'42" W	NO. 46 R=730.00 δ=07°20'50" C=93.55 T=46.87 A=93.61 N 18°07'25" W	NO. 47 R=730.00 δ=07°20'50" C=93.55 T=46.87 A=93.61 N 10°46'35" W	NO. 48 R=730.00 δ=07°51'13" C=99.98 T=50.11 A=100.06 N 03°10'33" W	NO. 49 R=730.00 δ=07°58'48" C=101.59 T=50.92 A=101.67 N 04°44'27" E	NO. 50 R=630.00 δ=10°09'02" C=111.47 T=55.95 A=111.61 N 71°41'57" E	NO. 51 R=630.00 δ=04°43'57" C=52.02 T=26.03 A=52.04 N 79°08'26" E	NO. 52 R=230.00 δ=02°01'09" C=8.11 T=4.05 A=8.11 N 67°38'01" E	NO. 53 R=230.00 δ=33°30'17" C=132.59 T=69.23 A=134.50 N 85°23'44" E	NO. 54 R=25.00 δ=35°47'18" C=15.36 T=8.07 A=15.62 N 84°15'14" E	NO. 55 R=25.00 δ=54°12'42" C=22.78 T=12.80 A=23.65 N 39°15'13" E	NO. 56 R=670.00 δ=16°15'27" C=189.48 T=95.70 A=190.11 N 04°01'08" E	NO. 57 R=670.00 δ=00°36'14" C=7.06 T=3.53 A=7.06 N 03°48'27" W




Δ OUT Δ F  
Δ3-ΔΔ-ΔΔ2-1Δ1-ΔΔ6Δ  
INTA PLAT  
REMAINDER Δ3-ΔΔ-ΔΔ2-1Δ1-ΔΔ6Δ

29.37 A.  
12.23 A.  
17.14 A.

# 0016

APPROVED  
LORAIN CO.  
MAP DEPT.  
DATE 7-3-97  
PAGE 3 OF 3  
BY [Signature]  
AFTER 0016

59/19+20  
SHEET 2 OF 2  
PHASE 5

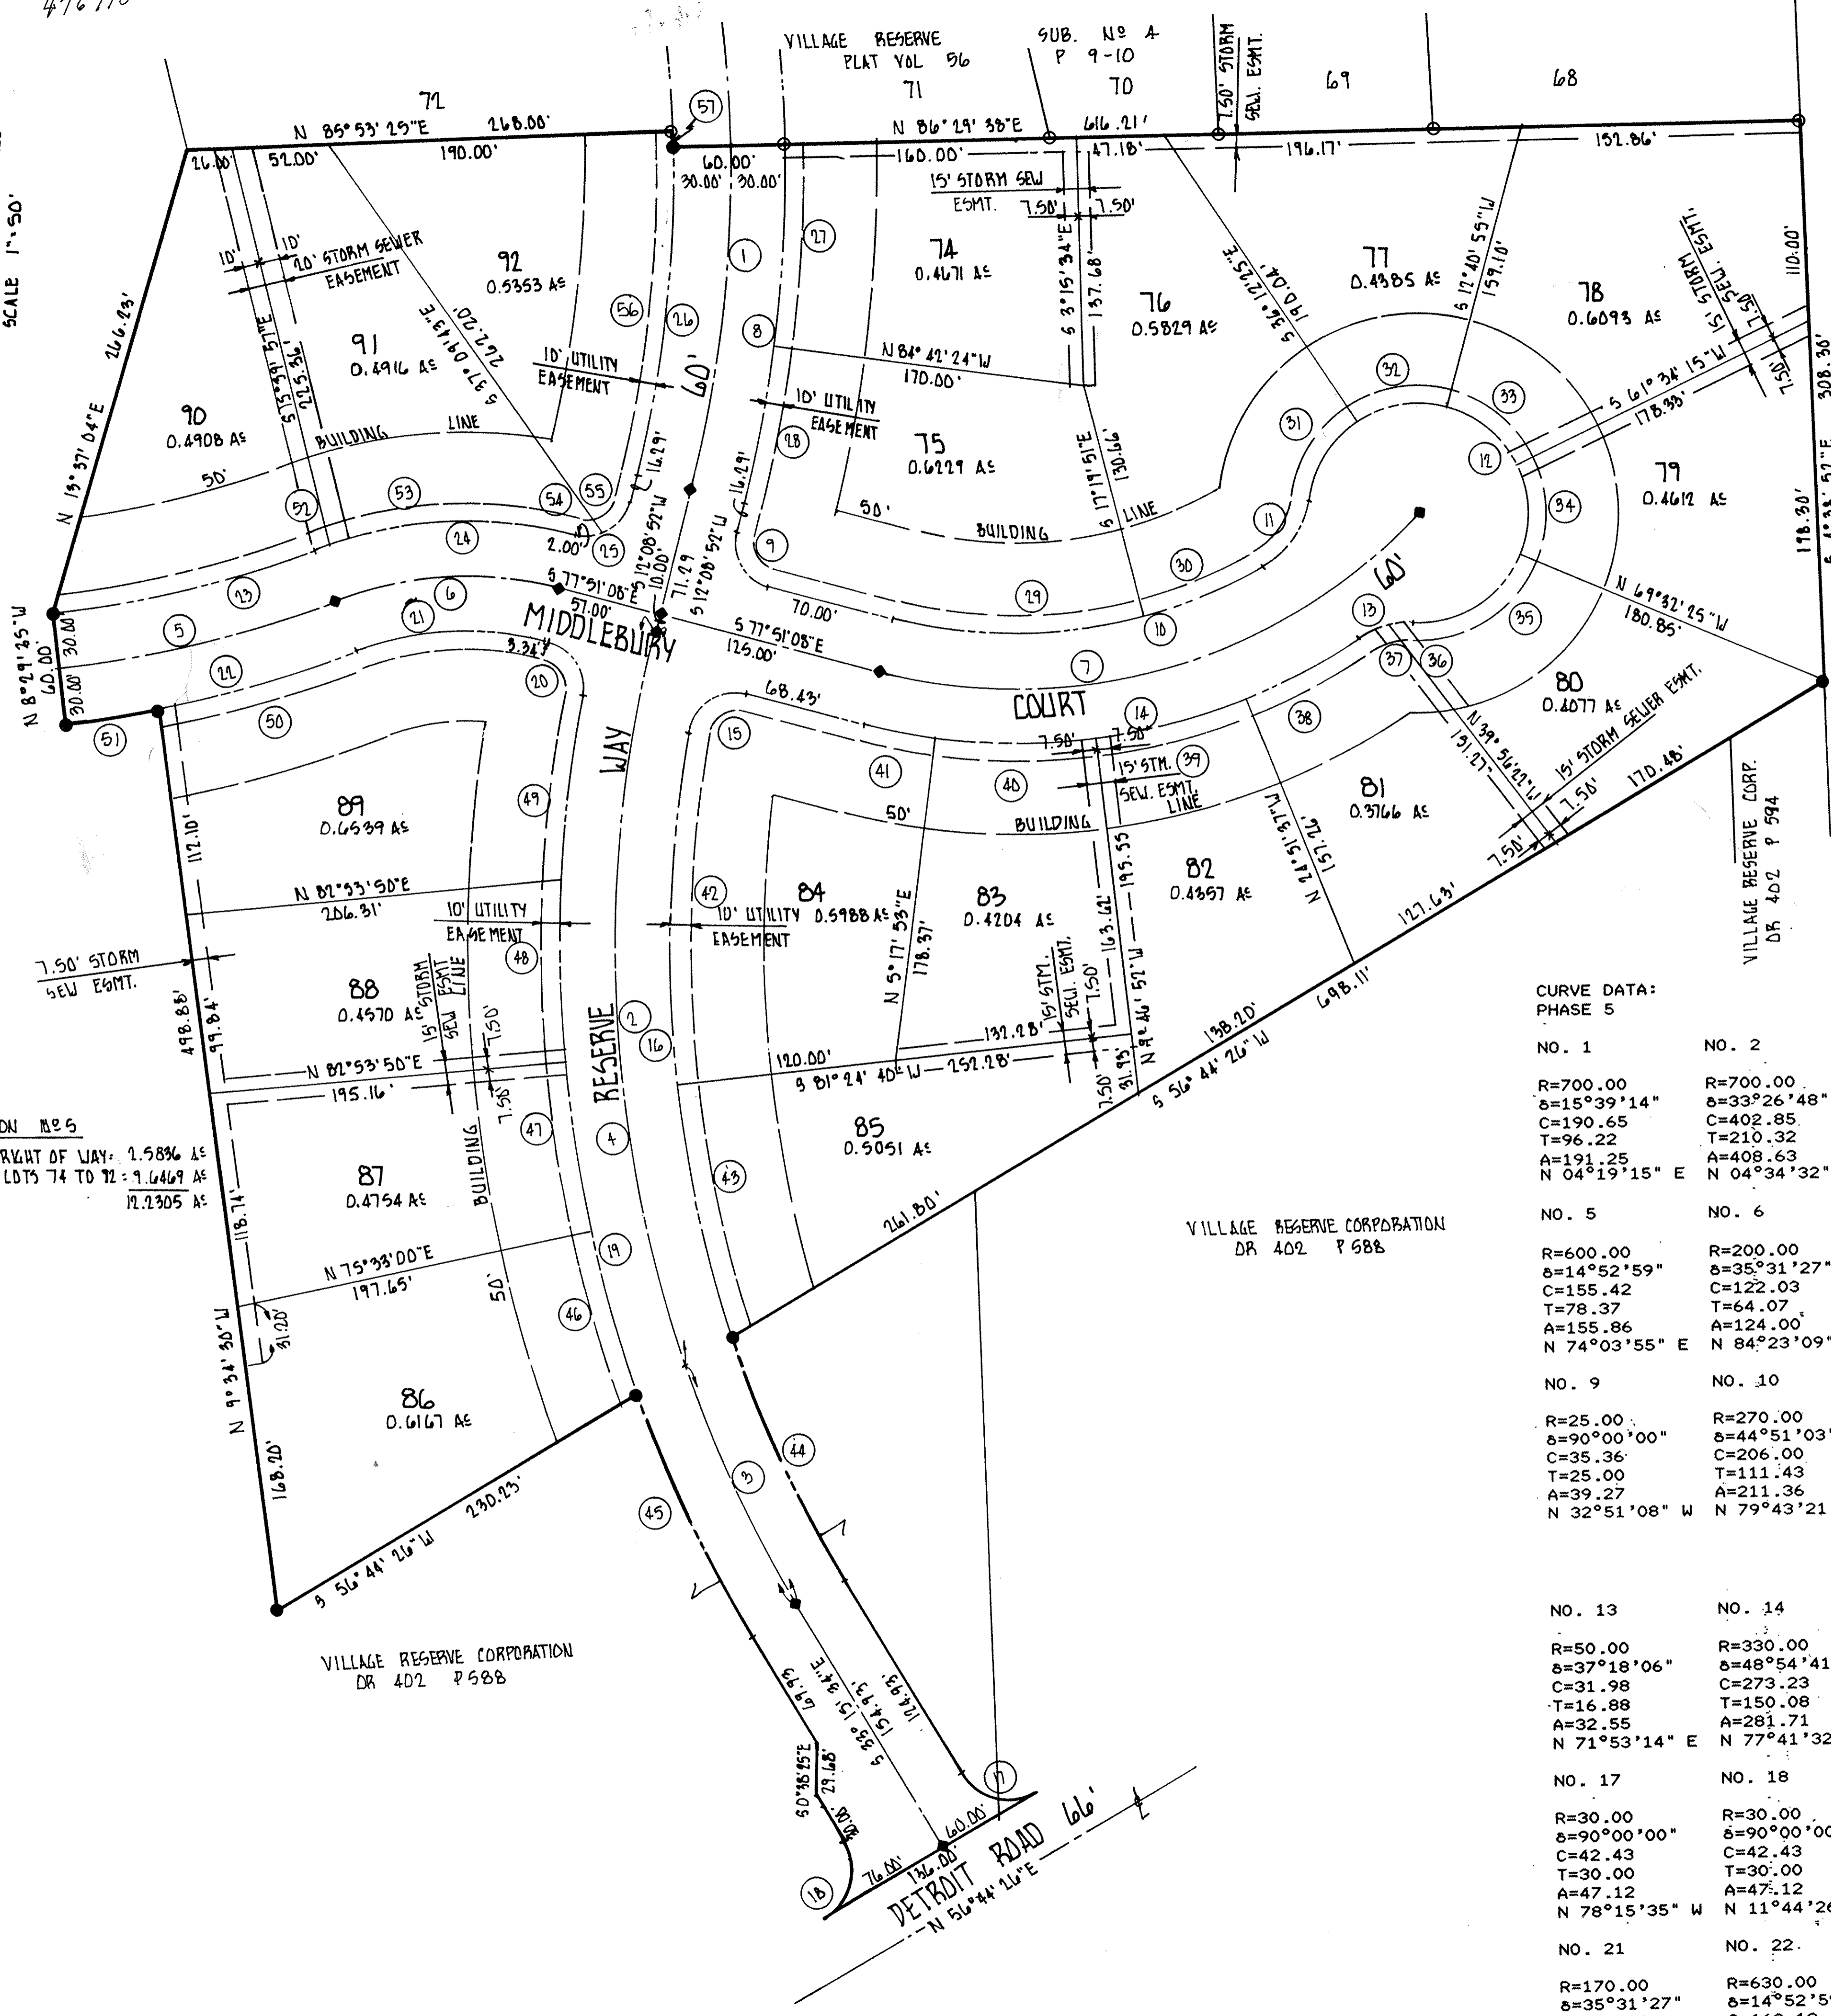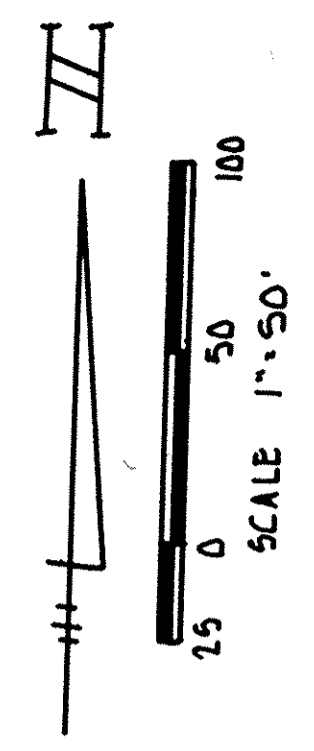

SUBDIVISION NO. 5  

VILLAGE RESERVE CORPORATION  
DR 402 P 688

VILLAGE RESERVE CORPORATION  
DR 402 P 688

3-00-002-101-047  
STANLEY & PRISCILLA RDGALA  
DV 1077 P 248

CURVE DATA:  
PHASE 5

4 R=700.00 δ=45°24'26" C=540.35 T=292.87 A=554.75 N 10°33'21" W	NO. 5 R=600.00 δ=14°52'59" C=155.42 T=78.37 A=155.86 N 74°03'55" E	NO. 6 R=200.00 δ=35°31'27" C=122.03 T=64.07 A=124.00 N 84°23'09" E	NO. 7 R=300.00 δ=61°45'00" C=307.90 T=179.37 A=323.32 N 71°16'22" E	NO. 8 R=730.00 δ=15°39'14" C=198.82 T=100.35 A=199.44 N 04°19'15" E	NO. 9 R=25.00 δ=90°00'00" C=35.36 T=25.00 A=39.27 N 32°51'08" W	NO. 10 R=270.00 δ=44°51'03" C=206.00 T=111.43 A=211.36 N 79°43'21" E	NO. 11 R=50.00 δ=52°26'47" C=44.19 T=24.63 A=45.77 N 31°04'25" E	NO. 12 R=60.00 δ=265°41'15" C= T= A=278.23 N	NO. 13 R=50.00 δ=37°18'06" C=31.98 T=16.88 A=32.55 N 71°53'14" E	NO. 14 R=330.00 δ=48°54'41" C=273.23 T=150.08 A=281.71 N 77°41'32" E	NO. 15 R=25.00 δ=94°00'03" C=36.57 T=26.81 A=41.02 N 55°08'51" E	NO. 16 R=670.00 δ=41°24'24" C=473.73 T=253.22 A=484.20 N 12°33'22" W	NO. 17 R=30.00 δ=90°00'00" C=42.43 T=30.00 A=47.12 N 78°15'35" W	NO. 18 R=30.00 δ=90°00'00" C=42.43 T=30.00 A=47.12 N 11°44'26" E	NO. 19 R=730.00 δ=41°59'25" C=523.10 T=280.15 A=534.99 N 12°15'52" W	NO. 20 R=25.00 δ=86°34'58" C=34.29 T=23.55 A=37.78 N 34°33'39" W	NO. 21 R=170.00 δ=35°31'27" C=103.72 T=54.46 A=105.40 N 84°23'09" E	NO. 22 R=630.00 δ=14°52'59" C=163.19 T=82.29 A=163.65 N 74°03'55" E	NO. 23 R=570.00 δ=14°52'59" C=147.65 T=74.45 A=148.06 N 74°03'55" E	NO. 24 R=230.00 δ=35°31'27" C=140.33 T=73.68 A=142.60 N 84°23'09" E
--------------------------------------------------------------------------------------	---------------------------------------------------------------------------------------	--------------------------------------------------------------------------------------	---------------------------------------------------------------------------------------	--------------------------------------------------------------------------------------	--------------------------------------------------------------------------------------	---------------------------------------------------------------------------------------	---------------------------------------------------------------------------------------	-----------------------------------------------------------------------------------	----------------------------------------------------------------------------------------	------------------------------------------------------------------------------------	----------------------------------------------------------------	------------------------------------------------------------------------------------	----------------------------------------------------------------------------------------	------------------------------------------------------------------------------------	----------------------------------------------------------------------------------------	------------------------------------------------------------------------------------	------------------------------------------------------------------------------------	----------------------------------------------------------------------------------------	------------------------------------------------------------------------------------	---------------------------------------------------------------------------------------	---------------------------------------------------------------------------------------	---------------------------------------------------------------------------------------	---------------------------------------------------------------------------------------

NO. 25 R=25.00 δ=90°00'00" C=35.36 T=25.00 A=39.27 N 57°08'52" E	NO. 26 R=670.00 δ=15°39'14" C=182.48 T=92.10 A=183.05 N 04°19'15" E	NO. 27 R=730.00 δ=08°47'57" C=112.00 T=56.17 A=112.11 N 00°53'37" E	NO. 28 R=730.00 δ=06°51'16" C=87.28 T=43.72 A=87.33 N 08°43'14" E	NO. 29 R=270.00 δ=29°28'44" C=137.39 T=71.03 A=138.92 N 87°24'30" E	NO. 30 R=270.00 δ=15°22'20" C=72.22 T=36.44 A=72.44 N 64°58'59" E	NO. 31 R=60.00 δ=48°56'33" C=49.71 T=27.31 A=51.25 N 29°19'19" E	NO. 32 R=60.00 δ=48°56'33" C=49.66 T=27.27 A=51.20 N 78°14'15" E	NO. 33 R=60.00 δ=48°56'33" C=49.66 T=27.27 A=51.20 N 52°52'25" W	NO. 34 R=60.00 δ=48°56'33" C=49.66 T=27.27 A=51.20 N 03°59'05" W	NO. 35 R=60.00 δ=70°04'42" C=68.90 T=42.07 A=73.39 N 55°29'56" E	NO. 36 R=50.00 δ=15°34'42" C=13.55 T=6.84 A=13.60 N 82°44'57" E	NO. 37 R=50.00 δ=21°43'25" C=18.84 T=9.59 A=18.96 N 64°05'53" E	NO. 38 R=330.00 δ=11°54'13" C=86.44 T=34.40 A=86.56 N 59°11'17" E	NO. 39 R=330.00 δ=15°04'45" C=86.60 T=43.68 A=86.85 N 72°40'46" E	NO. 40 R=330.00 δ=15°04'45" C=86.60 T=43.68 A=86.85 N 87°45'31" E	NO. 41 R=330.00 δ=06°50'59" C=39.43 T=19.75 A=39.45 N 81°16'37" W	NO. 42 R=670.00 δ=16°44'09" C=195.01 T=98.55 A=195.70 N 00°13'15" W	NO. 43 R=670.00 δ=12°09'58" C=142.00 T=71.40 A=142.27 N 14°40'19" W	NO. 44 R=670.00 δ=12°30'17" C=145.94 T=73.40 A=146.23 N 29°00'26" W	NO. 45 R=730.00 δ=11°27'44" C=145.80 T=73.26 A=146.04 N 27°31'42" W	NO. 46 R=730.00 δ=07°20'50" C=93.55 T=46.87 A=93.61 N 18°07'25" W	NO. 47 R=730.00 δ=07°20'50" C=93.55 T=46.87 A=93.61 N 10°46'35" W	NO. 48 R=730.00 δ=07°51'13" C=99.98 T=50.11 A=100.06 N 03°10'33" W	NO. 49 R=730.00 δ=07°58'48" C=101.59 T=50.92 A=101.67 N 04°44'27" E	NO. 50 R=630.00 δ=10°09'02" C=111.47 T=55.95 A=111.61 N 71°41'57" E	NO. 51 R=630.00 δ=04°43'57" C=52.02 T=26.03 A=52.04 N 79°08'26" E	NO. 52 R=230.00 δ=02°01'09" C=8.11 T=4.05 A=8.11 N 67°38'01" W	NO. 53 R=230.00 δ=33°30'17" C=132.59 T=69.23 A=134.50 N 85°23'44" E	NO. 54 R=25.00 δ=35°47'18" C=15.36 T=8.07 A=15.62 N 84°15'14" E	NO. 55 R=25.00 δ=54°12'42" C=22.78 T=12.80 A=23.65 N 39°15'13" E	NO. 56 R=670.00 δ=16°15'27" C=189.48 T=95.70 A=190.11 N 04°01'08" W	NO. 57 R=670.00 δ=00°36'14" C=7.06 T=3.53 A=7.06 N 03°48'27" W
------------------------------------------------------------------------------------	---------------------------------------------------------------------------------------	---------------------------------------------------------------------------------------	-------------------------------------------------------------------------------------	---------------------------------------------------------------------------------------	-------------------------------------------------------------------------------------	------------------------------------------------------------------------------------	------------------------------------------------------------------------------------	------------------------------------------------------------------------------------	------------------------------------------------------------------------------------	------------------------------------------------------------------------------------	-----------------------------------------------------------------------------------	-----------------------------------------------------------------------------------	-------------------------------------------------------------------------------------	-------------------------------------------------------------------------------------	-------------------------------------------------------------------------------------	-------------------------------------------------------------------------------------	---------------------------------------------------------------------------------------	---------------------------------------------------------------------------------------	---------------------------------------------------------------------------------------	---------------------------------------------------------------------------------------	-------------------------------------------------------------------------------------	-------------------------------------------------------------------------------------	--------------------------------------------------------------------------------------	---------------------------------------------------------------------------------------	---------------------------------------------------------------------------------------	-------------------------------------------------------------------------------------	----------------------------------------------------------------------------------	---------------------------------------------------------------------------------------	-----------------------------------------------------------------------------------	------------------------------------------------------------------------------------	---------------------------------------------------------------------------------------	----------------------------------------------------------------------------------

TAX MAP DEPT # 0016