

**LEGEND**

- 5/8" CAPPED REBAR SET
- IRON PIN FOUND
- ⊠ MONUMENT BOX FOUND

**TOTAL AREA PHASE 24**  
0.2193 AC.

CURVE DATA						
CURVE	RADIUS	LENGTH	TANGENT	CHORD	BEARING	DELTA
C1	25.00'	39.27'	25.00'	35.36'	N48°54'17"E	90°00'00"
C2	89.00'	97.60'	54.36'	92.78'	S35°19'14"W	62°49'55"
C3	24.09'	28.52'	16.20'	26.88'	N52°10'47"W	67°49'53"
C4	111.00'	41.42'	20.95'	41.18'	S56°02'47"W	21°22'49"
C5	289.00'	92.98'	46.90'	92.58'	N57°31'10"E	18°26'05"
C6	289.00'	62.80'	31.52'	62.67'	N29°00'29"E	12°26'59"
C7	111.00'	61.91'	31.78'	61.11'	S38°45'42"W	31°57'26"
C8	89.00'	106.91'	60.97'	100.60'	N57°11'42"E	68°49'27"
C9	311.00'	48.48'	24.29'	48.43'	N35°46'40"E	8°55'51"
C10	311.00'	89.98'	45.31'	89.67'	N58°26'52"E	16°34'40"
C11	311.00'	47.79'	23.94'	47.74'	N54°33'40"E	8°48'16"
C12	311.00'	42.19'	21.13'	42.16'	N62°51'00"E	7°46'24"

CONTINUED ON SHEET 3


**SHEET INDEX**

SHEET NO.	DESCRIPTION
1	SURVEY MAP & MISC.
2	SURVEY MAP & MISC. CONTINUED
3	CURVE DATA & OWNERSHIP TABLE
4	FLOOR & FOUNDATION PLANS
5	ELEVATION VIEWS



TRANSFERRED  
AUG 24 2006  
MARK R. STEWART  
LORAIN COUNTY AUDITOR

**CERTIFICATION**  
THIS IS TO CERTIFY THAT THE ATTACHED DRAWINGS CORRECTLY REPRESENT THE BUILDINGS AS CONSTRUCTED AND THAT THERE ARE NO ENCROACHMENTS ON ADJUTING PROPERTIES, EXCEPT AS SHOWN.

Jeffrey R. Keeffe  
JEFFREY R. KEEFFE  
PROFESSIONAL ENGINEER NO. 58389

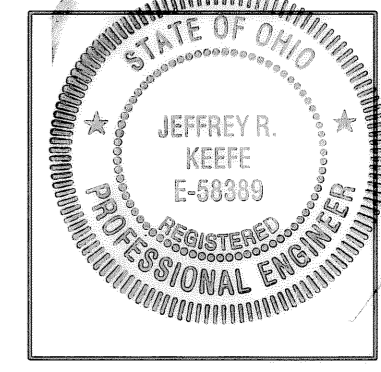

David L. Elwell  
DAVID L. ELWELL  
PROFESSIONAL SURVEYOR NO. 6333

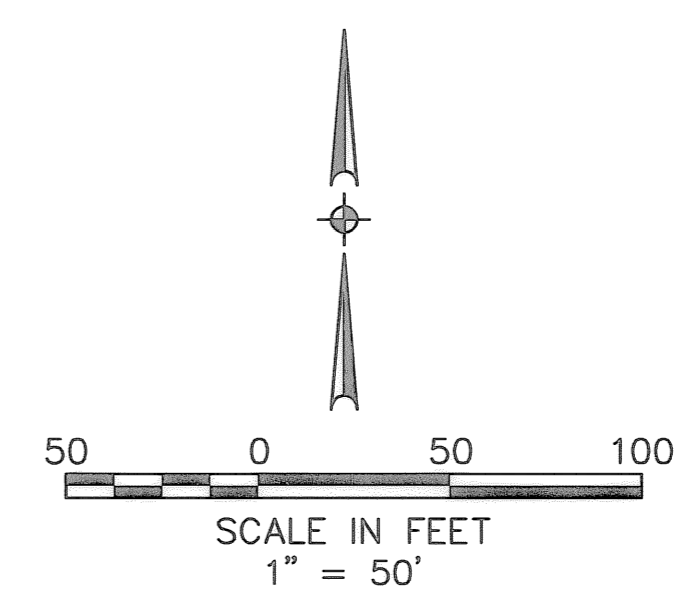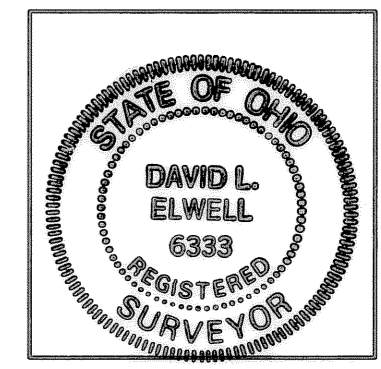

REVISIONS	DATE	DESCRIPTION	BY
	08-08-05	ORIGINAL ISSUE	BAP

**KS ASSOCIATES**  
KS ASSOCIATES, INC.  
260 Burns Road, Suite 100  
Elyria, Ohio 44035  
Phone (440) 365-4730  
Fax (440) 365-4790  
mailroom@ksassoc.com  
www.ksassoc.com

**STONEHEDGE CONDOMINIUMS**  
**PHASE NO. 24**  
PART OF  
CARLISLE TOWNSHIP SECTION NO. 5  
CITY OF ELYRIA COUNTY OF LORAIN STATE OF OHIO

SHEET  
1 OF  
5  
JOB NO.  
92424-CP24



**CURVE DATA**

A Δ = 38°07'27" R = 25.00' T = 8.64' L = 16.63' C = 16.33' CB = S25°28'22"E	N Δ = 20°15'21" R = 190.00' T = 33.94' L = 67.17' C = 66.82' CB = N72°54'03"E	AA Δ = 51°10'38" R = 87.45' T = 41.88' L = 78.11' C = 75.54' CB = S21°11'35"E	MM R=44.00' L=12.25' Tan=6.16' Δ=15°57'06" CH=12.21' CB=S56°22'15"E	XX R=111.00' L=35.01' Tan=17.65' Δ=18°04'23" CH=34.87' CB=S08°03'11"E	1I R=89.00' L=28.07' Tan=14.15' Δ=18°04'23" CH=27.96' CB=N08°03'11"W
B Δ = 80°47'16" R = 130.00' T = 110.61' L = 183.30' C = 168.49' CB = S42°38'06"W	O Δ = 56°14'17" R = 190.00' T = 101.53' L = 186.49' C = 179.10' CB = N54°54'35"E	BB Δ = 58°56'55" R = 71.00' T = 40.13' L = 73.05' C = 69.87' CB = N25°34'00"W	NN R=44.00' L=12.03' Tan=6.05' Δ=15°39'39" CH=11.99' CB=N28°18'46"E	YY R=25.00' L=39.27' Tan=25.00' Δ=90°00'00" CH=35.36' CB=S44°01'00"E	1J R=25.00' L=39.27' Tan=25.00' Δ=90°00'00" CH=35.36' CB=N62°05'23"W
C Δ = 24°32'58" R = 190.00' T = 41.34' L = 81.41' C = 80.79' CB = N14°30'57"E	P Δ = 32°18'52" R = 66.00' T = 19.12' L = 37.22' C = 36.73' CB = N77°00'57"W	CC Δ = 33°20'33" R = 87.45' T = 26.19' L = 50.89' C = 50.18' CB = S12°16'32"E	OO R=66.00' L=19.04' Tan=9.59' Δ=16°31'41" CH=18.97' CB=S33°46'12"E	ZZ R=25.00' L=4.88' Tan=2.45' Δ=11°11'22" CH=4.87' CB=N85°23'19"E	1K R=44.00' L=44.13' Tan=24.12' Δ=57°27'39" CH=4.87' CB=S53°08'48"W
D Δ = 40°05'31" R = 25.00' T = 9.12' L = 17.49' C = 17.14' CB = N13°39'13"E	Q Δ = 26°48'49" R = 66.00' T = 15.73' L = 30.89' C = 30.81' CB = N17°49'23"W	DD Δ = 17°50'05" R = 87.45' T = 13.72' L = 27.22' C = 27.11' CB = S37°51'51"E	PP R=89.00' L=47.22' Tan=24.18' Δ=30°24'05" CH=46.67' CB=S57°42'35"W	1A R=27.50' L=27.57' Tan=15.07' Δ=57°27'05" CH=26.43' CB=S71°28'49"E	1L R=44.00' L=41.07' Tan=22.15' Δ=53°26'07" CH=39.56' CB=N71°24'19"W
E Δ = 53°07'38" R = 25.00' T = 12.50' L = 23.18' C = 22.36' CB = N60°15'48"E	R Δ = 22°39'54" R = 190.00' T = 38.08' L = 75.16' C = 74.67' CB = N38°07'23"E	EE R=44.00' L=61.06' Tan=36.60' Δ=79°30'36" CH=56.28' CB=N75°53'54"E	QQ R=66.00' L=54.12' Tan=28.69' Δ=46°58'57" CH=52.62' CB=S65°31'31"E	1B R=30.00' L=23.08' Tan=12.14' Δ=44°04'16" CH=22.51' CB=N70°12'06"E	1M R=45.00' L=69.78' Tan=44.11' Δ=88°51'05" CH=63.00' CB=N43°26'32"W
F Δ = 14°39'14" R = 200.00' T = 25.72' L = 51.15' C = 51.01' CB = N16°05'46"E	S Δ = 13°19'02" R = 190.00' T = 22.18' L = 44.16' C = 44.06' CB = N56°06'51"E	FF R=111.00' L=37.75' Tan=19.06' Δ=19°29'03" CH=37.57' CB=N11°59'35"E	RR R=211.00' L=40.81' Tan=20.47' Δ=11°04'56" CH=10.75' CB=S11°32'55"E	1C R=20.00' L=15.71' Tan=8.28' Δ=45°00'00" CH=15.31' CB=S69°44'13"W	1N R=27.50' L=21.74' Tan=11.47' Δ=45°17'23" CH=21.18' CB=N46°43'06"E
G Δ = 26°29'29" R = 55.00' T = 12.95' L = 25.43' C = 25.20' CB = N76°45'16"W	T Δ = 13°46'24" R = 190.00' T = 22.95' L = 45.67' C = 45.56' CB = N69°39'34"E	GG R=89.00' L=62.53' Tan=32.62' Δ=40°15'29" CH=61.26' CB=S22°22'47"W	SS R=111.00' L=8.59' Tan=4.30' Δ=4°26'03" CH=8.59' CB=N88°45'59"E	1D R=27.50' L=82.44' Tan=381.87' Δ=171°45'43" CH=54.86' CB=S64°26'30"W	1O R=27.50' L=21.84' Tan=11.54' Δ=45°30'46" CH=21.27' CB=N01°19'02"E
H Δ = 8°47'02" R = 111.00' T = 8.53' L = 17.02' C = 17.00' CB = S82°26'06"W	U Δ = 29°37'44" R = 66.00' T = 17.46' L = 34.13' C = 33.75' CB = N46°02'39"W	HH R=311.00' L=42.19' Tan=21.13' Δ=7°46'24" CH=42.16' CB=N62°51'00"E	TT R=105.00' L=20.00' Tan=10.03' Δ=10°54'51" CH=19.97' CB=N53°52'53"W	1E R=25.00' L=30.77' Tan=17.68' Δ=70°31'44" CH=28.87' CB=N64°56'30"W	1P R=27.50' L=38.86' Tan=23.47' Δ=80°57'37" CH=35.70' CB=S70°09'25"E
I Δ = 0°51'42" R = 589.00' T = 4.43' L = 8.86' C = 8.86' CB = N78°28'26"E	V Δ = 90°00'00" R = 25.00' T = 25.00' L = 39.27' C = 35.36' CB = S48°54'17"W	II R=44.00' L=71.36' Tan=46.30' Δ=92°55'21" CH=63.79' CB=S42°33'20"E	UU R=105.00' L=54.39' Tan=27.82' Δ=29°40'41" CH=53.78' CB=N74°10'39"W	1F R=45.00' L=8.79' Tan=4.41' Δ=11°11'22" CH=8.77' CB=S85°23'19"W	1Q R=30.00' L=35.29' Tan=20.01' Δ=67°23'58" CH=33.29' CB=S57°09'58"W
J Δ = 2°48'19" R = 589.00' T = 14.42' L = 28.84' C = 28.84' CB = N85°25'27"E	W Δ = 111°07'22" R = 44.00' T = 64.17' L = 85.34' C = 72.58' CB = S76°02'37"W	JJ R=89.00' L=19.30' Tan=9.69' Δ=12°25'38" CH=19.27' CB=N84°46'11"E	VV R=111.00' L=26.42' Tan=13.27' Δ=13°38'20" CH=26.36' CB=N79°43'47"E	1G R=25.00' L=39.27' Tan=25.00' Δ=90°00'00" CH=35.36' CB=S45°59'00"W	1R R=30.00' L=36.13' Tan=20.62' Δ=69°00'17" CH=33.99' CB=S57°58'07"W
K Δ = 97°04'40" R = 44.00' T = 49.80' L = 74.55' C = 65.95' CB = S44°38'03"E	X Δ = 110°53'45" R = 44.00' T = 63.90' L = 85.16' C = 72.48' CB = N79°51'52"E	KK R=111.00' L=35.01' Tan=17.65' Δ=18°04'23" CH=34.87' CB=S81°56'49"W	WW R=25.00' L=34.59' Tan=20.71' Δ=79°15'49" CH=31.89' CB=N22°32'32"E	1H R=105.00' L=90.54' Tan=48.30' Δ=49°24'27" CH=87.76' CB=N23°43'14"W	
L Δ = 88°45'25" R = 66.00' T = 64.58' L = 102.24' C = 92.32' CB = N48°47'41"W	Y Δ = 43°03'41" R = 25.00' T = 9.86' L = 18.79' C = 18.35' CB = S66°13'06"E	LL R=66.00' L=73.16' Tan=40.85' Δ=63°30'38" CH=69.47' CB=N57°15'41"W			
M Δ = 08°19'15" R = 66.00' T = 4.80' L = 9.59' C = 9.58' CB = N00°15'21"W	Z Δ = 71°46'07" R = 25.00' T = 18.09' L = 31.31' C = 29.31' CB = S56°22'00"W				

**OWNERSHIP PERCENTAGES**

UNIT NO.	SQ. FT.	ELEV. F.F.	% OWNERSHIP	UNIT NO.	SQ. FT.	ELEV. F.F.	% OWNERSHIP
1	1661.92	756.59	0.9495	77	1736.17	756.16	0.9919
2	1602.38	756.59	0.9155	78	1520.92	757.05	0.8689
3	1191.64	755.86	0.6808	79	1520.92	754.21	0.8689
4	1214.22	755.86	0.6937	80	1520.92	756.02	0.8689
5	1602.38	757.42	0.9155	81	1520.92	756.87	0.8689
6	1661.92	757.42	0.9495	82	1207.46	754.46	0.6898
7	1658.47	756.00	0.9475	83	1207.46	754.66	0.6898
8	1661.92	756.00	0.9495	84	1520.92	754.94	0.8689
9	1196.28	756.42	0.6835	85	1317.98	755.96	0.7530
10	1213.70	756.42	0.6934	86	2064.94	755.96	1.1797
11	1196.28	756.76	0.6835	87	1730.49	755.63	0.9887
12	1213.70	756.76	0.6934	88	1388.87	754.91	0.7935
13	1599.80	754.87	0.9140	89	1940.62	755.37	1.1087
14	1393.43	756.44	0.7961	90	2053.62	755.37	1.1733
15	1713.47	756.37	0.9789	91	1207.46	754.86	0.6898
16	1733.47	756.37	0.9904	92	1520.92	756.77	0.8689
17	1658.47	757.40	0.9475	93	1942.62	755.42	1.1098
18	1661.92	757.41	0.9495	94	1936.39	755.42	1.1063
19	1196.28	755.58	0.6835	95	1730.49	755.40	0.9887
20	1393.43	757.01	0.7961	96	1207.46	756.65	0.6898
21	1393.43	757.56	0.7961	97	2072.42	758.91	1.1840
22	1393.43	754.55	0.7961	98	1940.62	758.91	1.1087
23	1196.28	754.53	0.6835	99	1332.09	754.42	0.7610
24	1213.70	754.54	0.6934	100	1600.25	756.80	0.9142
25	1658.47	758.13	0.9475	101	1520.92	756.44	0.8689
26	1661.92	758.13	0.9495	102	1520.92	756.80	0.8689
27	1393.43	755.19	0.7961	103	1207.46	755.72	0.6898
28	1393.43	754.43	0.7961	104	1207.46	755.45	0.6898
29	1393.43	757.07	0.7961	105	1388.87	756.52	0.7935
30	1196.28	756.16	0.6835	106	1207.46	755.59	0.6898
31	1196.28	755.32	0.6835	107	1388.87	757.82	0.7935
32	1393.43	756.45	0.7961	108	1520.92	757.07	0.8689
33	1393.43	756.64	0.7961	109	1207.46	757.07	0.6898
34	1213.70	753.83	0.6934	110	1318.11	755.25	0.7531
35	1393.43	753.61	0.7961	111	1940.84	755.25	1.1088
36	1393.43	754.43	0.7961	112	1207.46	757.32	0.6898
37	1717.06	754.06	0.9810	113	1207.46	757.05	0.6898
38	1717.06	754.20	0.9810	114	1646.39	756.68	0.9406
39	1717.06	755.50	0.9810	115	1646.39	756.68	0.9406
40	1661.92	756.29	0.9495	116	1672.01	754.70	0.9552
41	1658.47	756.29	0.9475				
42	1717.06	755.93	0.9810				
43	1393.43	754.62	0.7961				
44	1717.06	754.78	0.9810				
45	1717.06	755.45	0.9810				
46	1253.34	754.10	0.7161				
47	1705.23	756.45	0.9742				
48	1573.19	755.60	0.8988				
49	1705.23	755.96	0.9742				
50	1705.23	755.61	0.9742				
51	1417.96	753.78	0.8101				
52	1928.15	756.29	1.1016				
53	1928.15	755.93	1.1016				
54	1207.46	754.58	0.6898				
55	1207.46	754.58	0.6898				
56	1393.43	754.54	0.7961				
57	1393.43	756.42	0.7961				
58	1207.46	754.62	0.6898				
59	1717.06	755.09	0.9810				
60	1207.46	753.81	0.6898				
61	1389.04	755.51	0.7936				
62	1207.46	753.98	0.6898				
63	1335.42	754.88	0.7629				
64	1717.06	755.31	0.9810				
65	1520.92	755.63	0.8689				
66	1600.25	755.95	0.9142				
67	1520.92	755.20	0.8689				
68	2053.62	755.47	1.1733				
69	1317.98	755.47	0.7530				
70	1717.06	752.12	0.9810				
71	1520.92	754.64	0.8689				
72	1600.25	756.07	0.9142				
73	1335.42	755.62	0.7629				
74	1520.92	755.40	0.8689				
75	1736.17	756.82	0.9919				
76	1520.92	756.89	0.8689				
<b>TOTAL</b>				<b>175,035.26</b>	<b>100.00%</b>		

**LINE DATA**

L1 N 00°59'00" E  
5.01'

DATE	DESCRIPTION	BY
08-08-05	ORIGINAL ISSUE	BAP



KS ASSOCIATES, INC.  
260 Burns Road, Suite 100  
Elyria, Ohio 44035  
Phone (440) 365-4730  
Fax (440) 365-4790  
mailroom@ksassoc.com  
www.ksassoc.com

**STONEHEDGE CONDOMINIUMS  
PHASE NO. 24**

PART OF  
CARLISLE TOWNSHIP SECTION NO. 5  
CITY OF ELYRIA COUNTY OF LORAIN STATE OF OHIO

SHEET  
**3** OF  
**5**  
JOB NO.  
**92424-CP24**



