


POINT #L618

LONG.	82-11-58.32383" W
LAT.	41-27-38.81795" N
ELEV.	597.667
NORTH	653,789.17
EAST	2,050,855.06

11-21-06

#L618

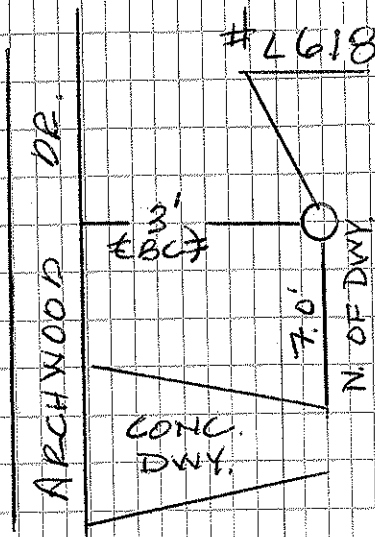

903
RES.