


POINT # L705

LONG. 82-08-28.06448 W
LAT. 41-26-15.93307 N
ELEV. 641.188
EAST 2066,897.89
NORTH 645,460.79

L705

NOTE: (SEE PRECEDING
PG. FOR # L706)

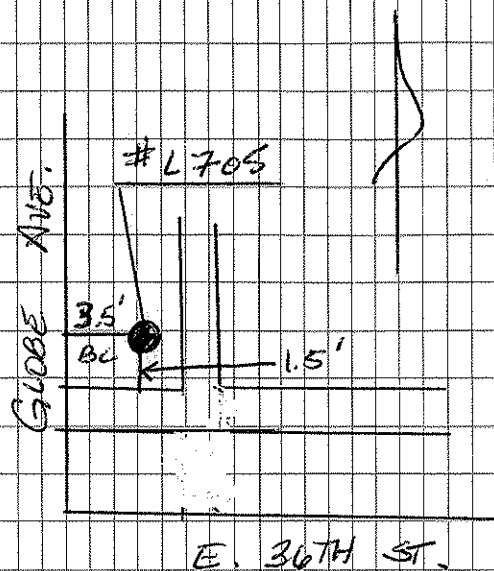

E. 36TH ST.