



L815

E. ST. & AUGUSTA

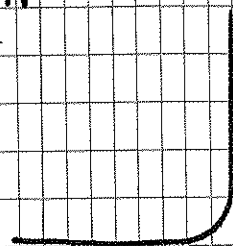

E. STREET

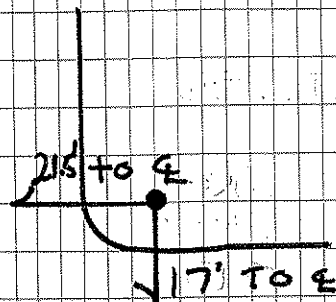

AUGUSTA