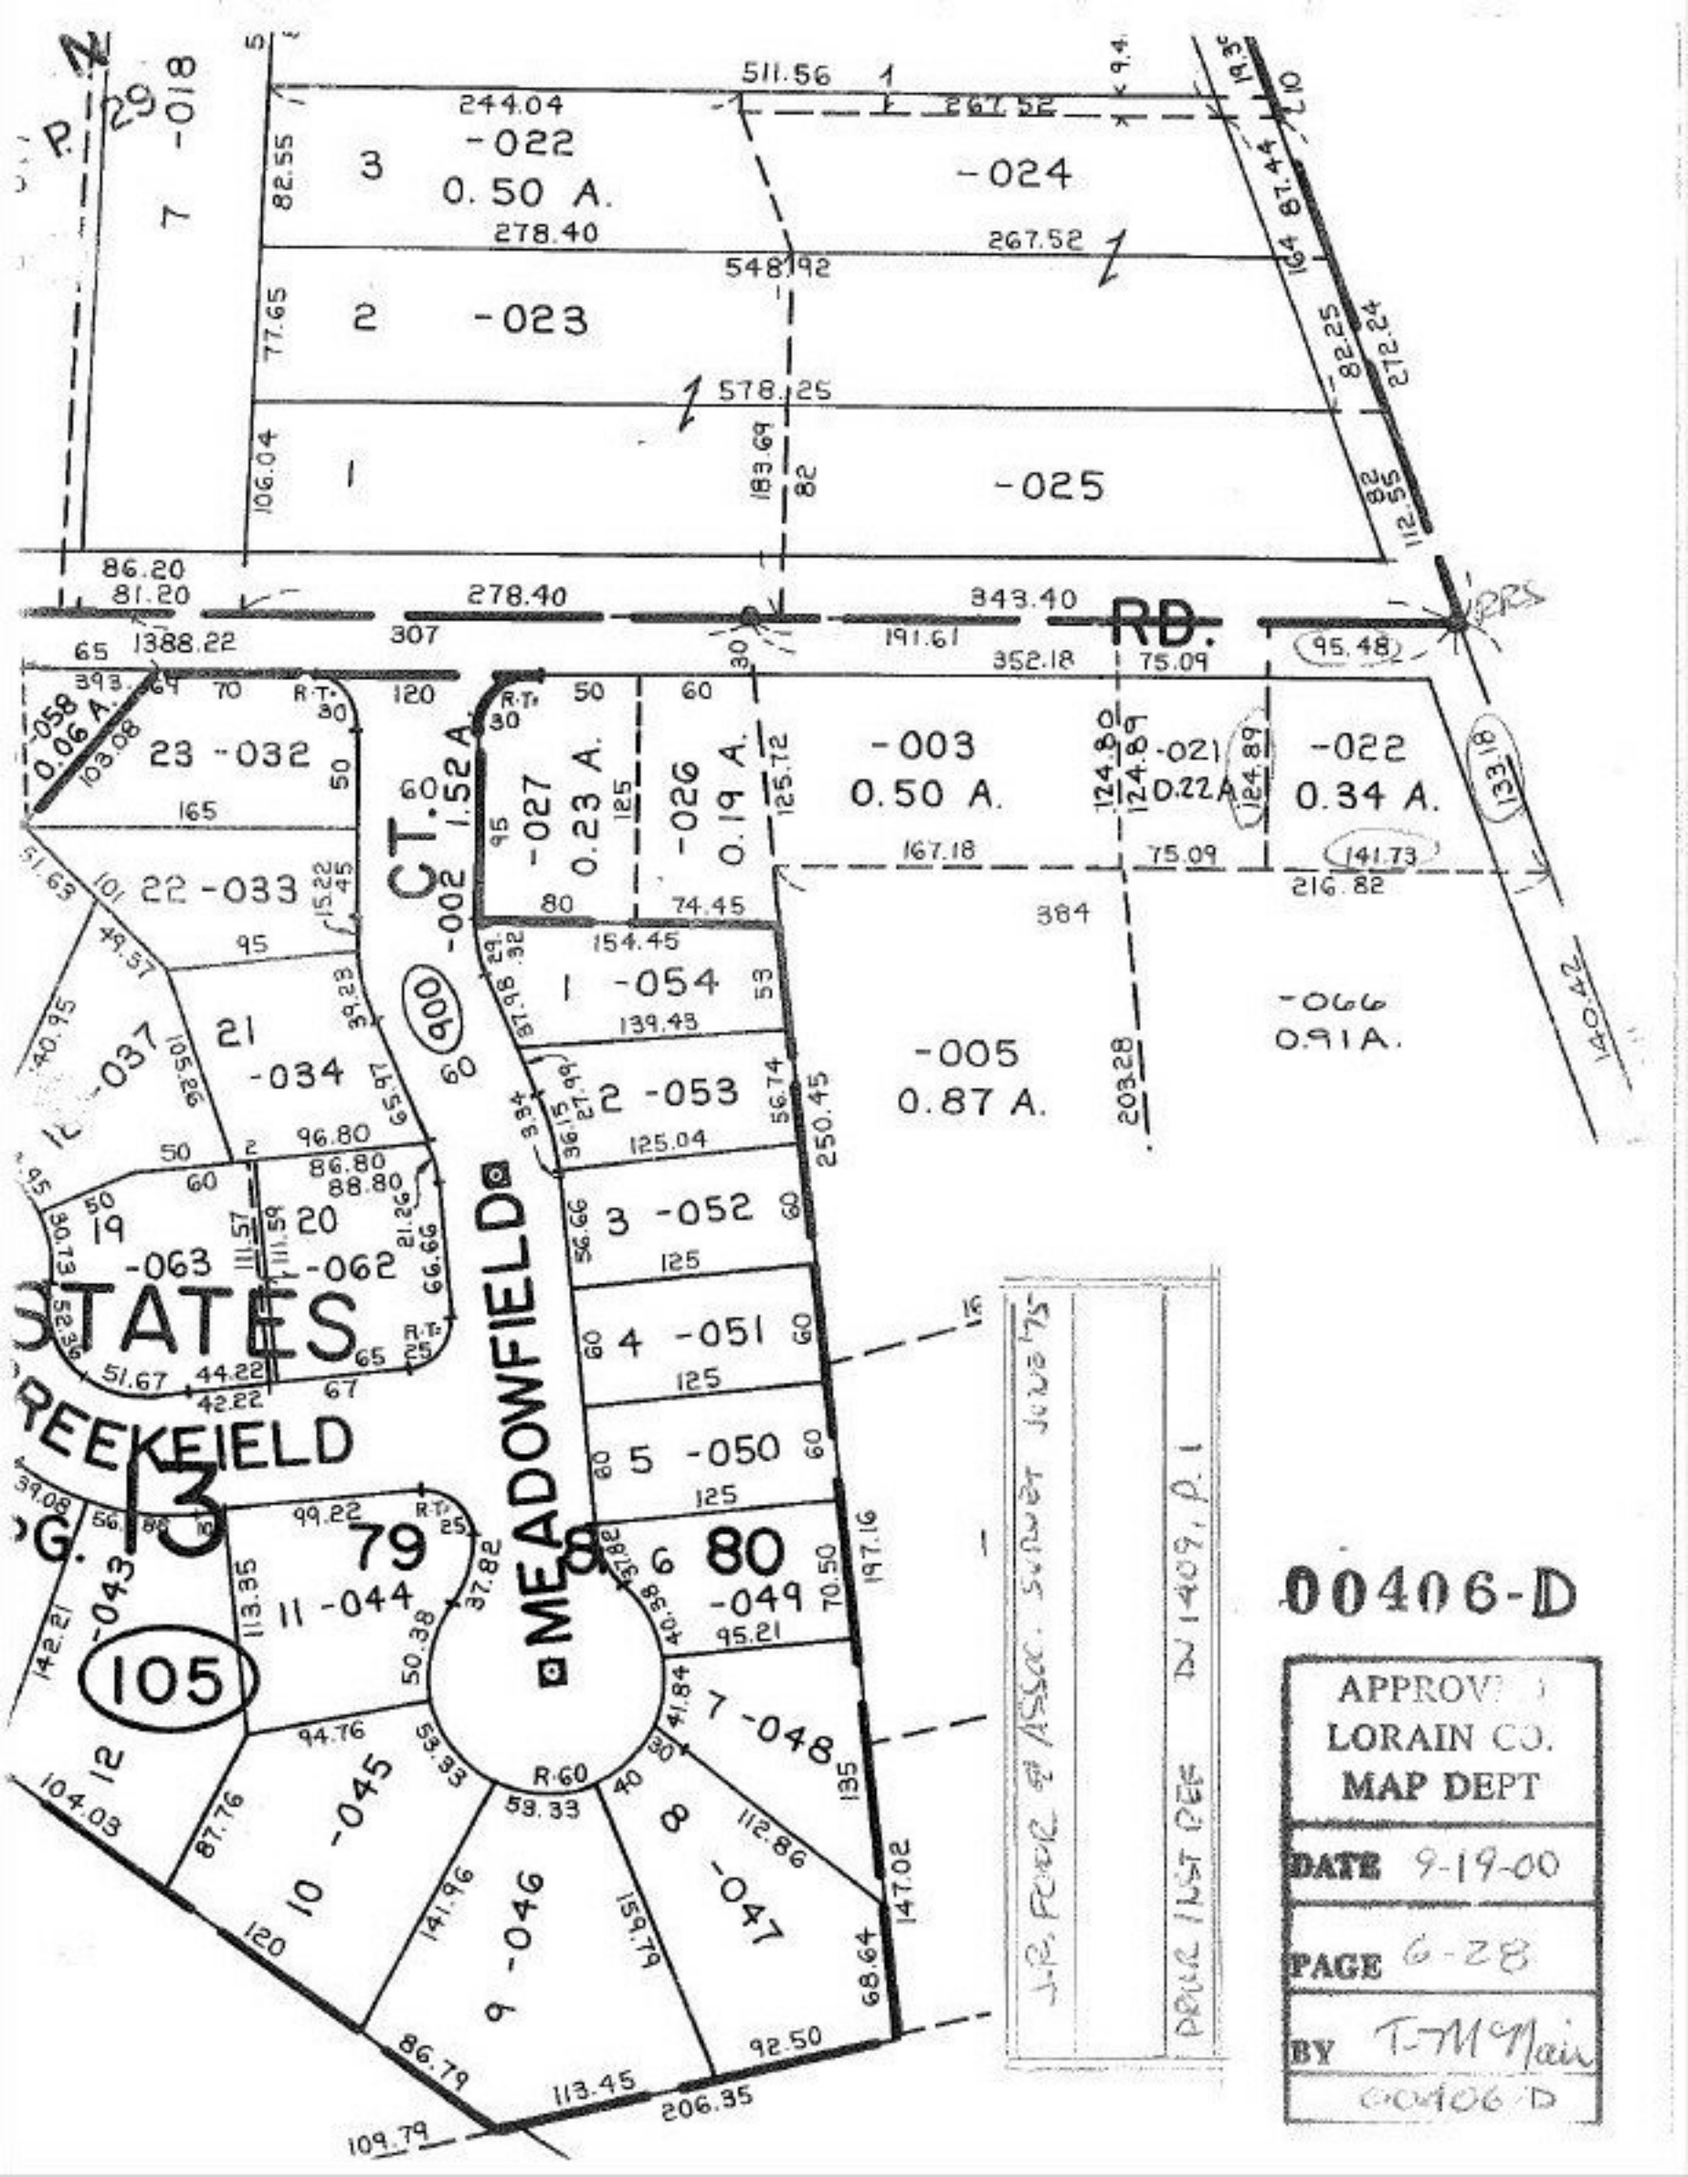

P. 29
7 -018
3 -022 0.50 A.
-024
2 -023
1 -025
RD.
23 -032
22 -033
21 -034
-037
19 -063
20 -062
-027 0.23 A.
-026 0.19 A.
-003 0.50 A.
-021 0.22 A.
-022 0.34 A.
-005 0.87 A.
-066 0.91 A.
CT.
900
MEADOWFIELD
STATES
REEKFIELD
13
79
11 -044
105
12
10 -045
9 -046
8 -047
7 -048
6 80 -049
5 -050
4 -051
3 -052
2 -053
1 -054
J.R. FOOR & ASSOC. SURVEY JUNE '75
DRUR INST REF DN 1409, P. 1
00406-D
APPROVED
LORAIN CO.
MAP DEPT
DATE 9-19-00
PAGE 6-28
BY T. McNair
00406-D