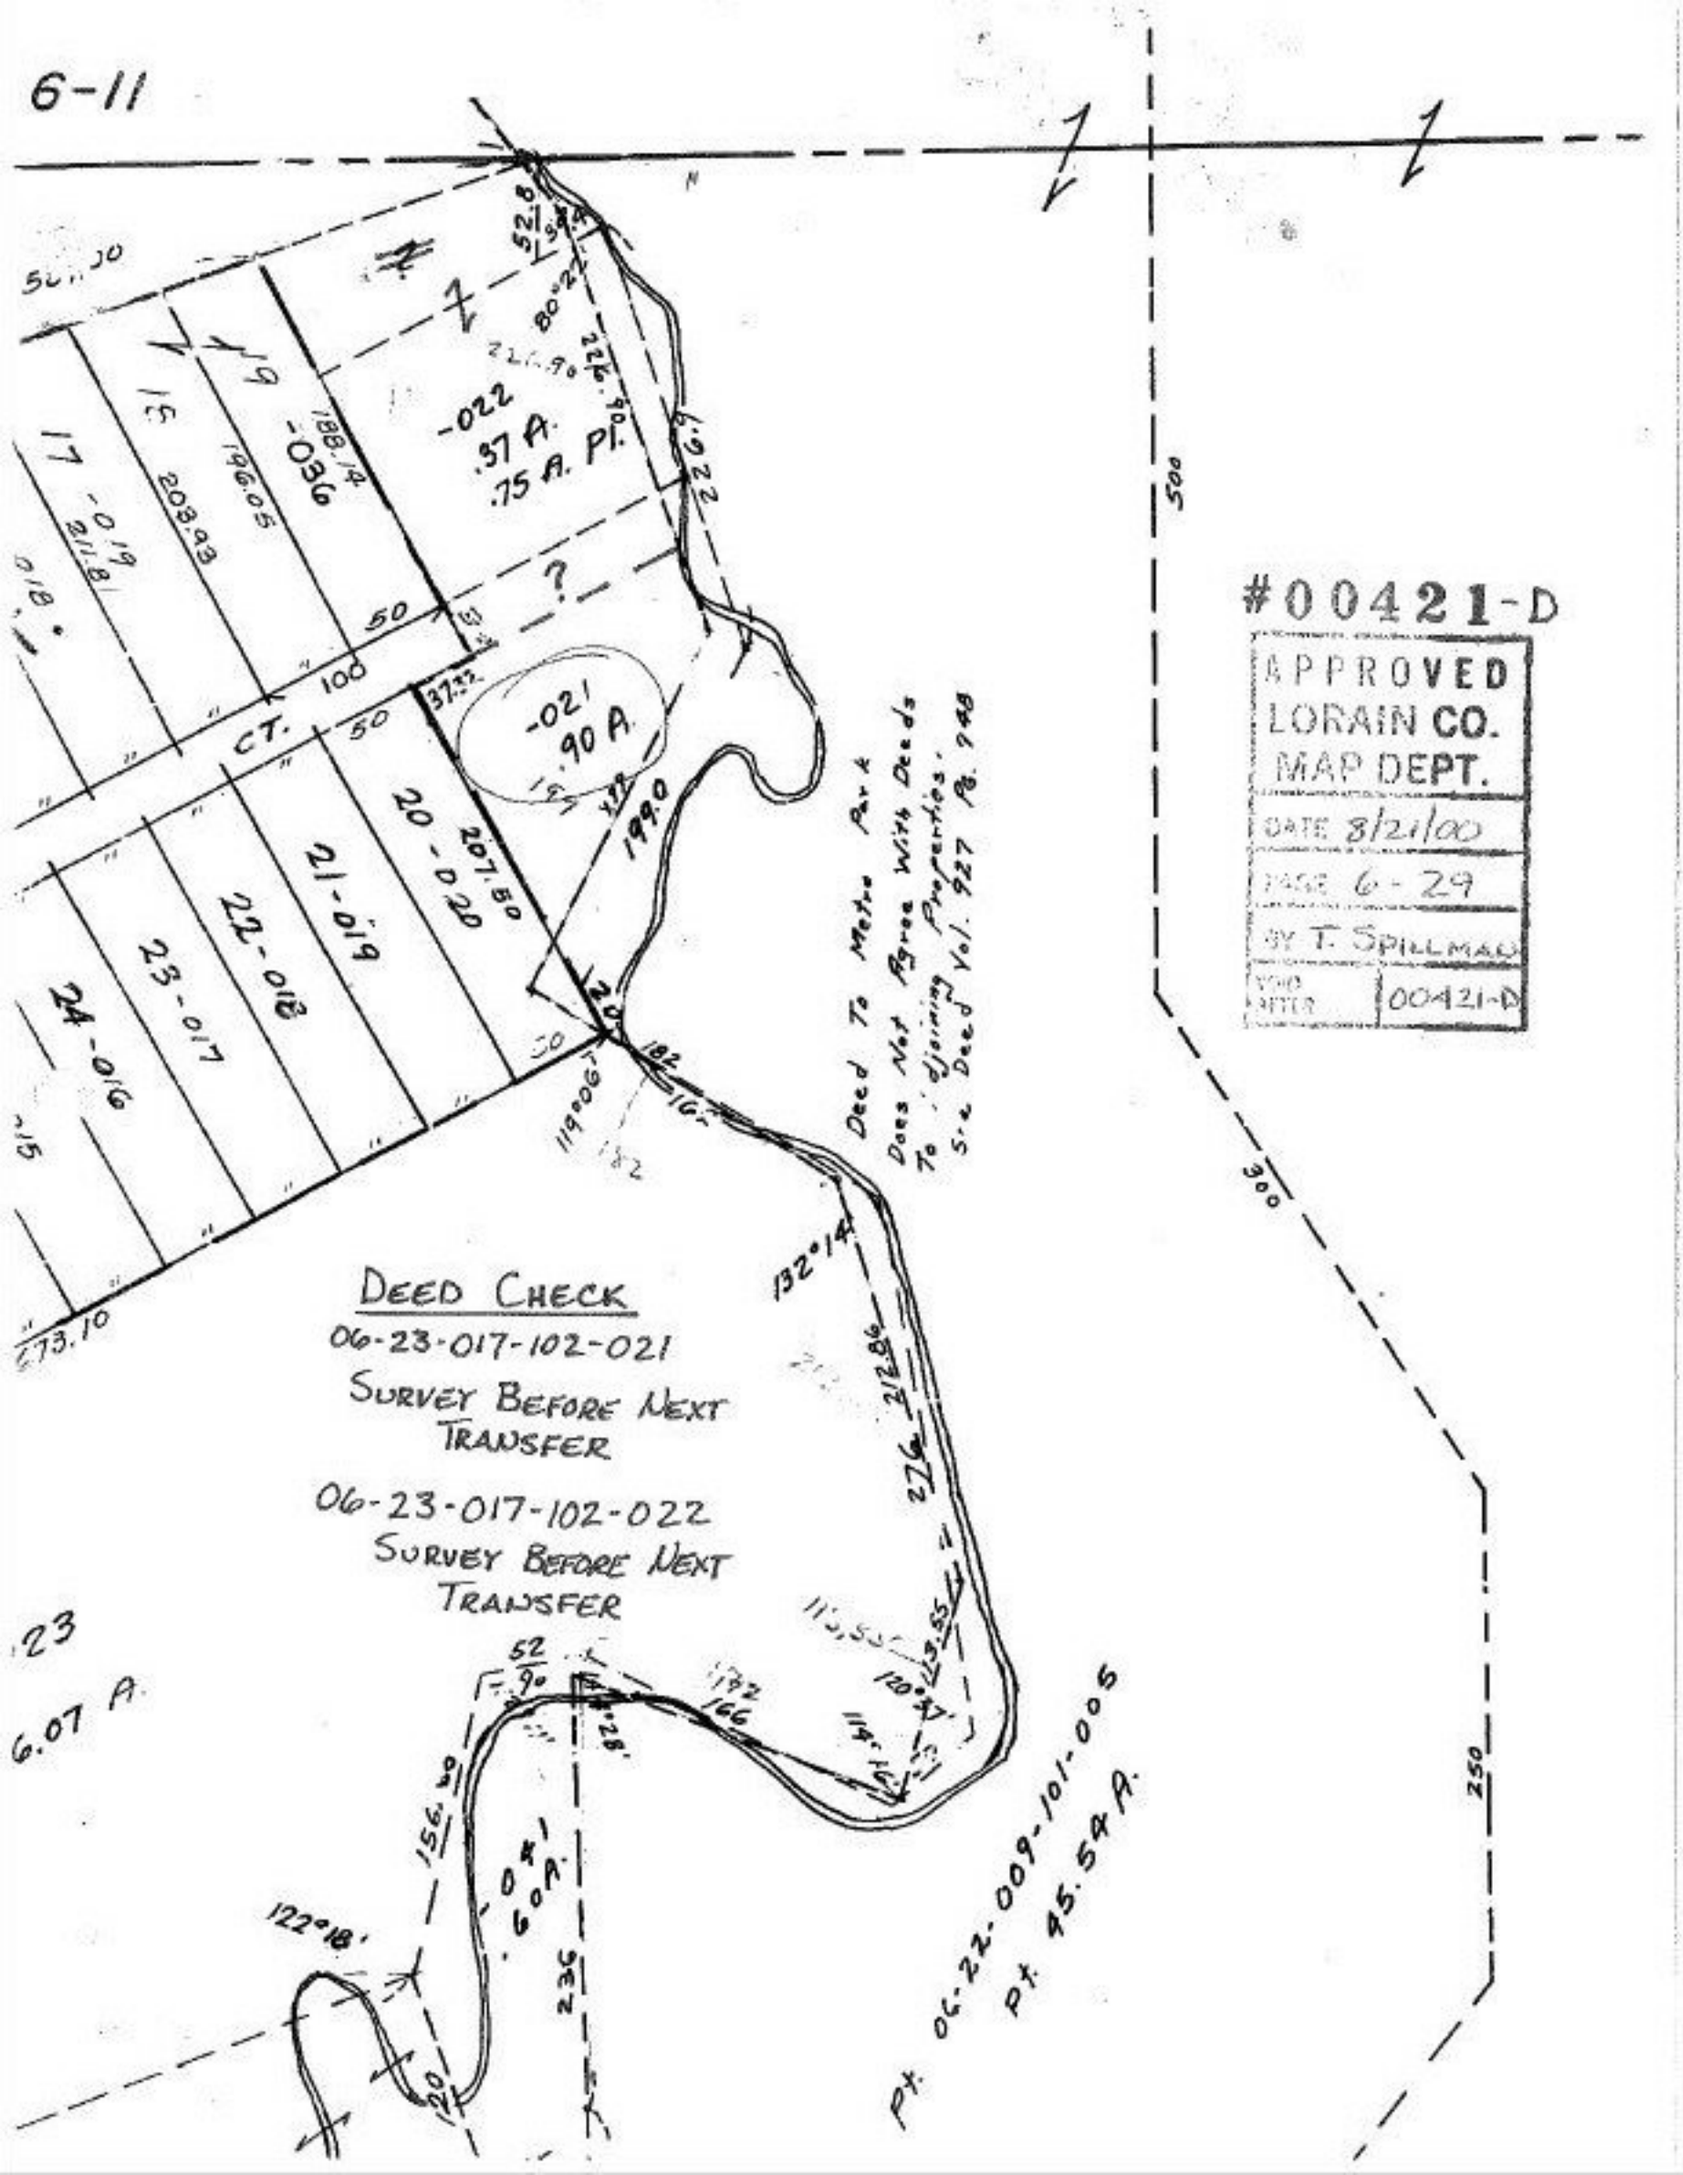
6-11
#00421-D
APPROVED
LORAIN CO.
MAP DEPT.
DATE 8/21/00
PAGE 6-29
BY T. SPILLMAN
VOID AFTER 00421-D
DEED CHECK
06-23-017-102-021
SURVEY BEFORE NEXT TRANSFER
06-23-017-102-022
SURVEY BEFORE NEXT TRANSFER
Deed To Metro Park
Does Not Agree With Deeds
To Adjoining Properties.
See Deed Vol. 927 Pg. 948
-022
.37 A.
.75 A. Pl.
-036
-021
.90 A.
-041
.60 A.
Pt. 06-22-009-101-005
Pt. 45.54 A.
CT.
500
300
250
236
122°18'
132°14'