PARENT PARCEL: 21-03-000-000-077P

CHILD PARCEL: XX-XX-XXX-XXX-XXX

STARTING POINT: I.P. , CL OF STEWART RD. & CL OF CLARK RD.

NO. 00445-A

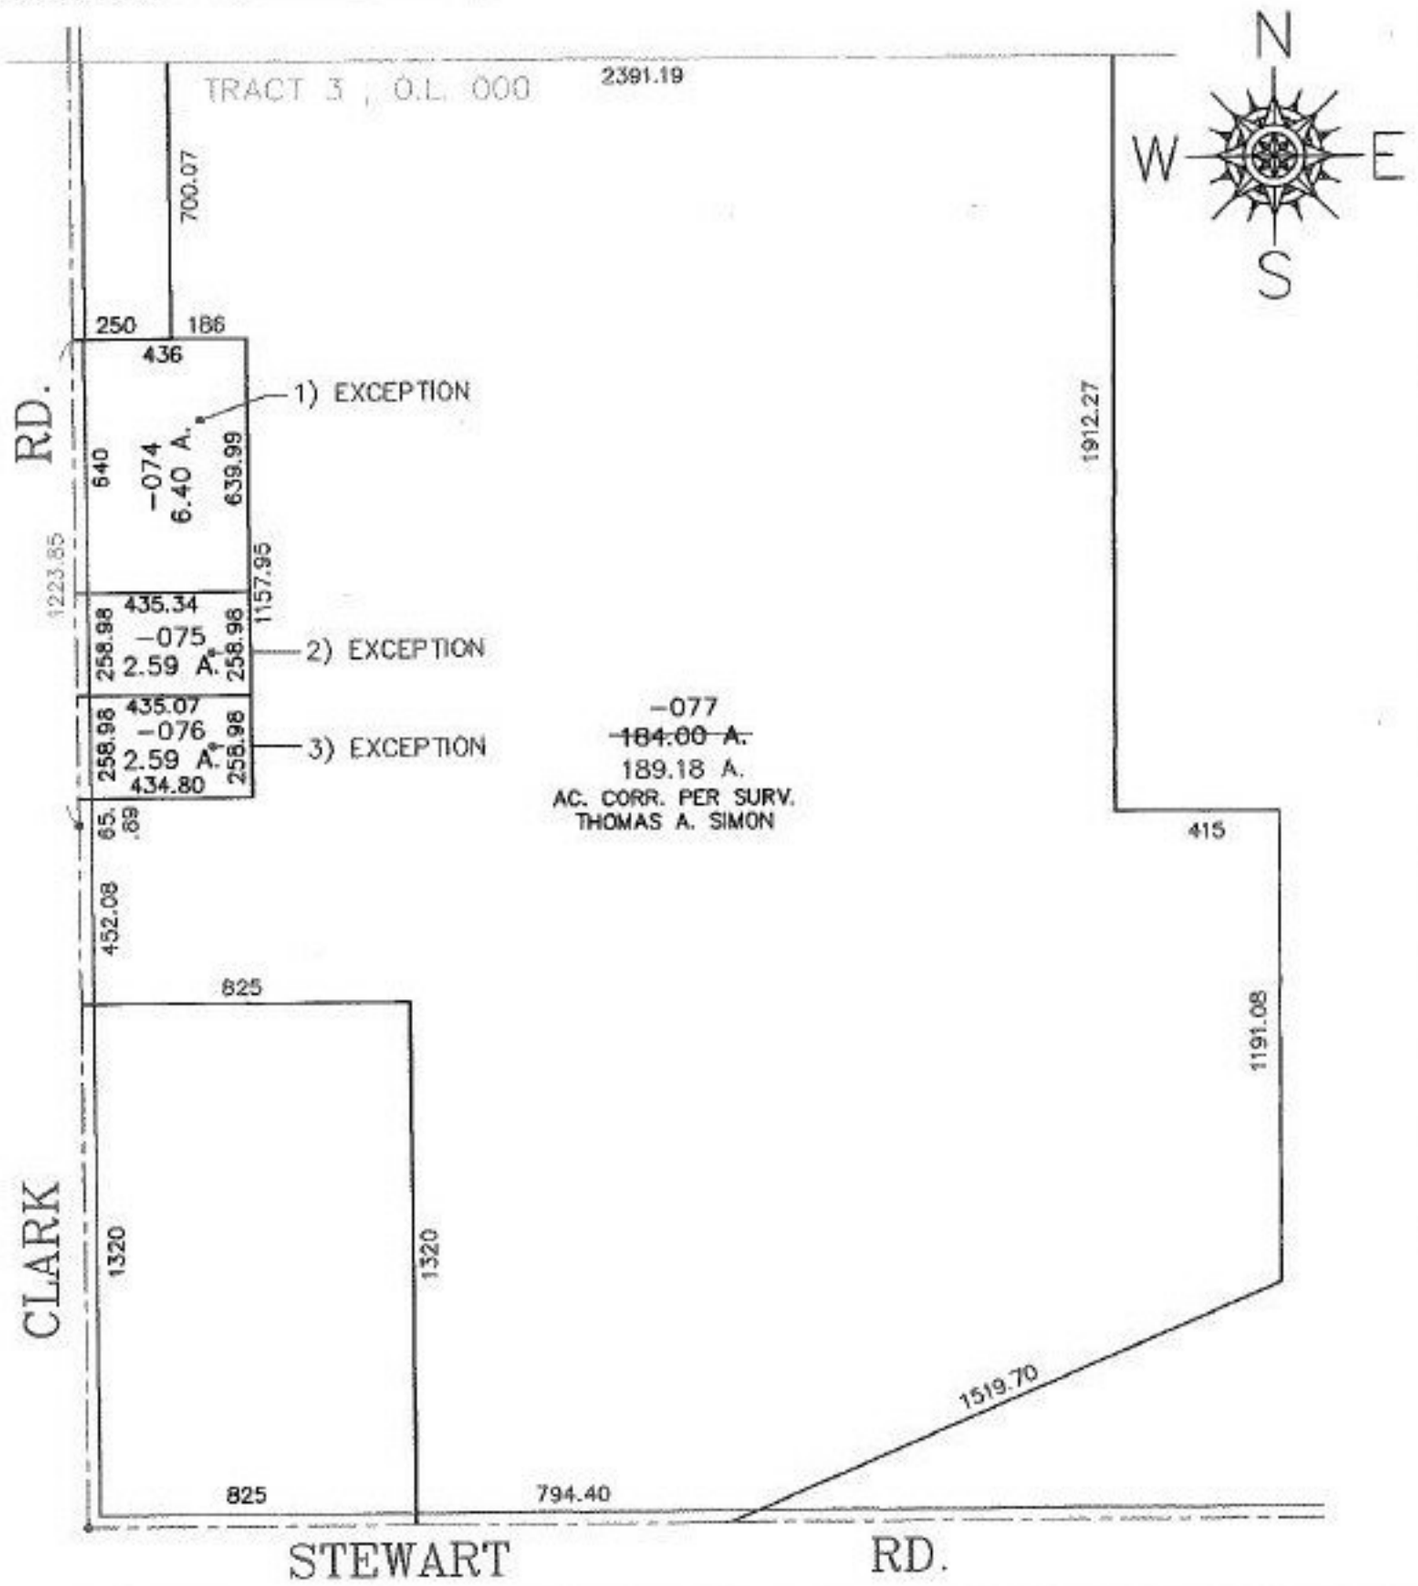

SPLITS/DEEDS PROCESSED

LORAIN COUNTY TAX MAP DEPARTMENT
226 MIDDLE AVE. ELYRIA, OHIO

SURVEYED BY: THOMAS A. SIMON

CLOSURE: 0.01 : 10,000

MAP PAGE(S): 21-F

APPROVED BY: TJS DATE: 10/12/00

SCALE: 1" = 500 PRIOR INSTRUMENT: 9700473894