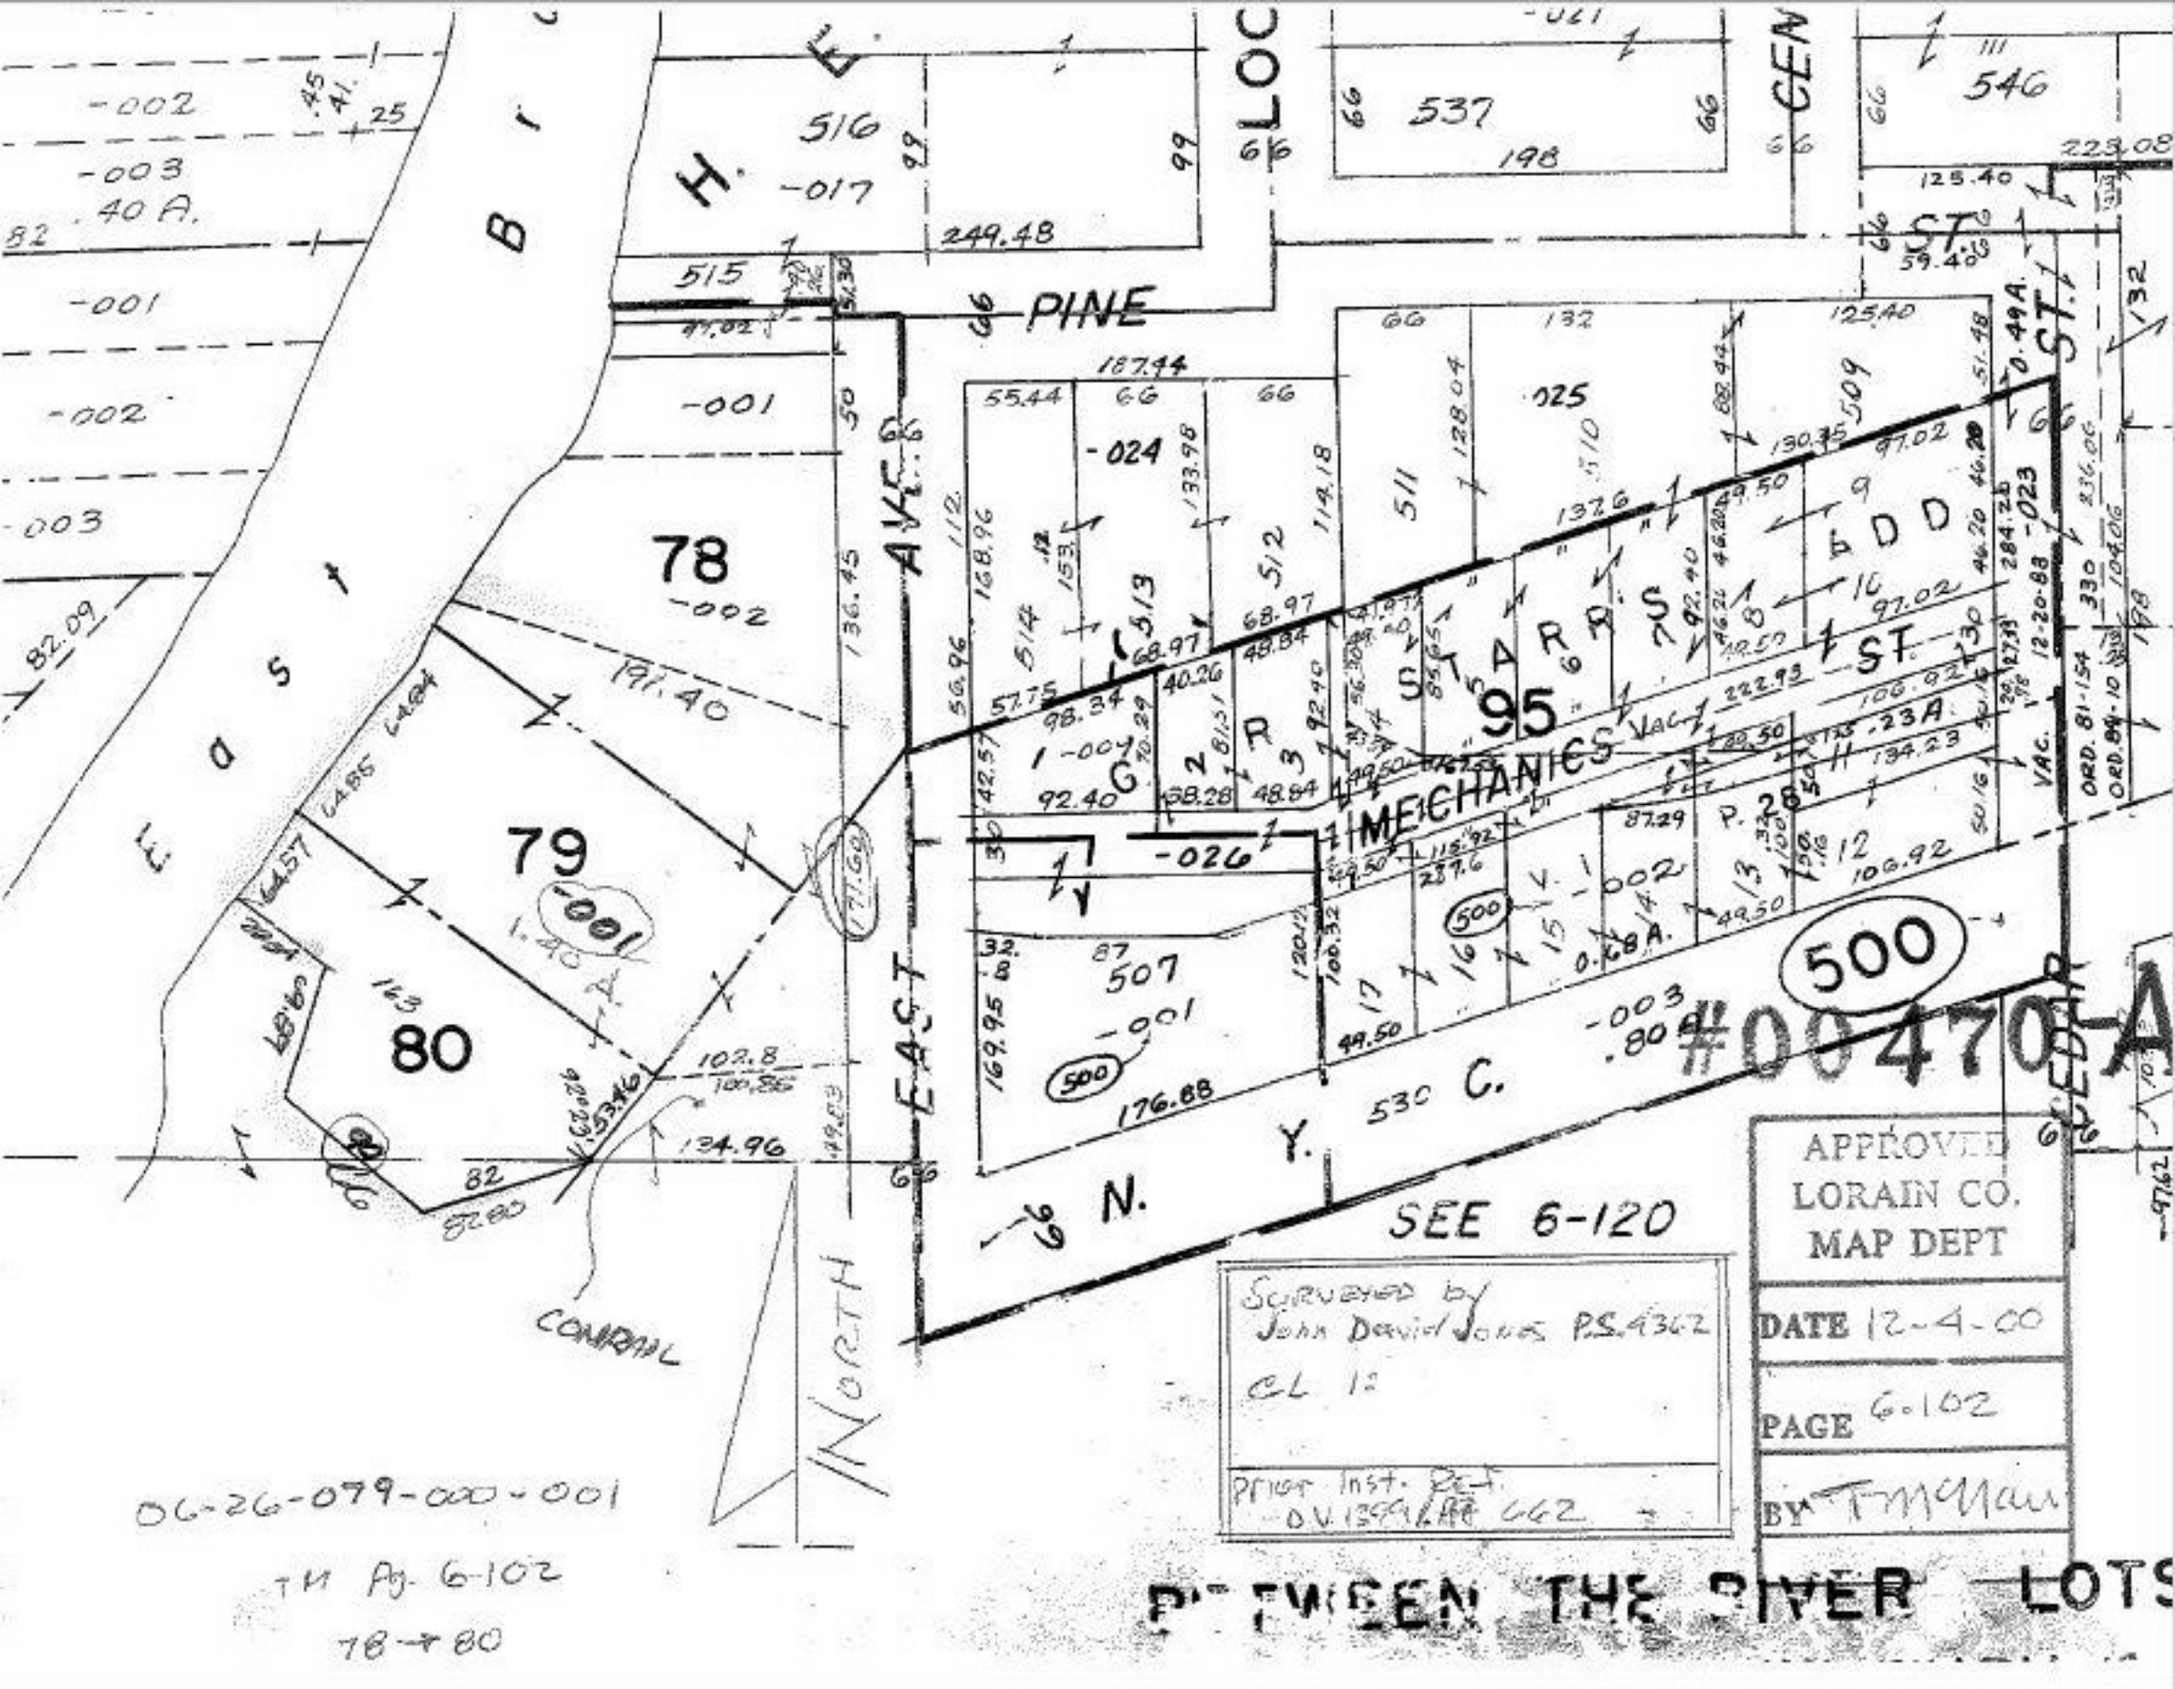

East Br
H. E.
LOC
CEN
PINE
ST.
EAST AVE.
MECHANICS
STARRS ADD
95
78
79
80
500
#00470-A
SEE 6-120
CONRAIL
NORTH
APPROVED
LORAIN CO.
MAP DEPT
DATE 12-4-00
PAGE 6-102
BY
Surveyed by
John David Jones P.S. 4362
CL 12
Prior Inst. Ref.
06-26-079-000-001
TM Pg. 6-102
78 → 80
BETWEEN THE RIVER LOTS