1-002 52.86 A.

REF. 20000911954

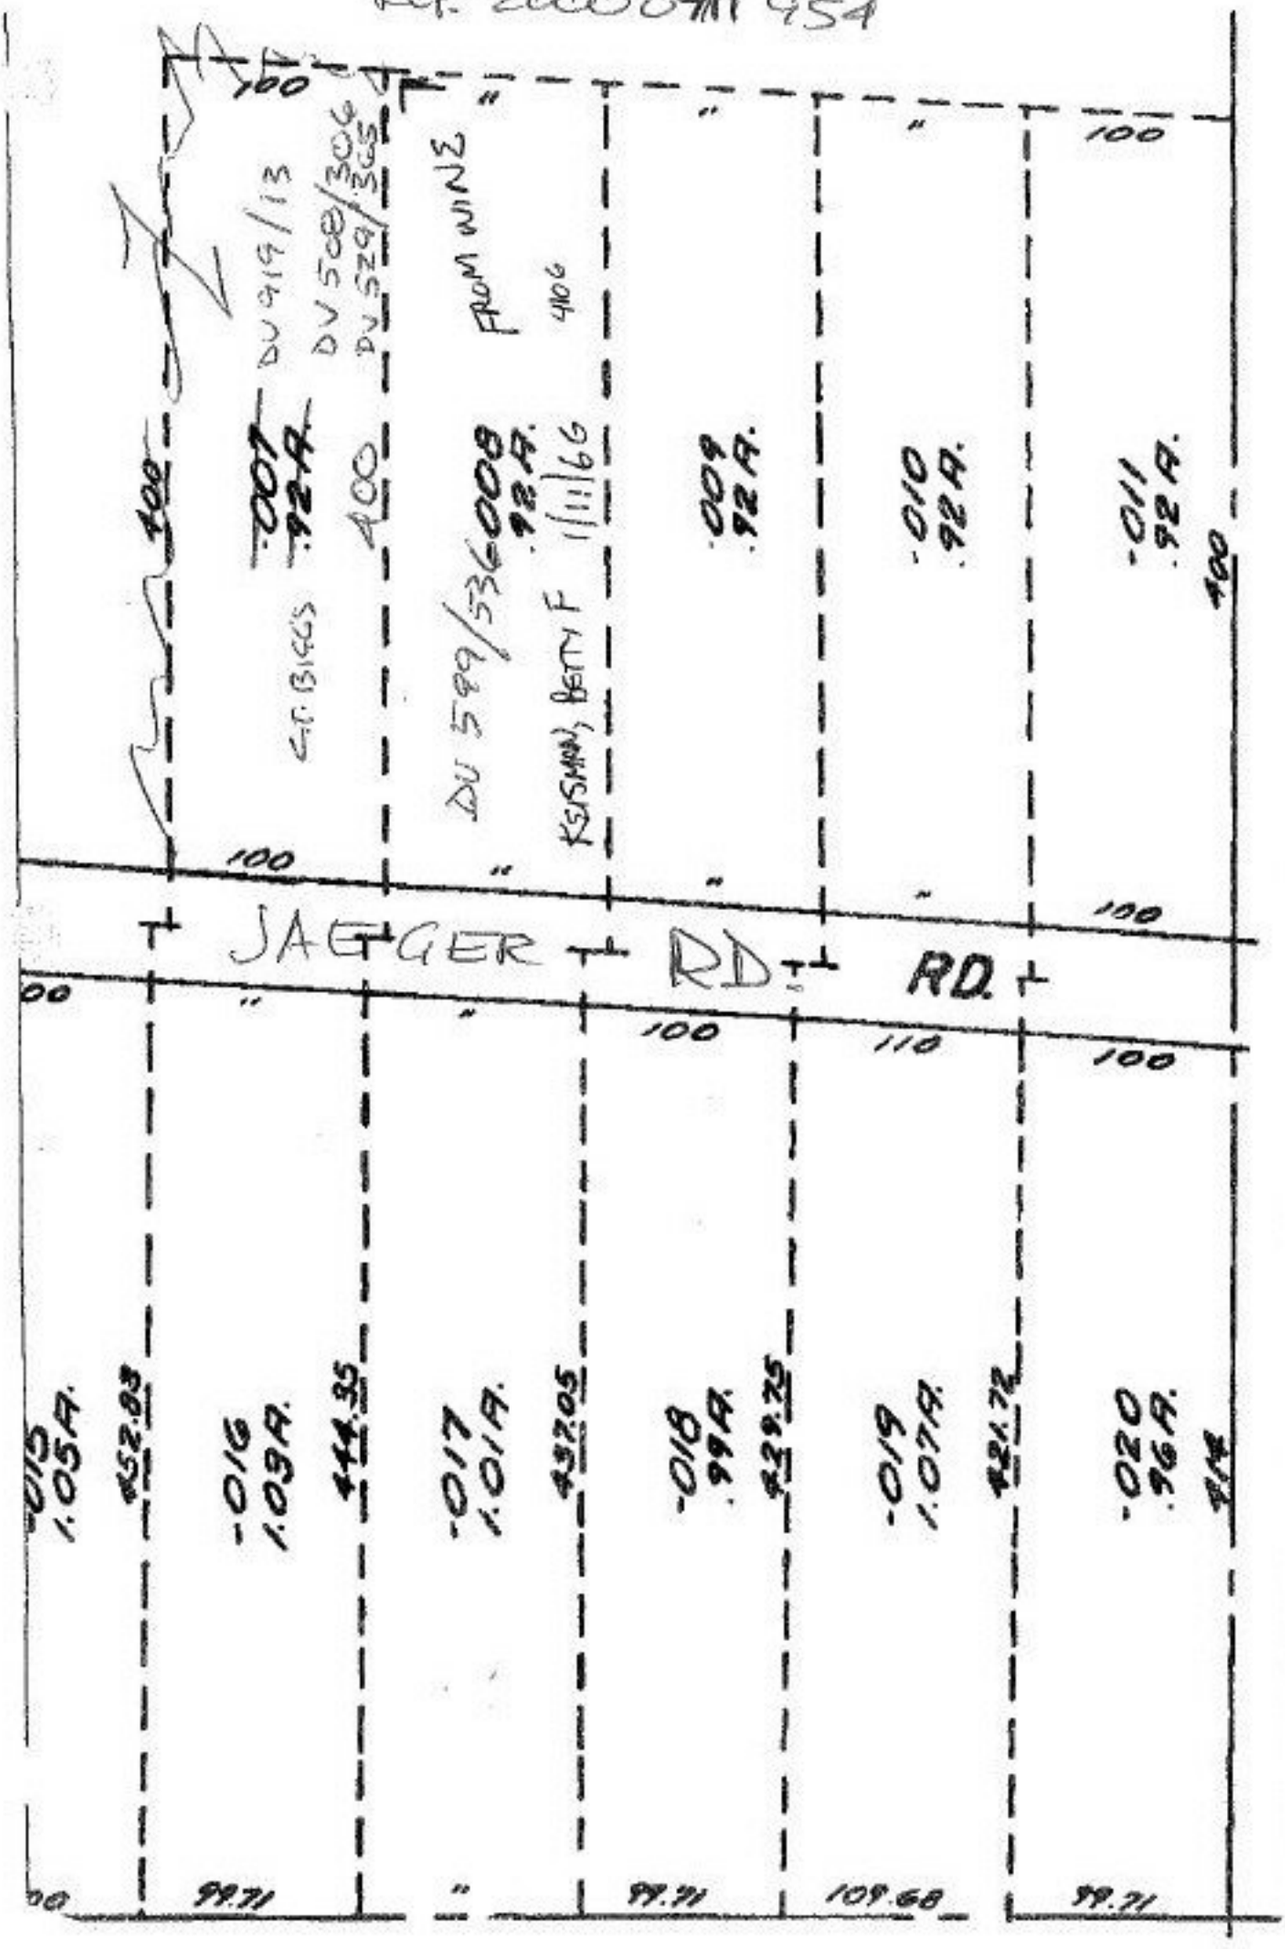

#00500-D

APPROVED
LORAIN CO.
MAP DEPT

DATE 1-24-01

PAGE 2.02.010.B

BY T. McClain

00500-D

1-001-B