RASTER

PARENT PARCEL: 06-24-027-101-041 & -043 , 06-24-035-106-014, -028, -030, -034, -040

CHILD PARCEL: XX-XX-XXX-XXX-XXX

STARTING POINT: MANY

NO. 00501-D

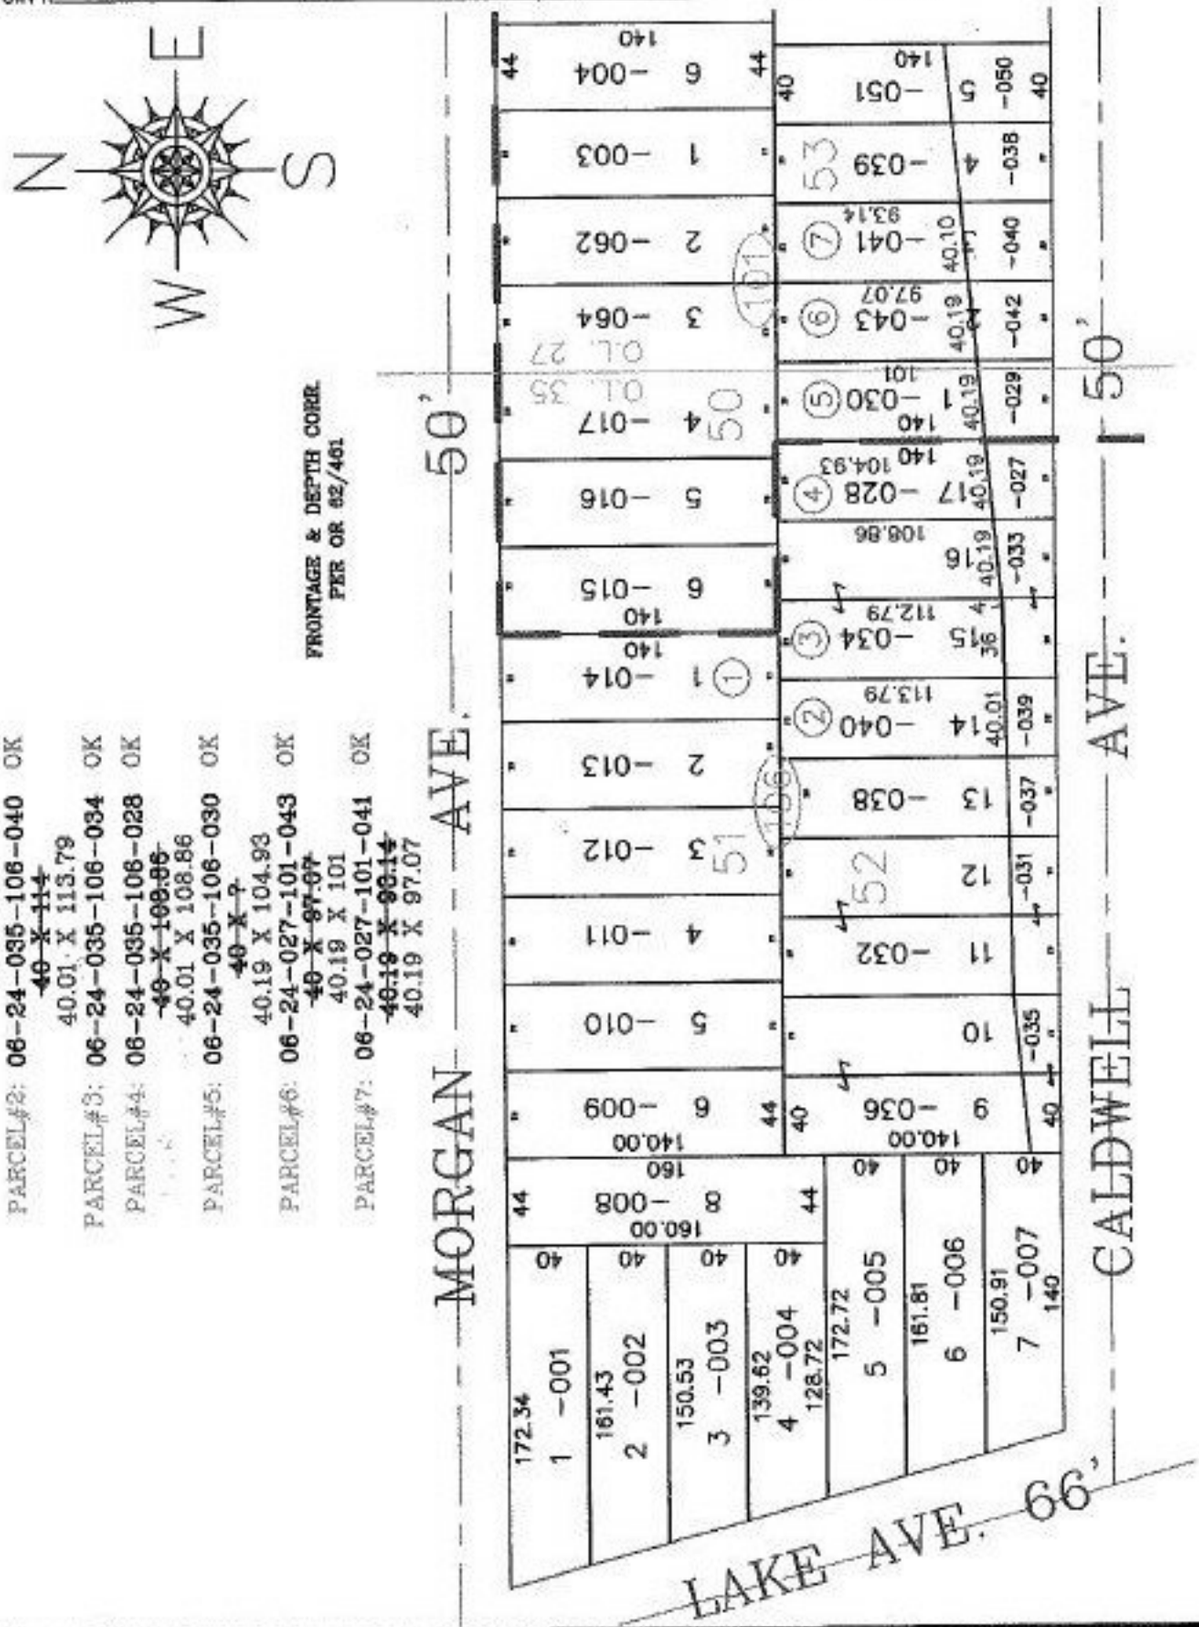

DEED CHECK

PARCEL#1: 06-24-035-106-014 OK
44 X 140

PARCEL#2: 06-24-035-106-040 OK
~~40 X 114~~
40.01 X 113.79

PARCEL#3: 06-24-035-106-034 OK

PARCEL#4: 06-24-035-106-028 OK
~~40 X 100.86~~
40.01 X 108.86

PARCEL#5: 06-24-035-106-030 OK
~~40 X ?~~
40.19 X 104.93

PARCEL#6: 06-24-027-101-043 OK
~~40 X 97.07~~
40.19 X 101

PARCEL#7: 06-24-027-101-041 OK
~~40.19 X 93.14~~
40.19 X 97.07

SPLITS/DEEDS PROCESSED

LORAIN COUNTY TAX MAP DEPARTMENT
226 MIDDLE AVE. ELYRIA, OHIO

SURVEYED BY: NONE
CLOSURE: 0.84 : 10,000
MAP PAGE(S): 6-61 & 6-62
APPROVED BY: TJS DATE: 01/15/01
SCALE: 1" = 100 PRIOR INSTRUMENT: OR 62/461