PARENT PARCEL: 07-00-047-650-001

CHILD PARCEL: ADD TO DUP. MINERAL RIGHTS

STARTING POINT: N/A

23-00004-M

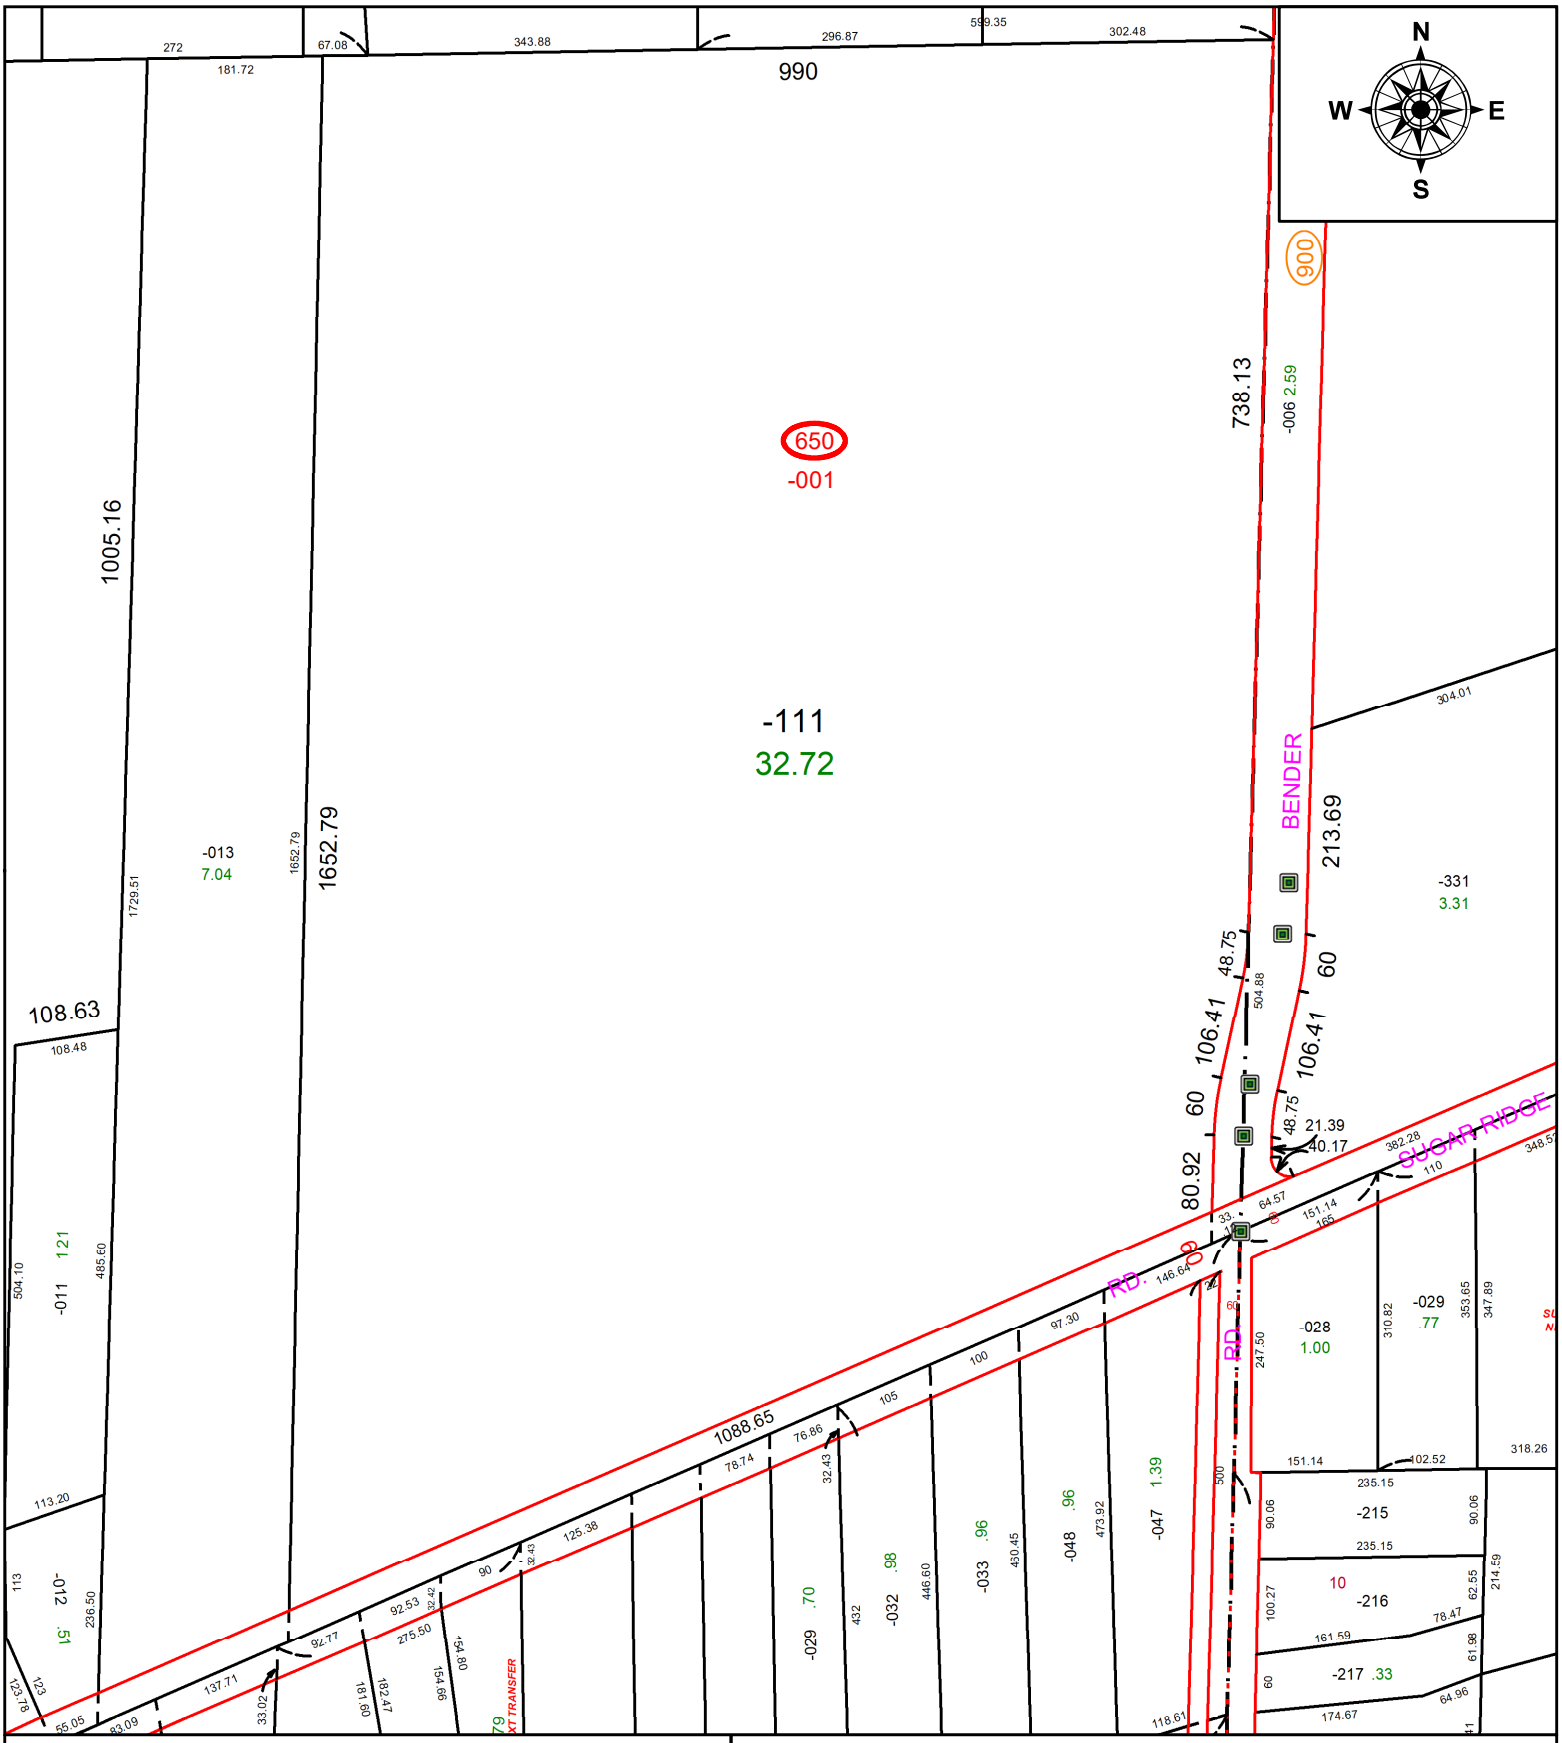

SPLITS/DEEDS PROCESSED

LORAIN COUNTY TAX MAP DEPARTMENT
226 MIDDLE AVE. ELYRIA, OH

SURVEYED BY: N/A **SURVEY #:** N/A

CLOSURE: N/A

MAP PAGE(S): 07-00-047

APPOVED BY: DMA **DATE:** 8/14/2023

SCALE: 1" = 25' **PRIOR INSTRUMENT:** 2021-0855133