PARENT PARCEL: 05-00-024-110-010 & -011

CHILD PARCEL: XX-XX-XXX-XXX-XXX

STARTING POINT: S.W. CORNER OF S\L 331

NO. 00103-X

N

W E

S

MAP & SIZE CORR.

05-00-024-110-010

~~12 X 132~~

124 X 132

05-00-024-110-011

~~12 X 132~~

13 X 132

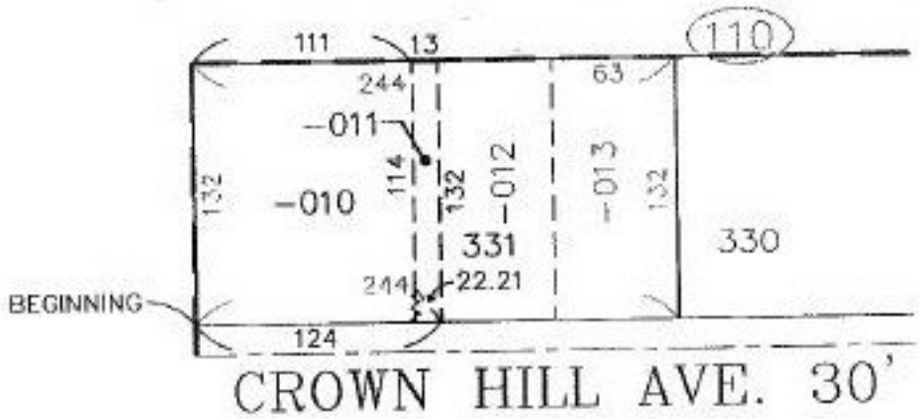

SPLITS/DEEDS PROCESSED

LORAIN COUNTY TAX MAP DEPARTMENT

226 MIDDLE AVE. ELYRIA, OHIO

SURVEYED BY: NONE

CLOSURE: CAN'T RUN

MAP PAGE(S): 05-00-024-A

APPROVED BY: T. SPILLMAN DATE: 07/22/99

SCALE: 1" = 100 PRIOR INSTRUMENT: DV 970/196