PARENT PARCEL: 19-04-011-000-006, -007, 19-04-034-000-003,
CHILD PARCEL: 19-04-011-000-041, -042, -043, -044
STARTING POINT: INT INDIAN HOLLOW ROAD AND N LINE OF O.L.9

NO. 00105

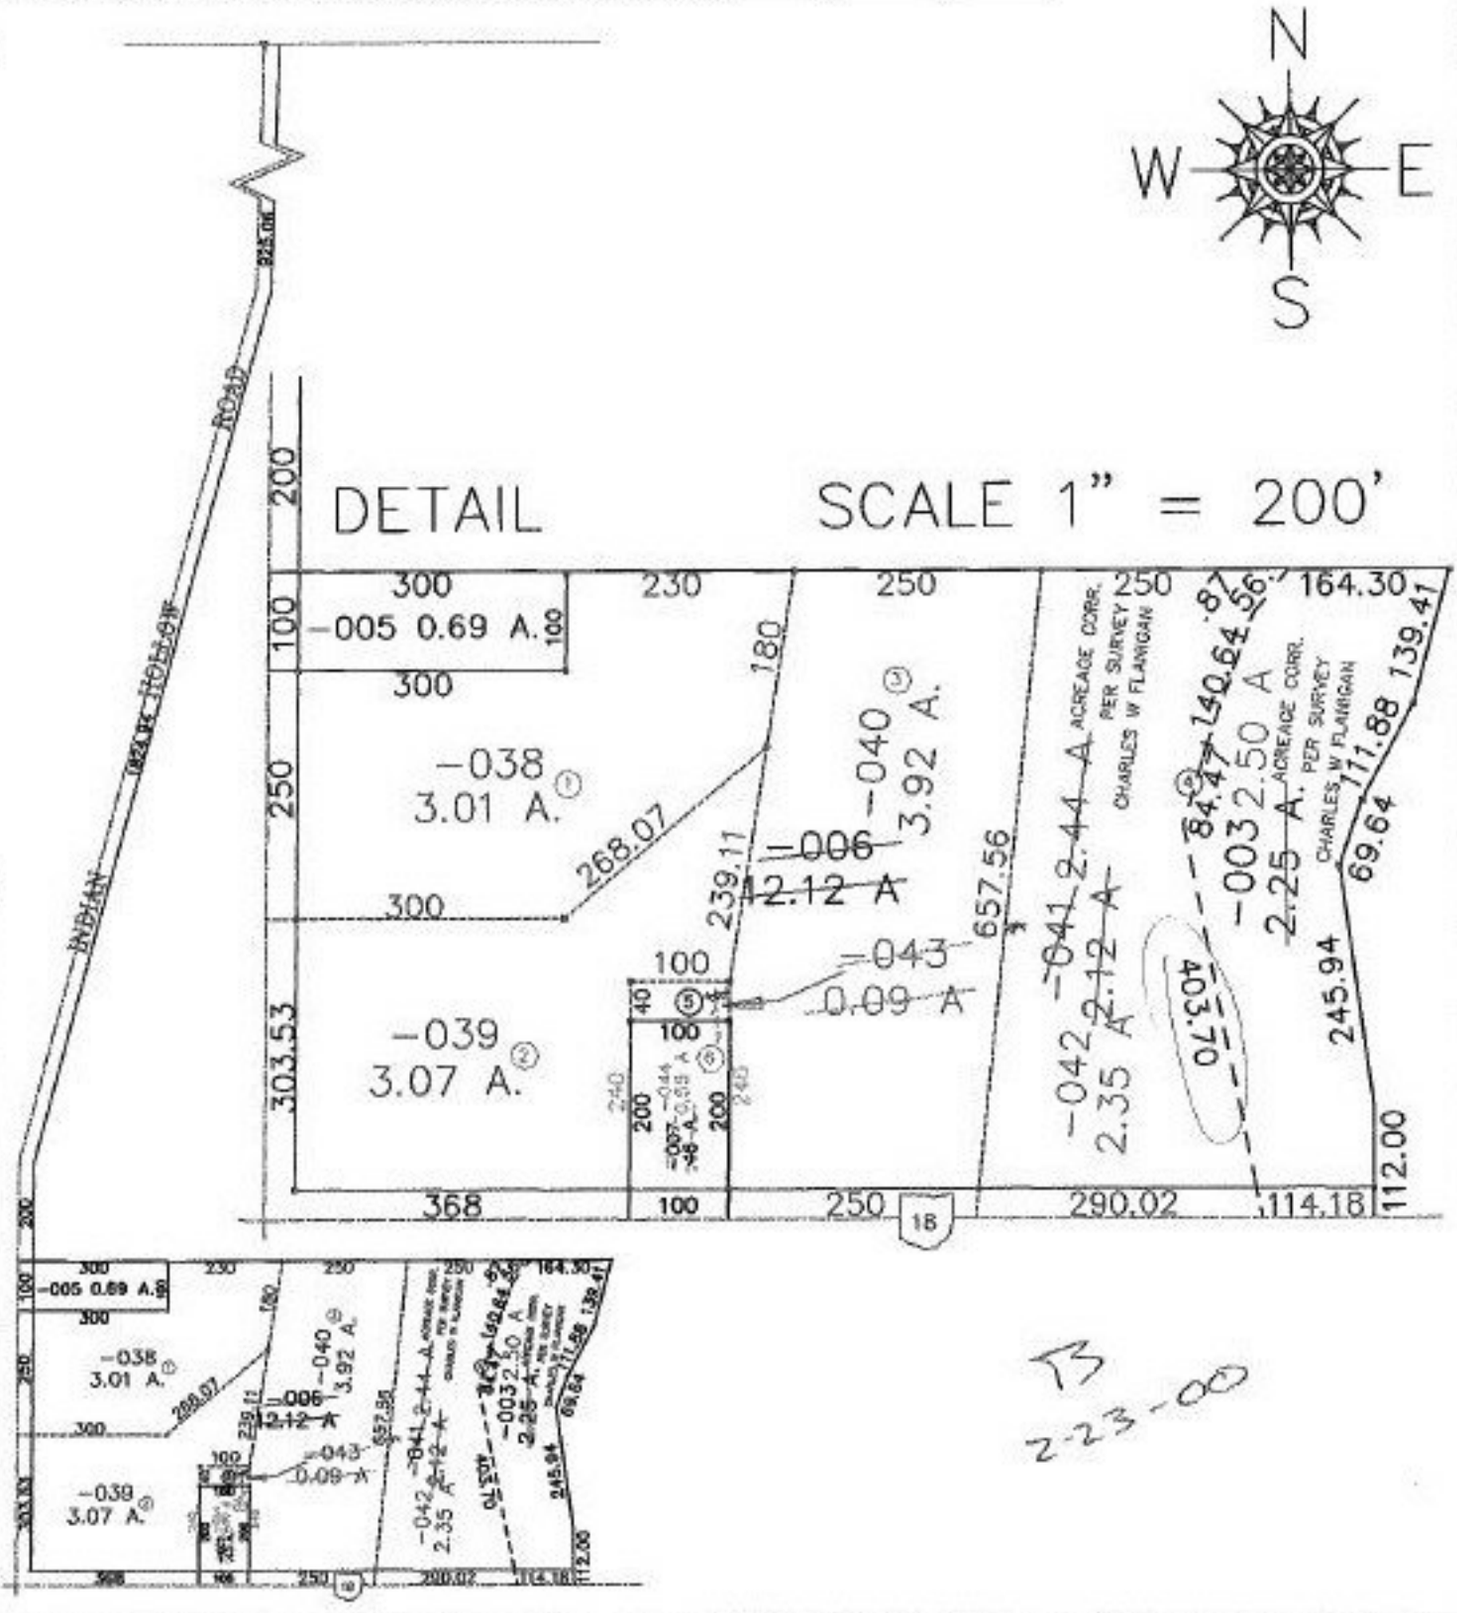

B
2-23-00

SPLITS/DEEDS PROCESSED
LORAIN COUNTY TAX MAP DEPARTMENT
226 MIDDLE AVE. ELYRIA, OHIO

SURVEYED BY: CHARLES W. FLANIGAN
CLOSURE: 0.02 : 10,000
MAP PAGE(S): 19-C
APPROVED BY: DRH DATE: 7/12/99
SCALE: 1" = 400 PRIOR INSTRUMENT: OR 1192/561