#00 106

PARENT PARCEL: 04-00-018-128-203

CHILD PARCEL: 04-00-018-128-204 THRU -206

STARTING POINT: MON. BOX, CL OF AVON BELDON RD. & CL OF WALKER RD.

NO. 00106

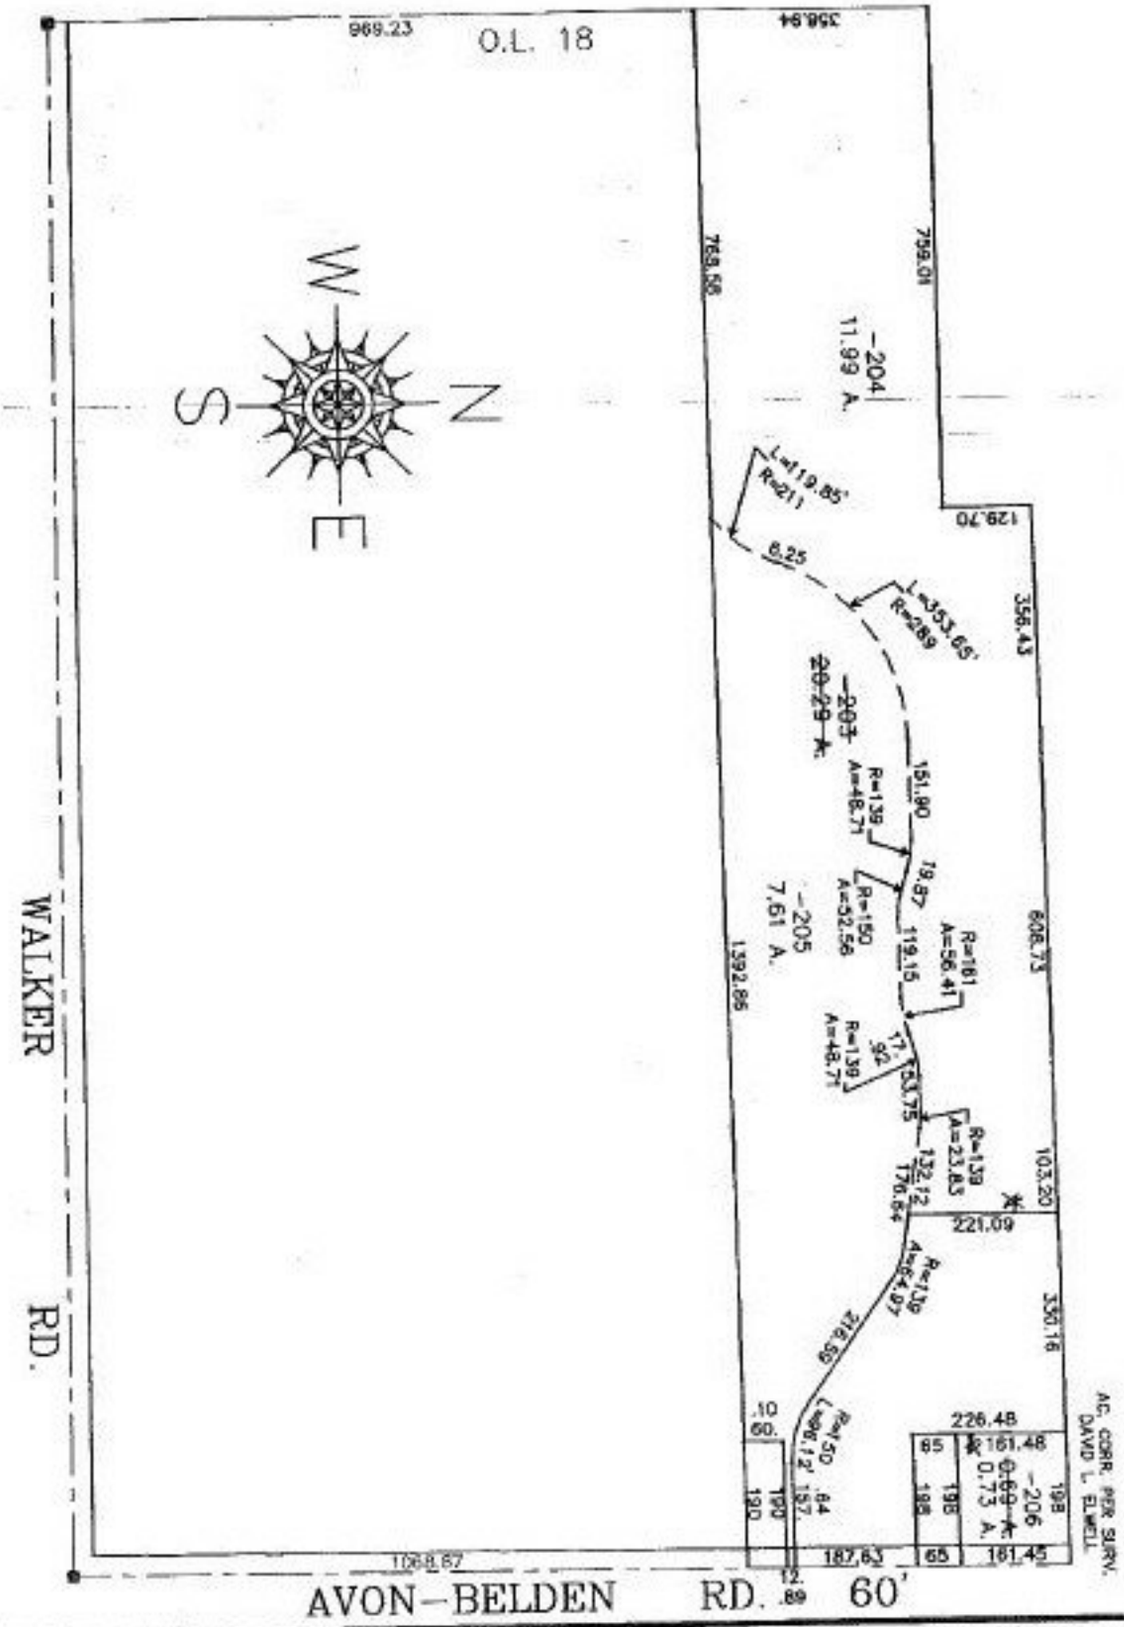

SPLITS/DEEDS PROCESSED

LORAIN COUNTY TAX MAP DEPARTMENT
226 MIDDLE AVE. ELYRIA, OHIO

SURVEYED BY: DAVID L. ELWELL

CLOSURE: 0.07 : 10,000

MAP PAGE(S): 04-00-018-J & I

APPROVED BY: TJS DATE: 06/01/99

SCALE: 1" = 300 PRIOR INSTRUMENT: 980578959