PARENT PARCEL: 14-00-067-000-008, -009, -012

CHILD PARCEL: 14-00-067-000-017, -018, -019, -020, 14-00-074-000-010, -011, -012, -013, -014, -015, -016

STARTING POINT: INTERSECTION OF PITTS RD AND WAKEMAN-LAGRANGE-RICHFIELD ROAD

NO.00112

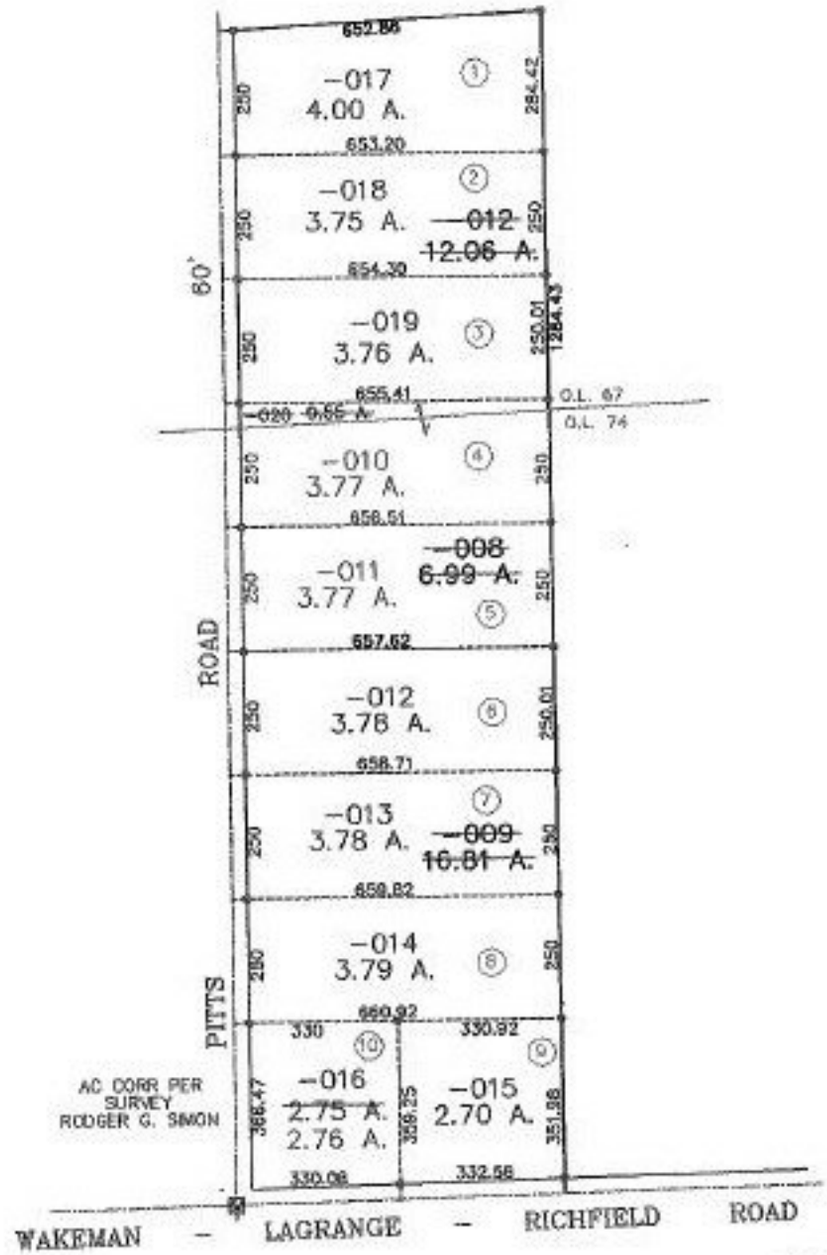

TB 2-21-00

PRIOR INSTRUMENT: #990610335

PRIOR INSTRUMENT: #990610336

SPLITS/DEEDS PROCESSED

LORAIN COUNTY TAX MAP DEPARTMENT
226 MIDDLE AVE. ELYRIA, OHIO

SURVEYED BY: LAUNDON-SIMON-CAHL

CLOSURE: 0.08 : 10,000

MAP PAGE(S): 14-B

APPROVED BY: DRH DATE: 6/4/99

SCALE: 1" = 400