PARENT PARCEL: 02-03-006-104-147

CHILD PARCEL: 02-03-006-104-148 & -149

STARTING POINT: PARCEL 1: MON. BOX, CENTER POINT OF CUL-DE-SAC OF ROSECLIFF DR.
PARCEL 2: N.W. CORNER OF S\L 15 IN ROSECLIFF ESTATES SUBDIVISION

NO. 00114

N
W E
S

DETAIL

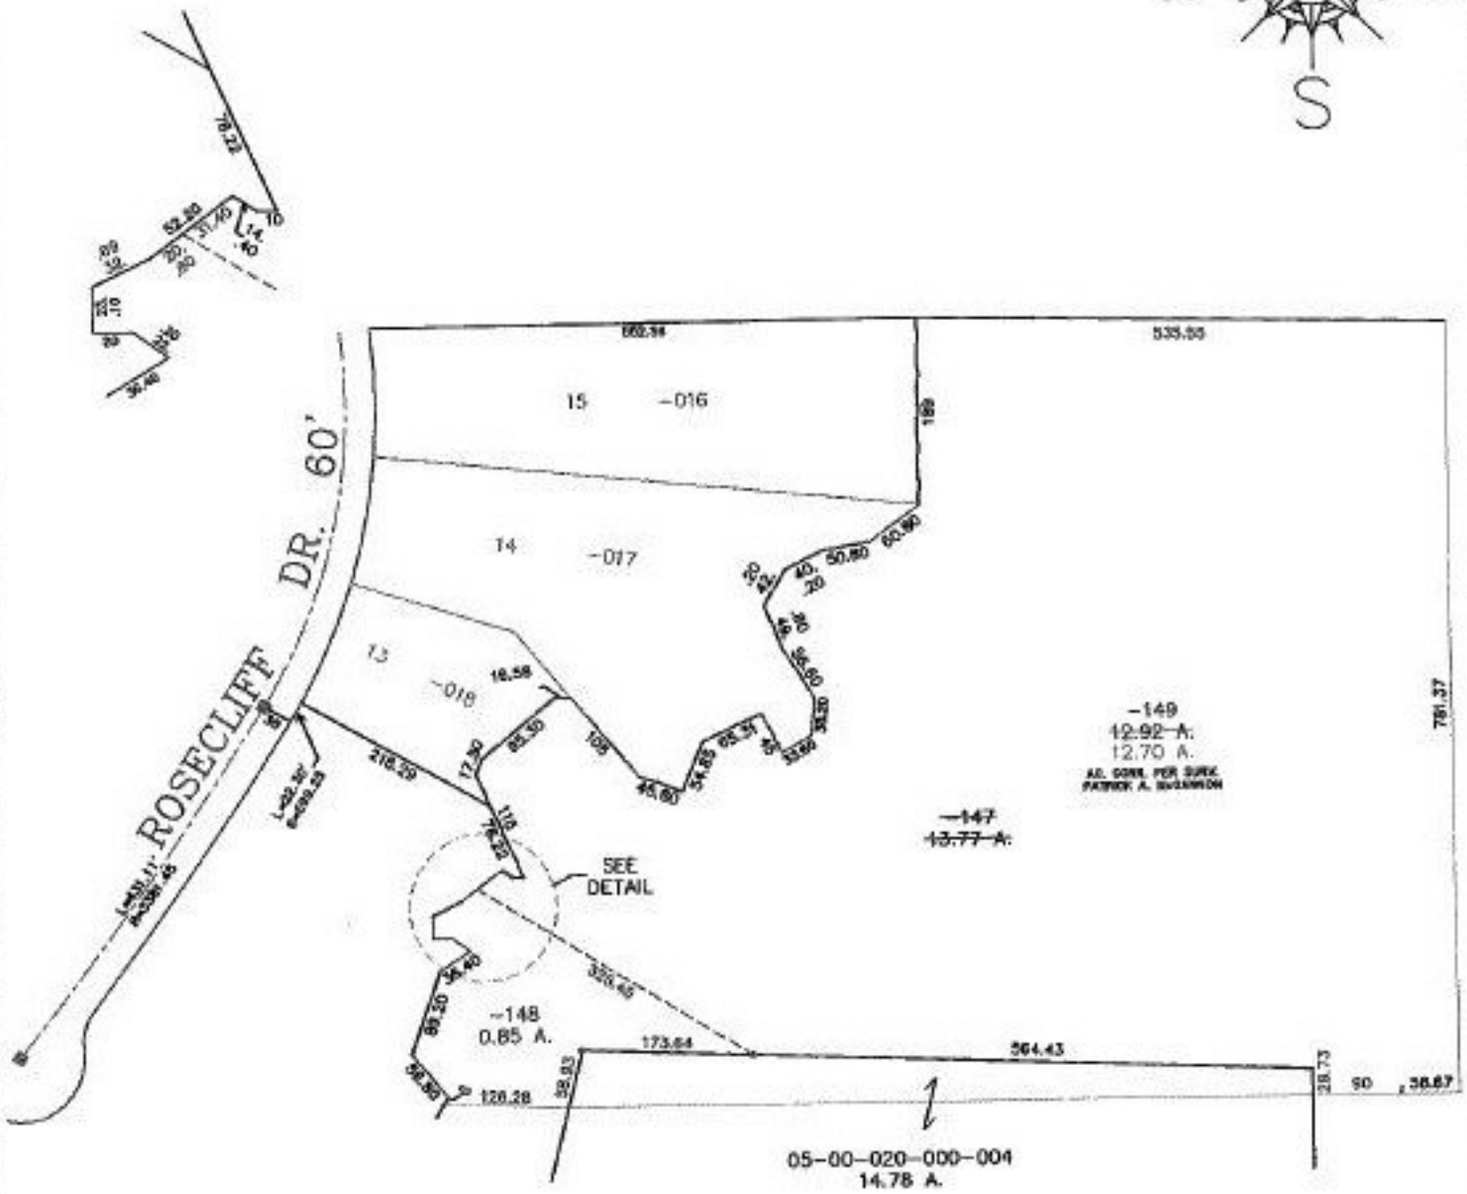


SPLITS/DEEDS PROCESSED
LORAIN COUNTY TAX MAP DEPARTMENT
226 MIDDLE AVE. ELYRIA, OHIO

SURVEYED BY: PATRICK A. McGANNON
CLOSURE: 0.08 : 10,000
MAP PAGE(S): 02-03-006-B
APPROVED BY: TJS DATE: 05/26/99
SCALE: 1" = 200 PRIOR INSTRUMENT: OR 1119/890