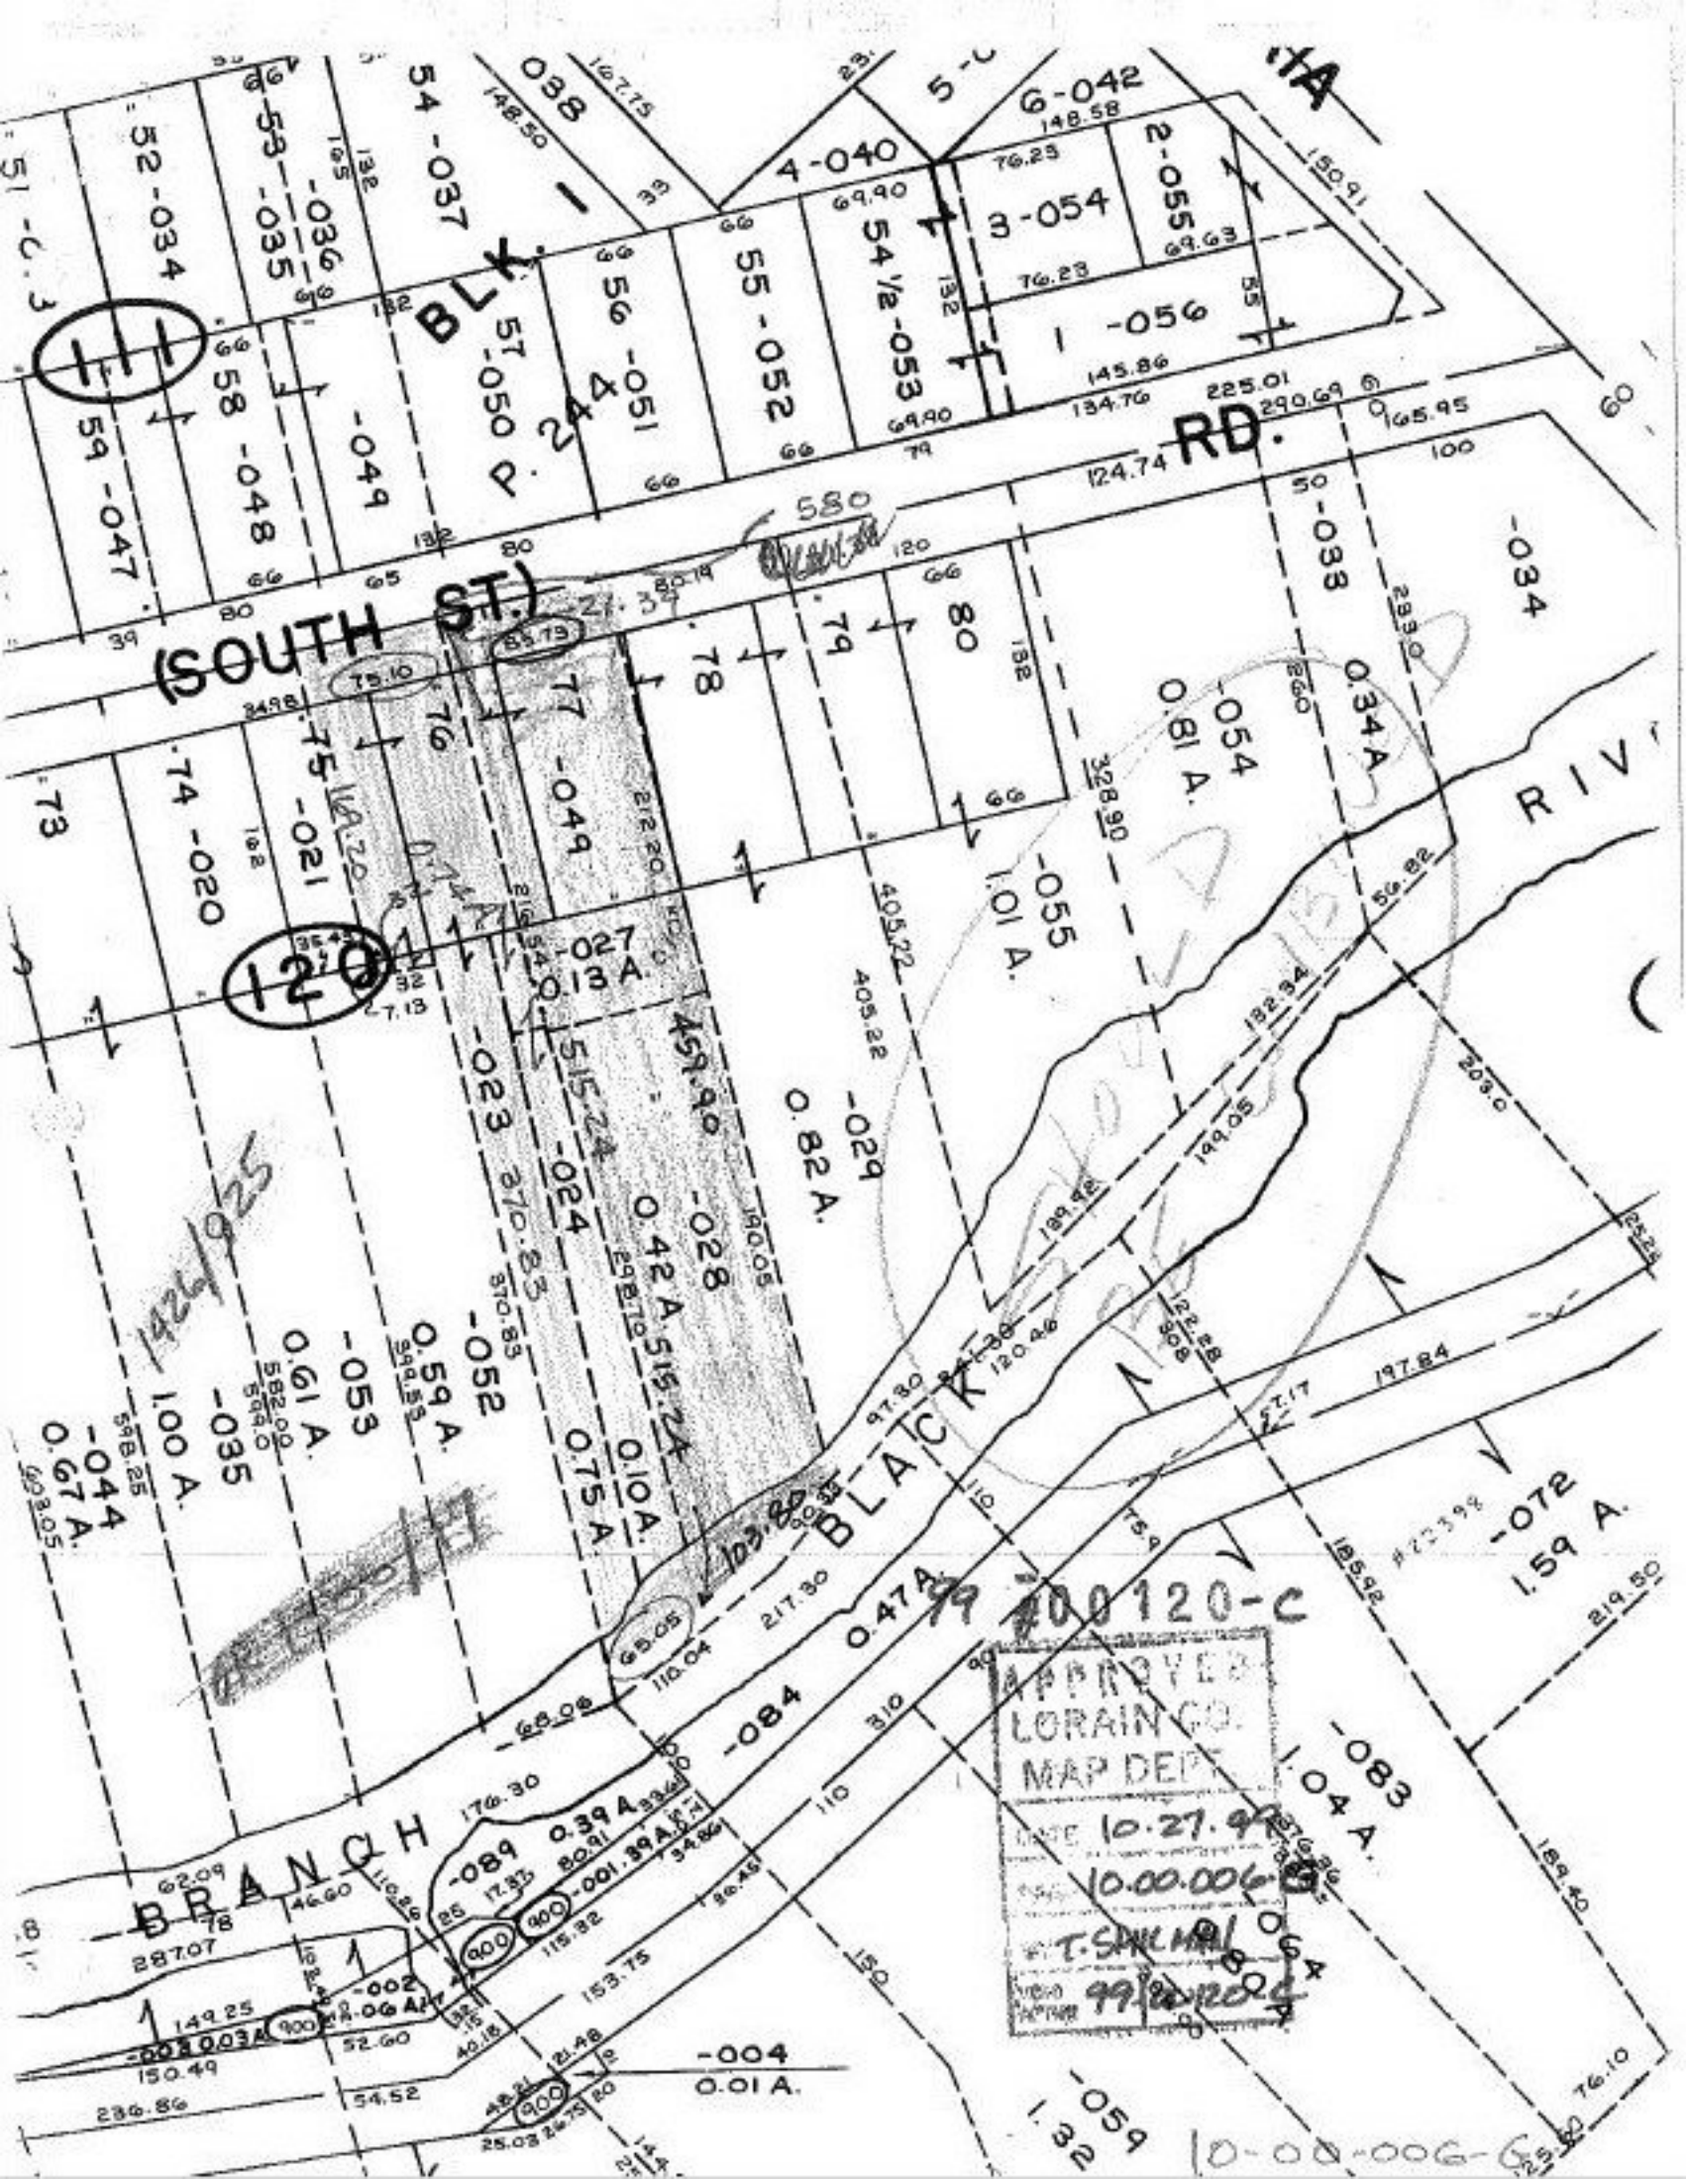

BLK. 1
(SOUTH ST.)
RD.
BLACK
BRANCH
RIV
111
120
99 100120-C
APPROVED
LORAIN CO.
MAP DEPT.
10.27.99
10.00.006-G
T. SHILMAN
99 100120-C
10-00-006-G