PARENT PARCEL: 11-00-076-000-038, 051

CHILD PARCEL: 11-00-076-000-052, -053, -054, -055

STARTING POINT: INT OF S LINE O.L. 76 WITH CL OF DURKEE RD

NO. 00120

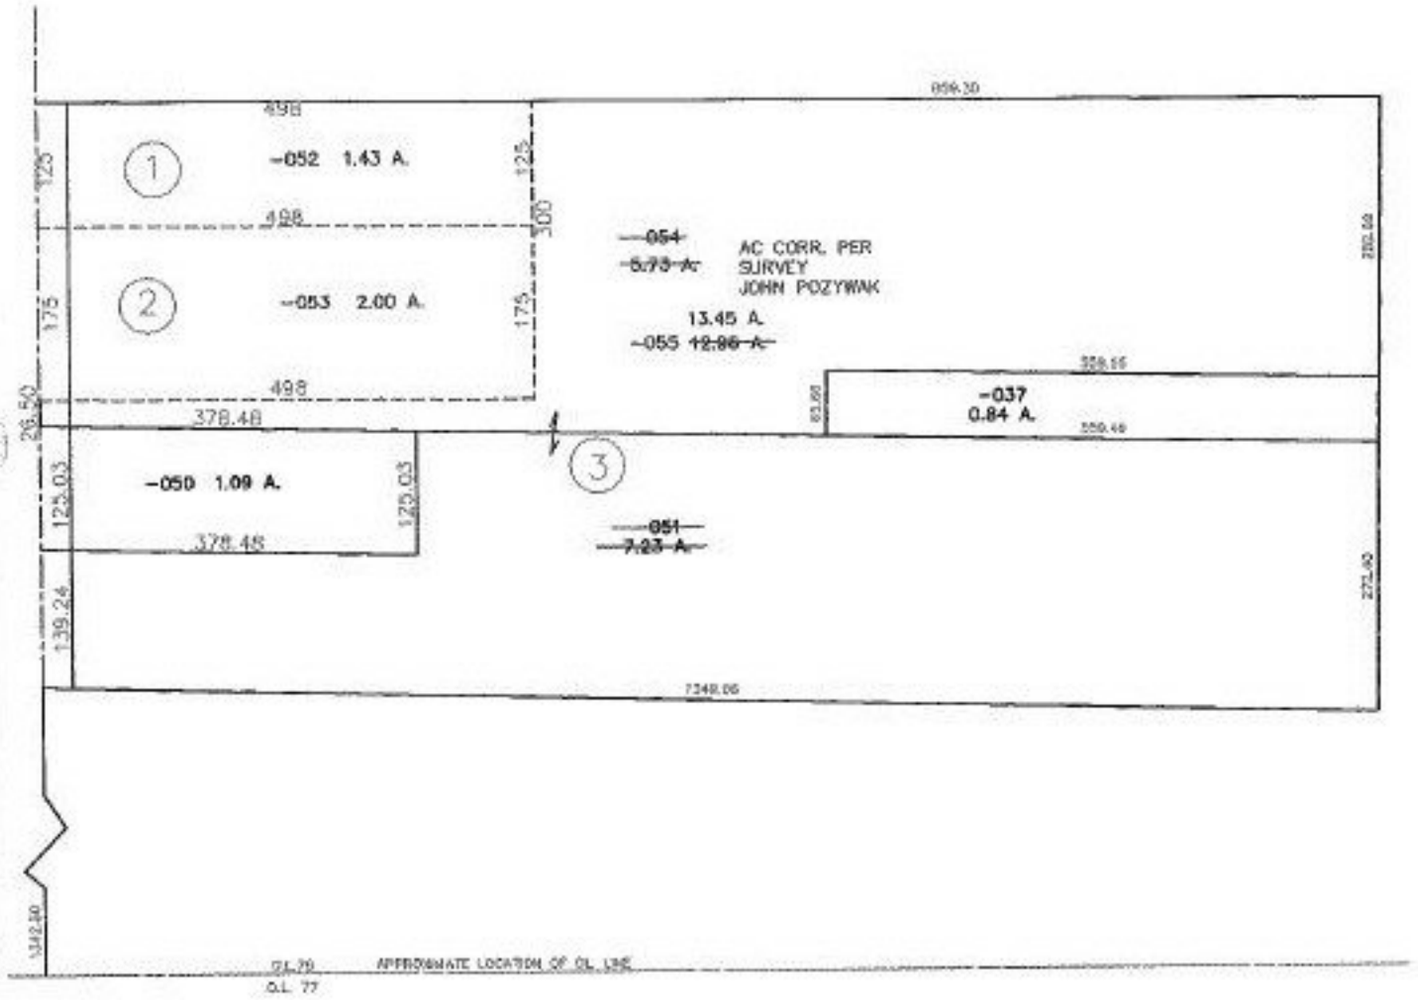

12
2-17-00

SPLITS/DEEDS PROCESSED

LORAIN COUNTY TAX MAP DEPARTMENT

226 MIDDLE AVE. ELYRIA, OHIO

SURVEYED BY: JOHN POZYWAK

CLOSURE: 0.04 : 10,000

MAP PAGE(S): 11-00-076-A

APPROVED BY: DRH DATE: 6/16/99

SCALE: 1"= 200 PRIOR INSTRUMENT: #980519492