PARENT PARCEL: 09-00-014-102-023

CHILD PARCEL: 09-00-014-102-032, -033, -034

STARTING POINT: ANNIS ROAD

NO. 00121

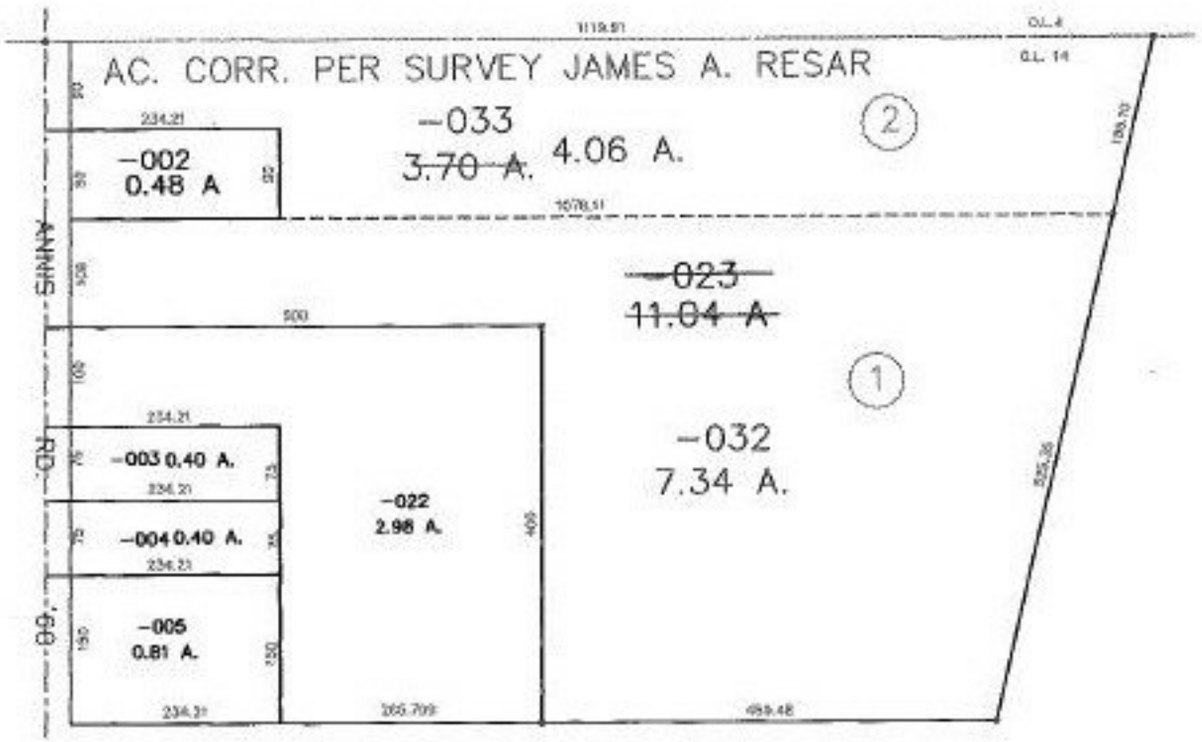

AB
2-14-00

SPLITS/DEEDS PROCESSED

LORAIN COUNTY TAX MAP DEPARTMENT
226 MIDDLE AVE. ELYRIA, OHIO

SURVEYED BY: JAMES A. RESAR

CLOSURE: 0.03 : 10,000

MAP PAGE(S): 09-00-014-B

APPROVED BY: DRH DATE: 6/17/99

SCALE: 1"= 200 PRIOR INSTRUMENT: DV 1344/122