PARENT PARCEL: 06-25-007-000-018, -086, 06-25-001-000-025, -065

CHILD PARCEL: 06-25-001-000-192, 06-25-007-000-241, 242, 243

STARTING POINT: MON BOX CL OF SUGAR LANE 2468.44 S FROM INT WITH CL OF SUGAR RIDGE ROAD

# NO. 00131

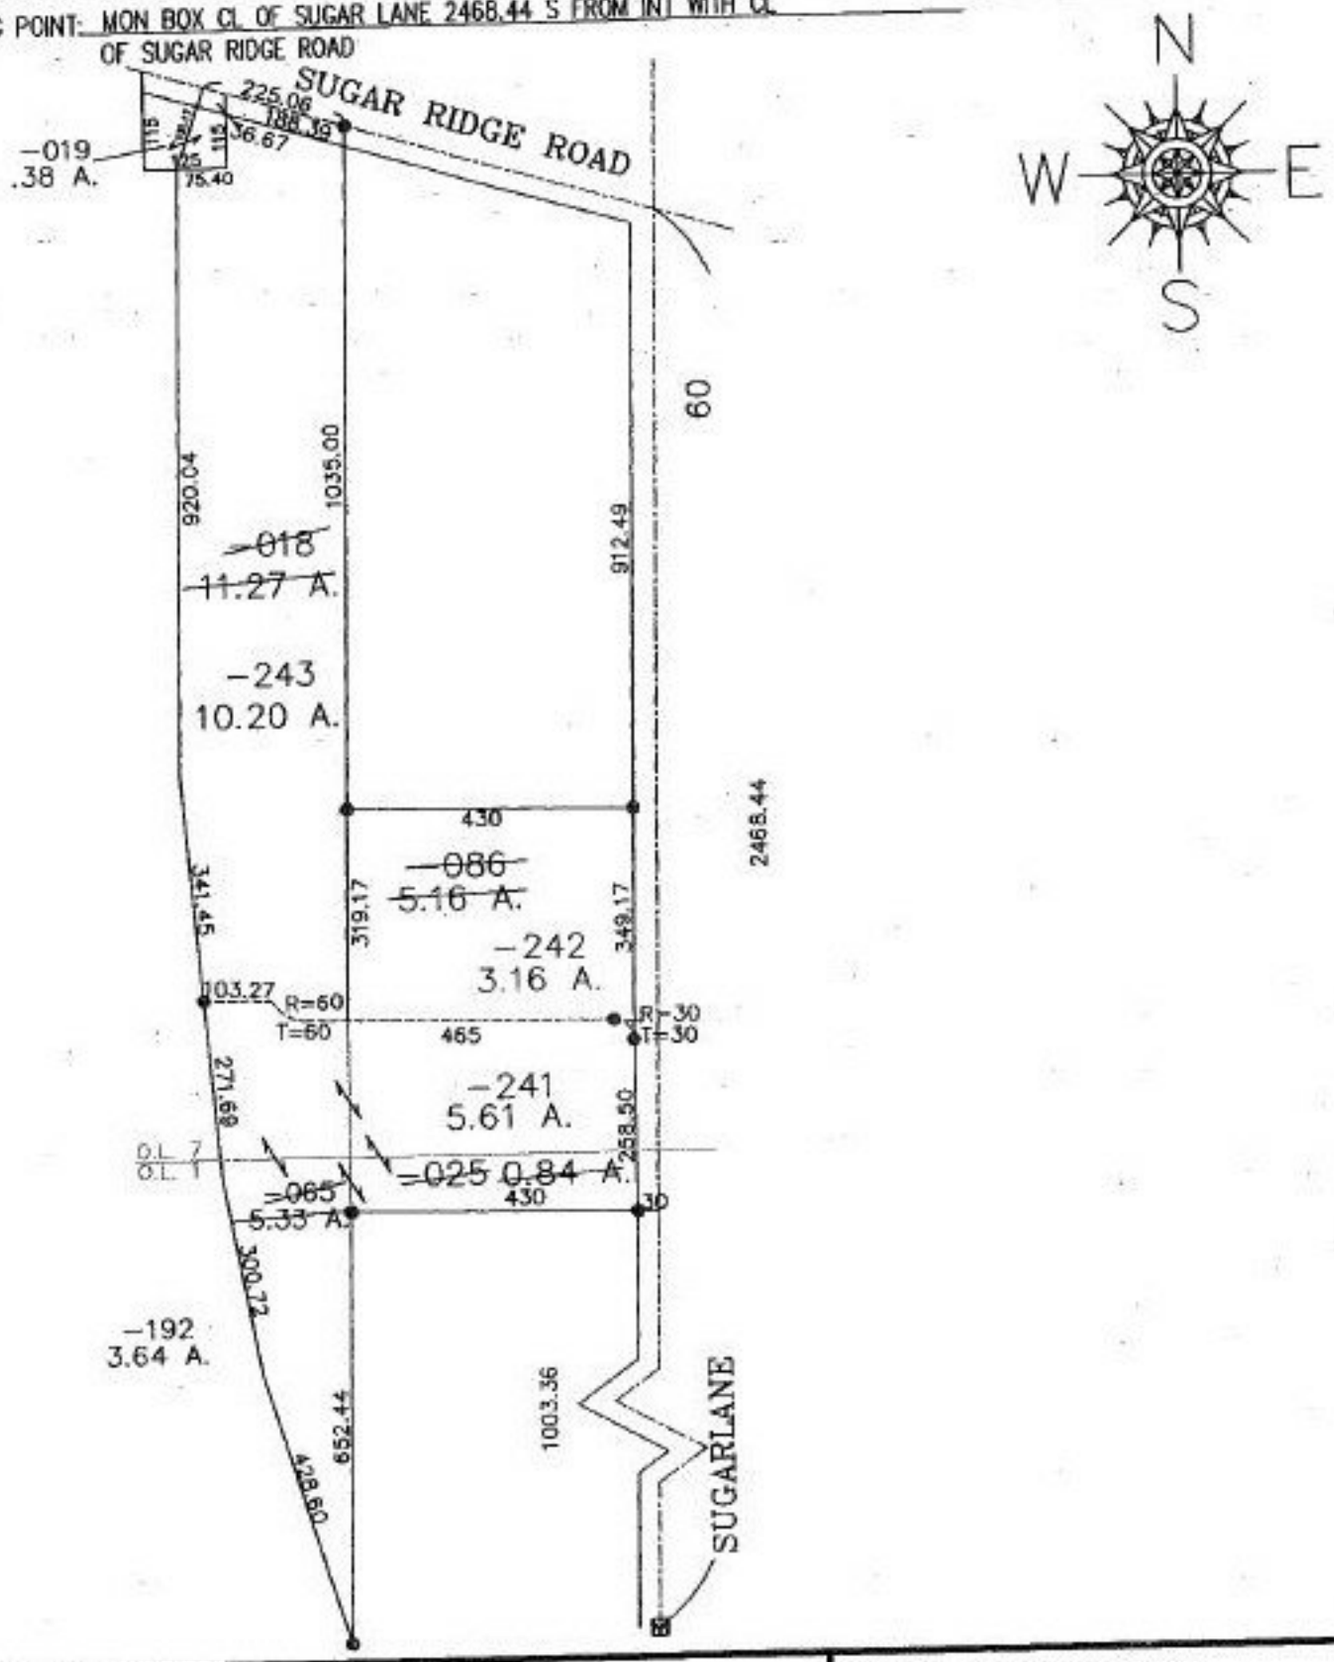


SPLITS/DEEDS PROCESSED

LORAIN COUNTY TAX MAP DEPARTMENT
226 MIDDLE AVE. ELYRIA, OHIO

SURVEYED BY: DAVID L. ELWELL

CLOSURE: 0.02 ; 10,000

MAP PAGE(S): 6-143

APPROVED BY: DRH DATE: 9/2/99

SCALE: 1" = 300 PRIOR INSTRUMENT: 980513278