PARENT PARCEL: 12-00-082-000-066, -054

CHILD PARCEL: 12-00-082-000-067, -068, -069

STARTING POINT: E. LINE O.L. 82 INT OF C.L. OSBORNE ROAD

NO. 00133

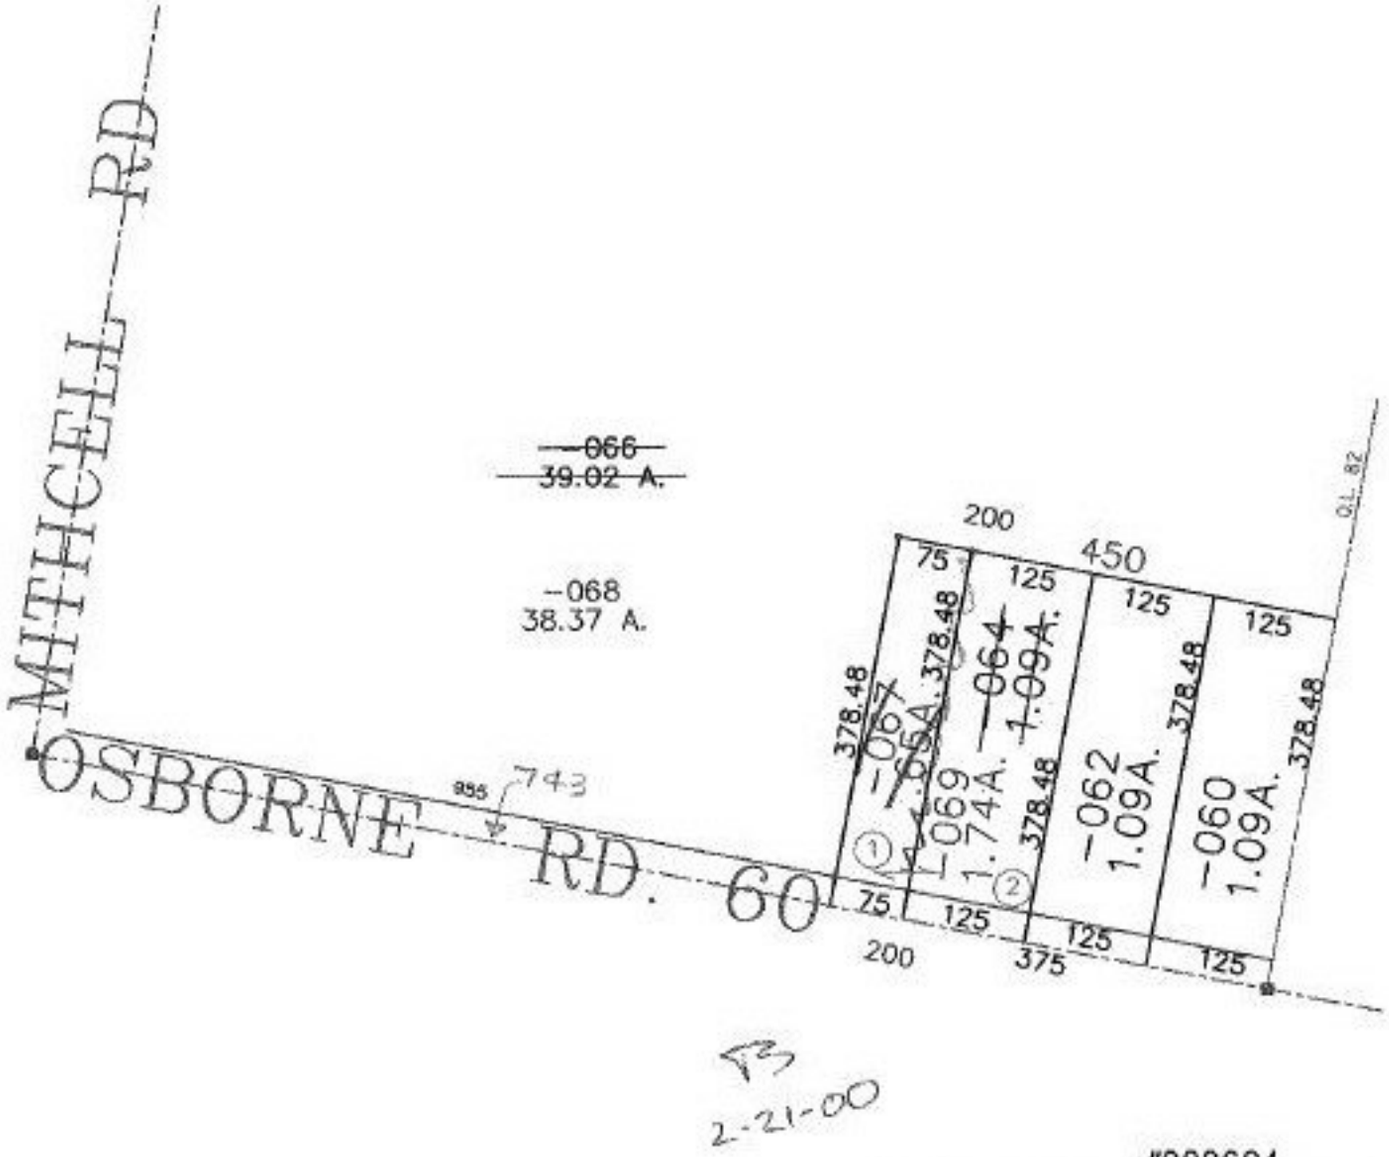

2-21-00

PRIOR INSTRUMENT: #222604
#980573889

SPLITS/DEEDS PROCESSED

LORAIN COUNTY TAX MAP DEPARTMENT
226 MIDDLE AVE. ELYRIA, OHIO

SURVEYED BY: JOHN POZYWAK

CLOSURE: 0.00 : 10,000

MAP PAGE(S): 12-00-082-B

APPROVED BY: DRH DATE: 6/29/99

SCALE: 1" = 200