PARENT PARCEL: 17-08-033-000-006
CHILD PARCEL: 17-08-033-000-007, -008
STARTING POINT: I.P. SE CORNER O.L.33

NO. 00138

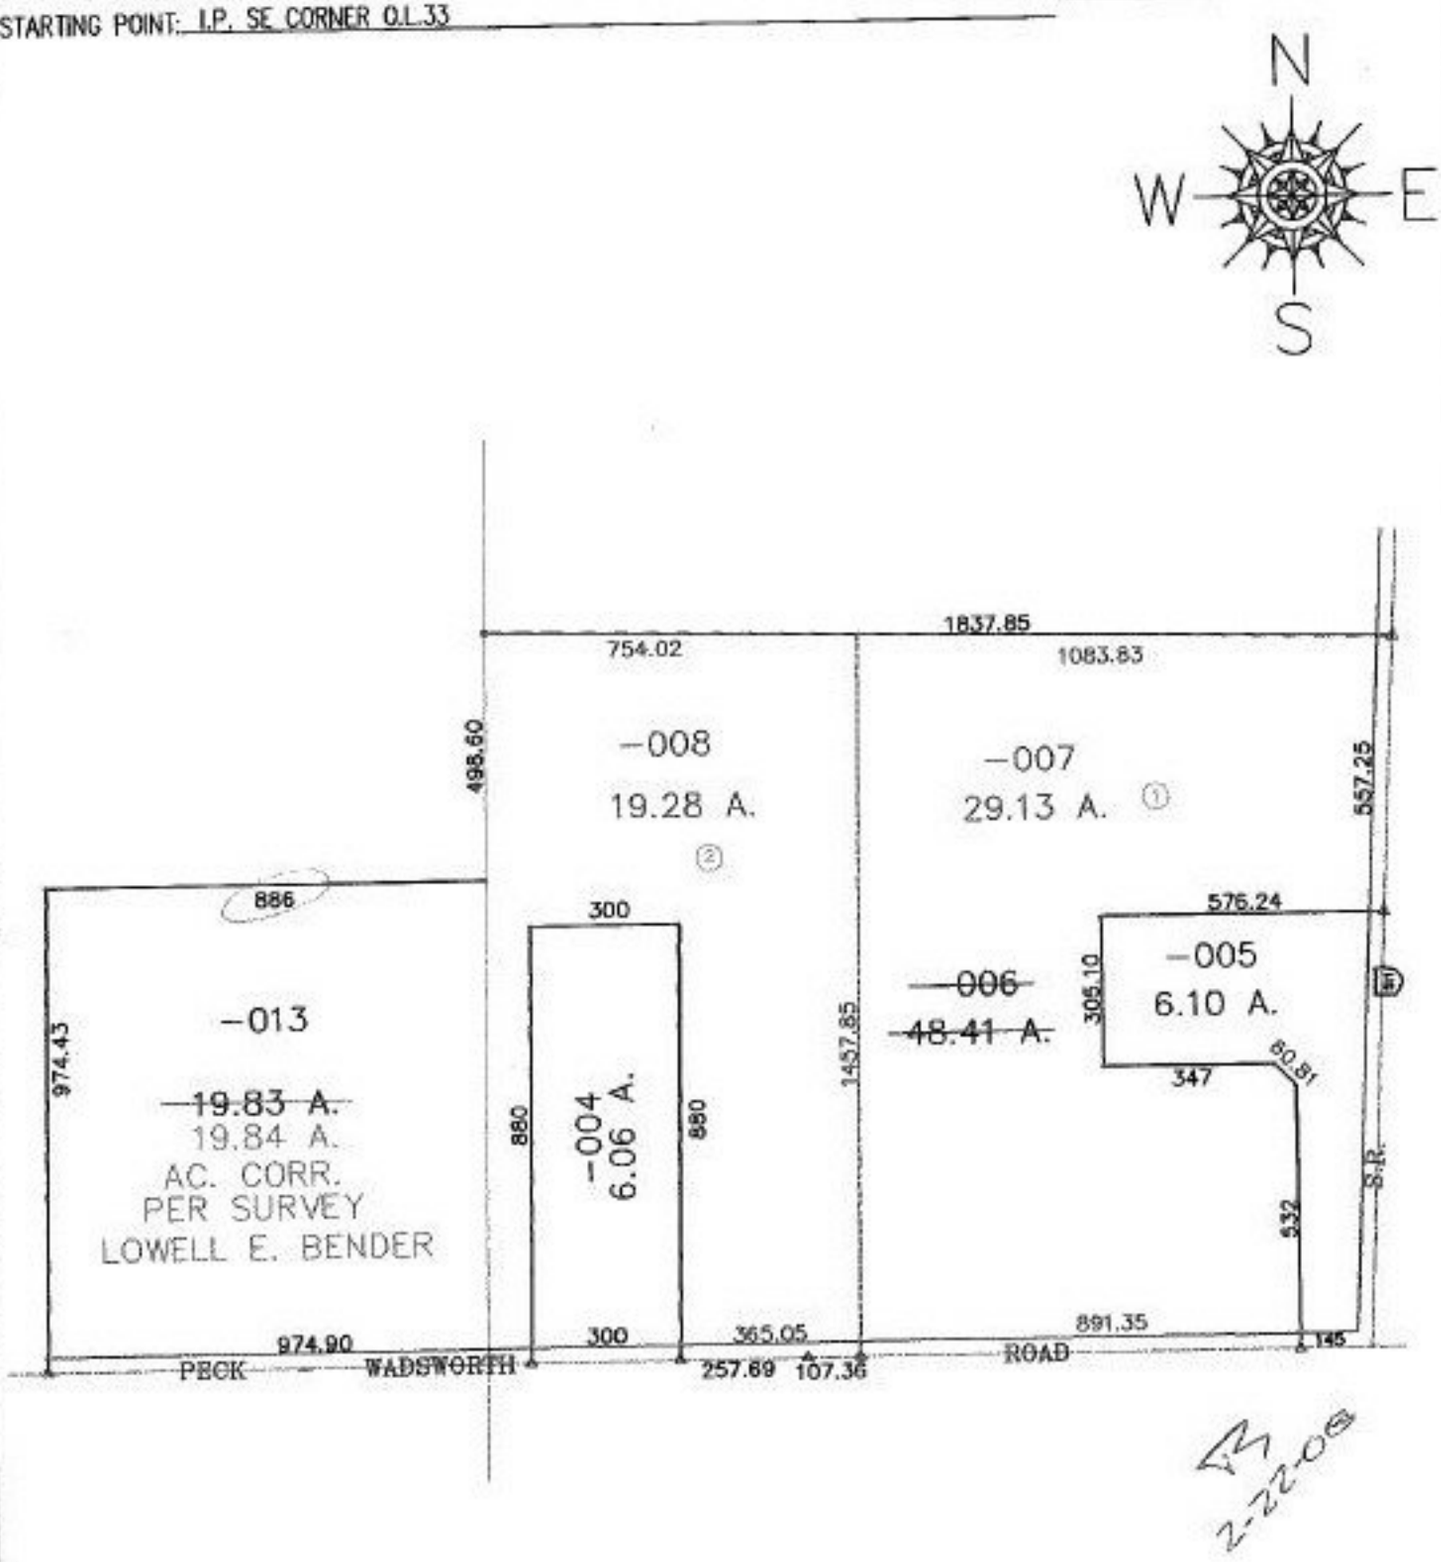

SPLITS/DEEDS PROCESSED
LORAIN COUNTY TAX MAP DEPARTMENT
226 MIDDLE AVE. ELYRIA, OHIO

SURVEYED BY: LOWELL E.BENDER
CLOSURE: 0.64 : 10,000
MAP PAGE(S): 17-8
APPROVED BY: DRH DATE: 6/25/99
SCALE: 1"= 400 PRIOR INSTRUMENT: O.R. 1639/871