PARENT PARCEL: 07-00-009-114-042

CHILD PARCEL: 07-00-009-114-043 THRU -045

STARTING POINT: BEING S\L 21 & 22, & HALF OF VAC. ALLEY & HALF OF VAC. MADISON AVE.

NO. 00145-D

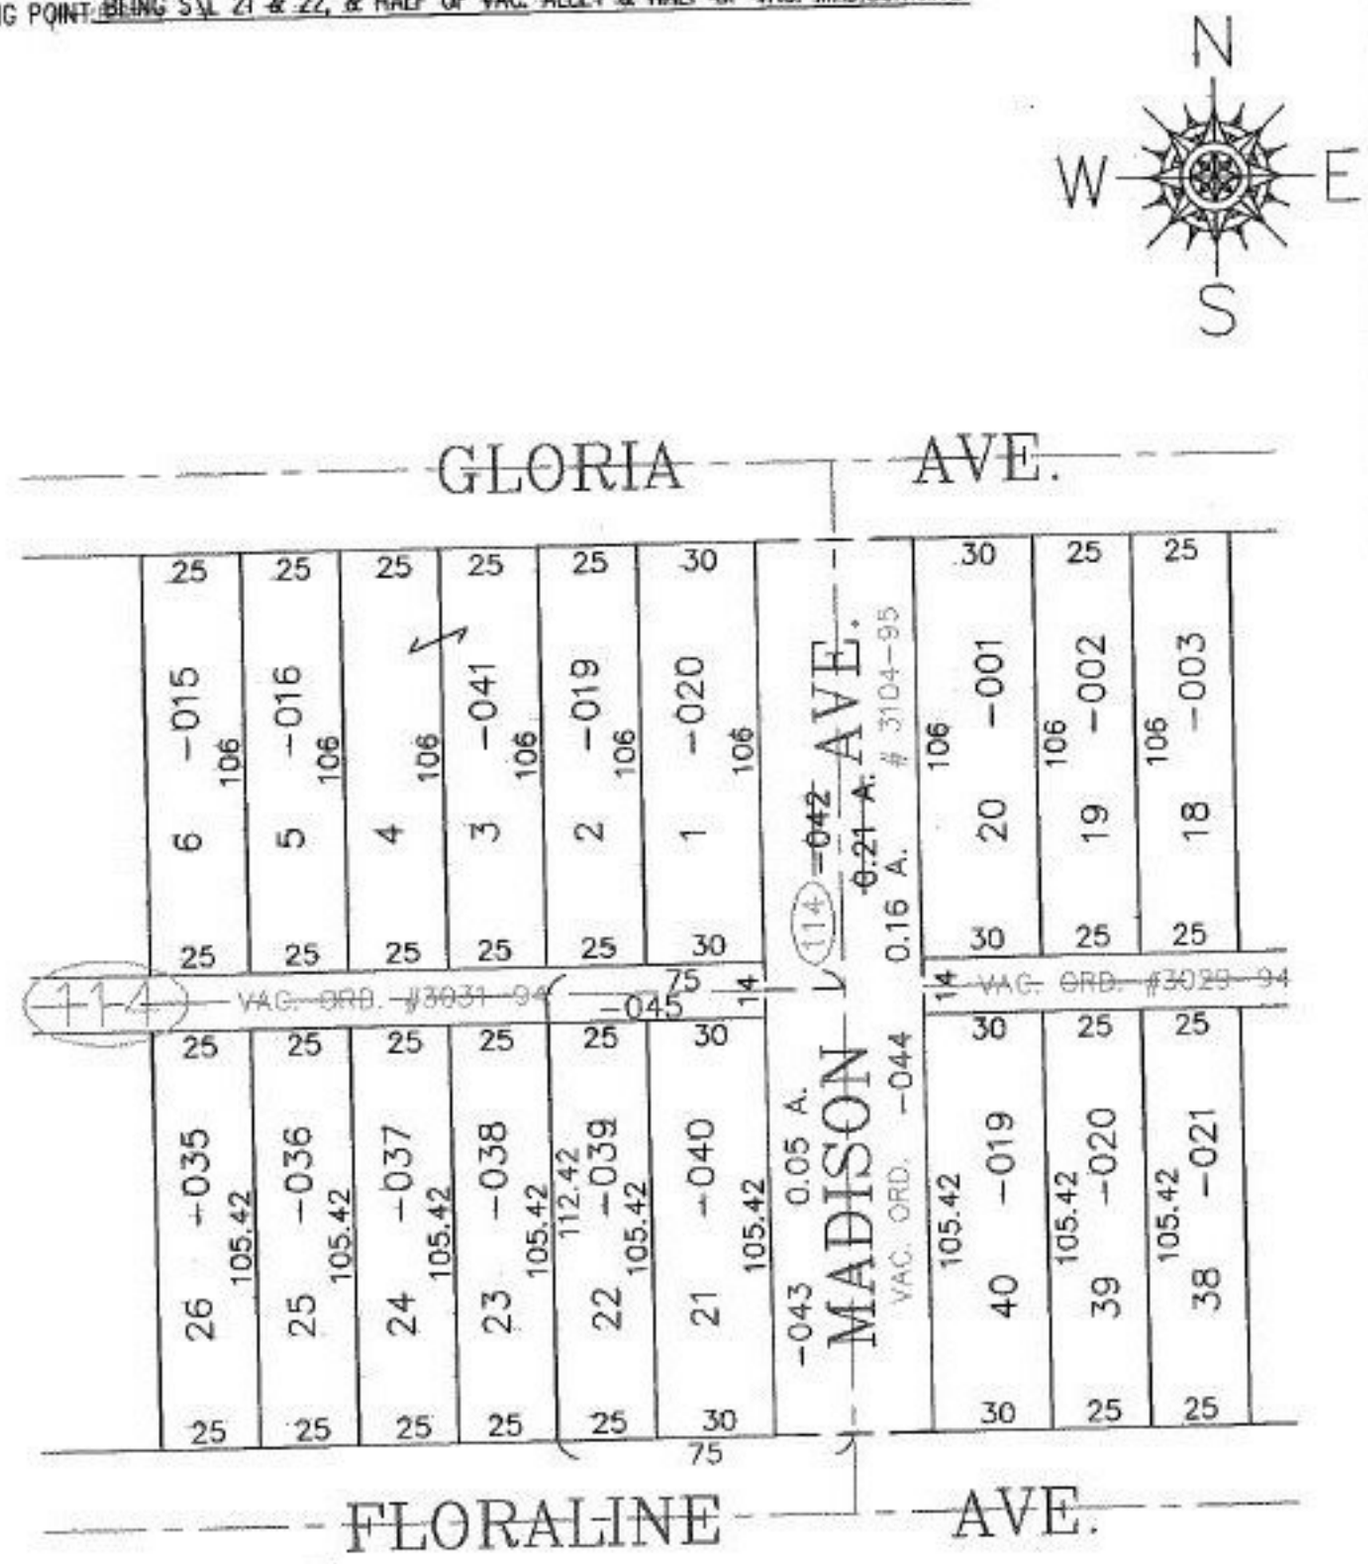

SPLITS/DEEDS PROCESSED

LORAIN COUNTY TAX MAP DEPARTMENT

226 MIDDLE AVE. ELYRIA, OHIO

SURVEYED BY: NONE

CLOSURE: CAN'T RUN

MAP PAGE(S): 07-00-009-A

APPROVED BY: TJS DATE: 06/09/99

SCALE: 1" = 50' PRIOR INSTRUMENT: 980586149