PARENT PARCEL: 10-00-008-107-519, -520, -526

CHILD PARCEL: 10-00-005-107-528, -529

STARTING POINT: INT C.L. AGUSTA DR AND C.L. PINEHURST AVE

NO. 00145

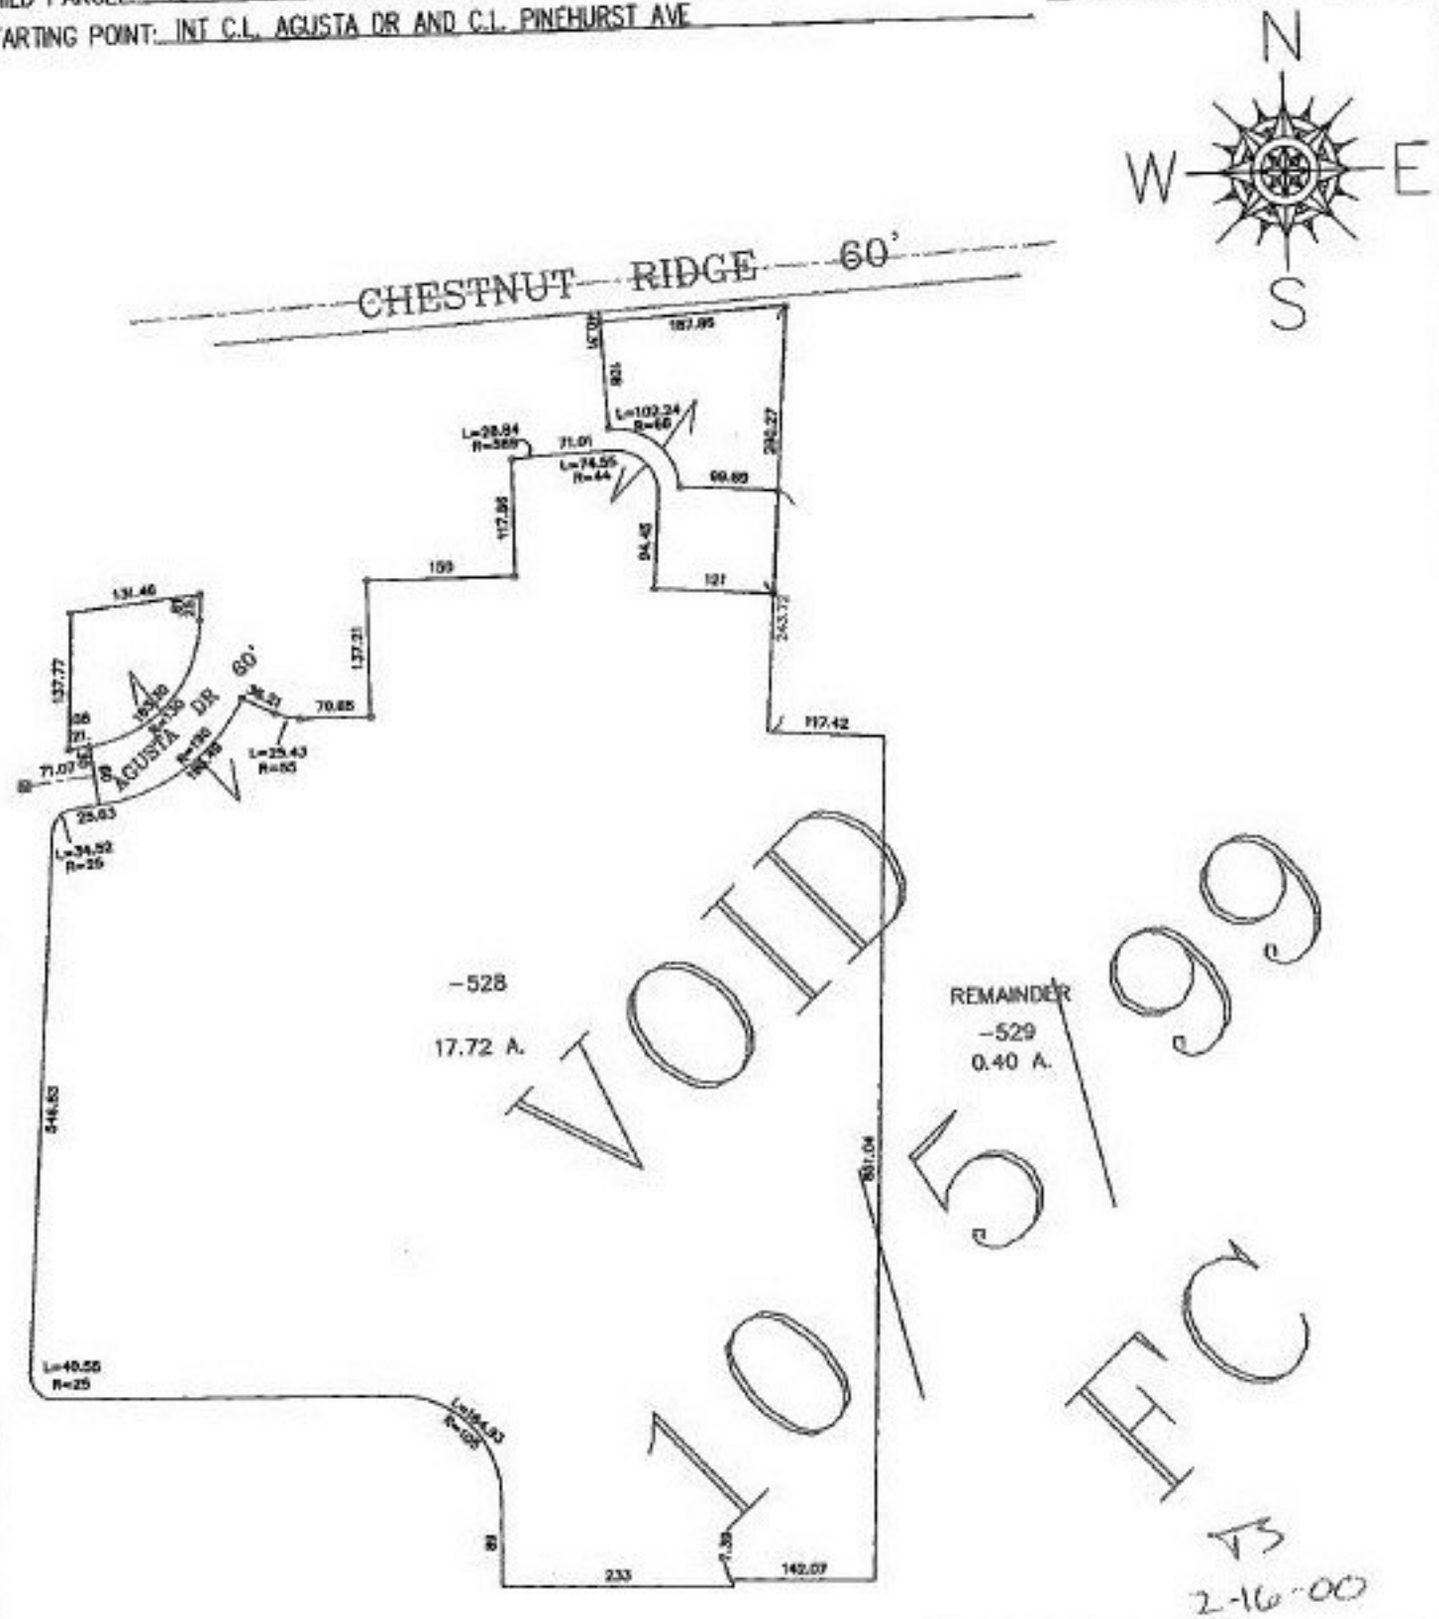

SPLITS/DEEDS PROCESSED

LORAIN COUNTY TAX MAP DEPARTMENT

226 MIDDLE AVE. ELYRIA, OHIO

SURVEYED BY: DAVID E. ELWELL

CLOSURE: 0.06 : 10,000

MAP PAGE(S): 10-00-005-E, F

APPROVED BY: DRH DATE: 6/29/99

SCALE: 1"= 200 PRIOR INSTRUMENT: DV 782/392