PARENT PARCEL: 10-00-010-000-075

CHILD PARCEL: 10-00-010-000-085, -086

STARTING POINT: MON BOX CL WEST ROAD & CL OF RUSSIA RD.

NO. 00152

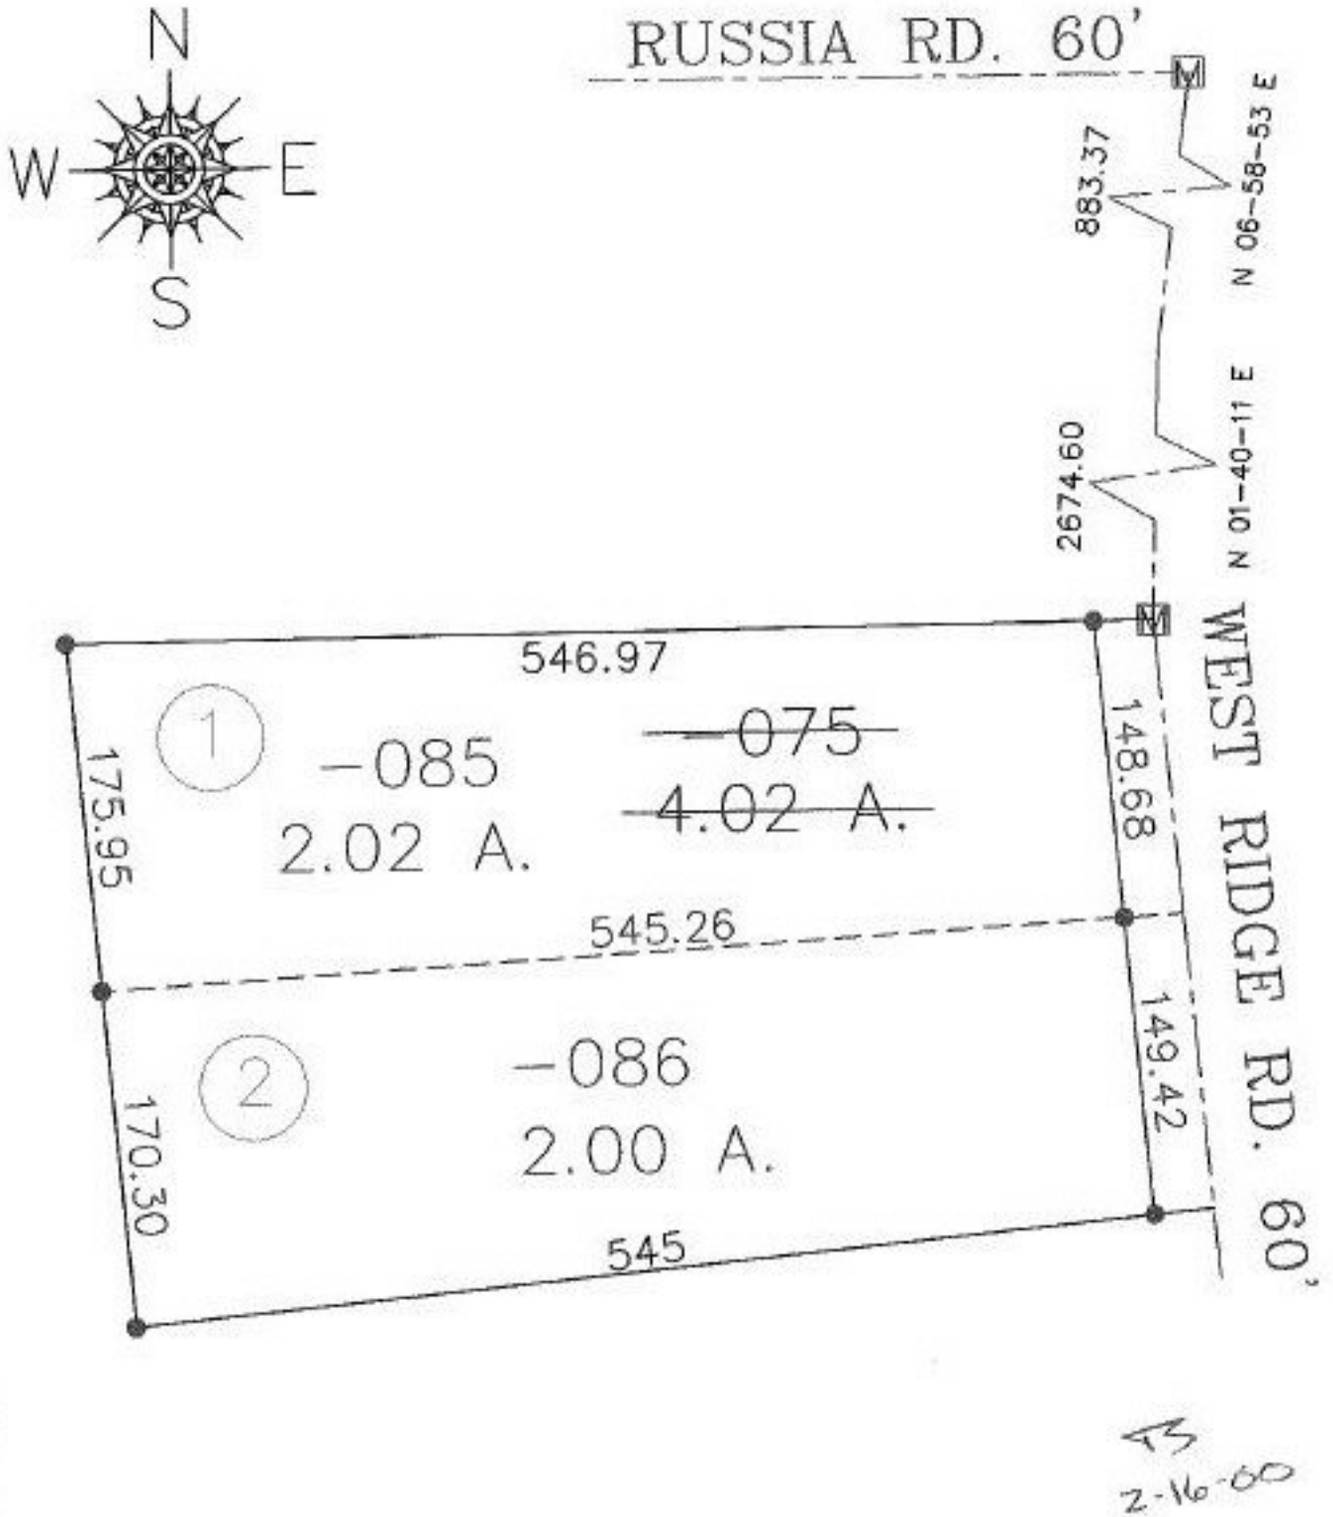

AM 2-16-00

SPLITS/DEEDS PROCESSED

LORAIN COUNTY TAX MAP DEPARTMENT
226 MIDDLE AVE. ELYRIA, OHIO

SURVEYED BY: G. MICHAEL KOVALIK

CLOSURE: 0.02 : 10,000

MAP PAGE(S): 10-A

APPROVED BY: DRH DATE: 7/16/99

SCALE: 1"= 100 PRIOR INSTRUMENT: 1236/748