PARENT PARCEL: 18-00-020-000-110

CHILD PARCEL: 18-00-020-000-111, -112

STARTING POINT: S.E. CORNER OF O.L. 20, AT AN IRON ROD

NO. 00162

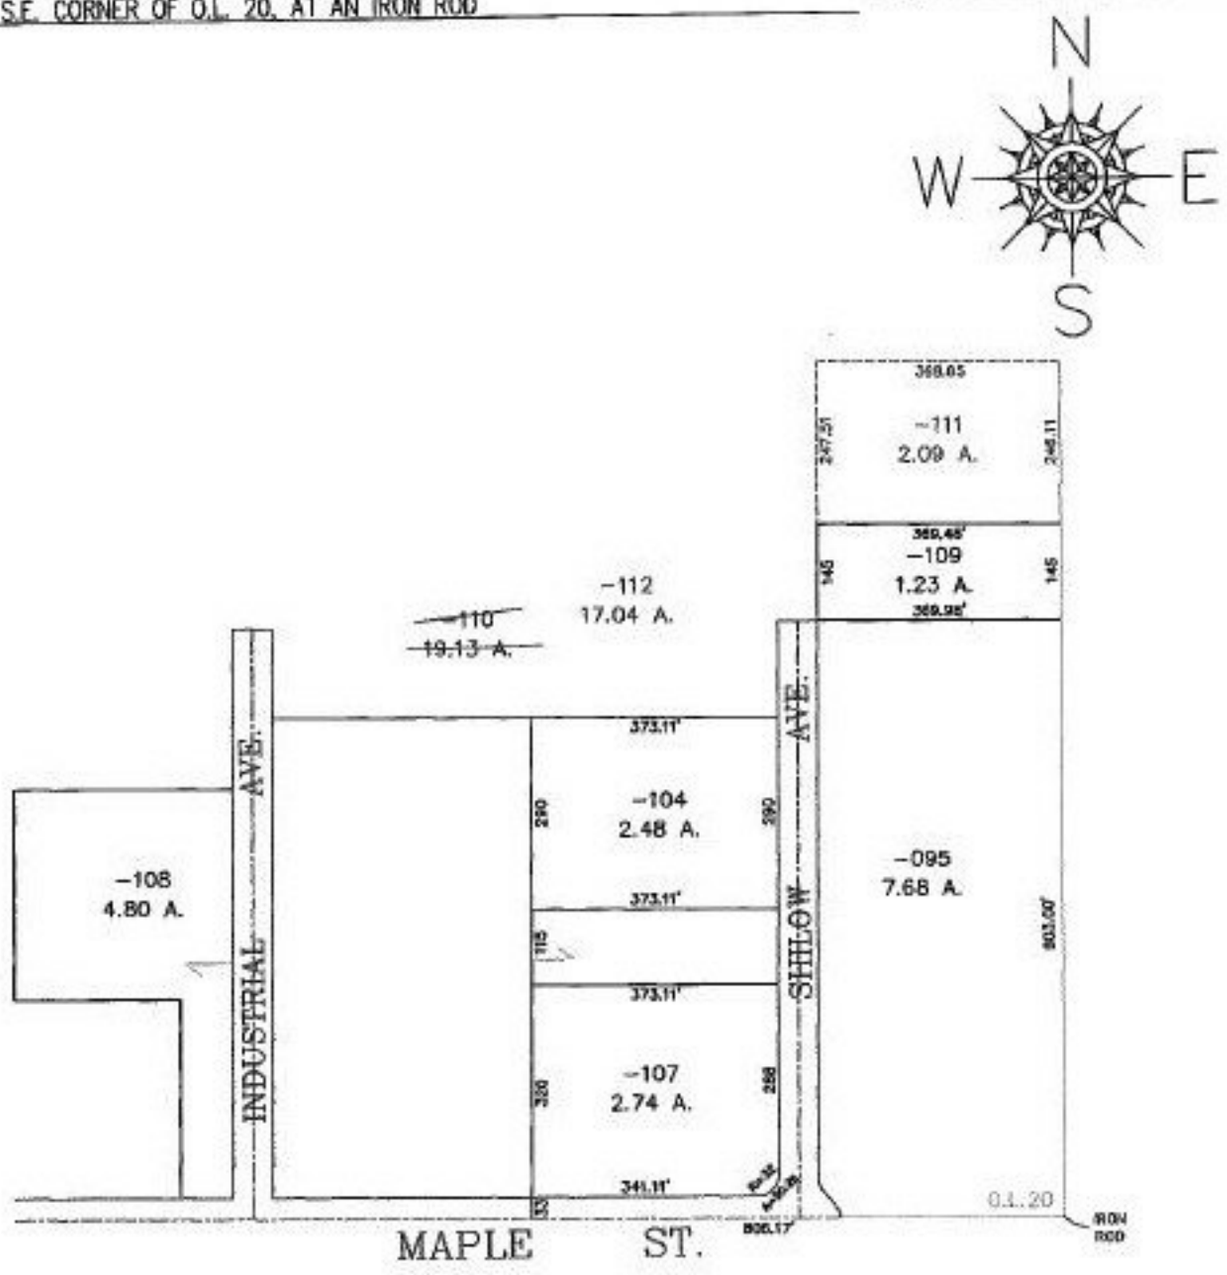

2-22-00

SPLITS/DEEDS PROCESSED

LORAIN COUNTY TAX MAP DEPARTMENT

226 MIDDLE AVE. ELYRIA, OHIO

SURVEYED BY: ROBERT A SANFORD

CLOSURE: 0.06 : 10,000

MAP PAGE(S): 18-00-020-D

APPROVED BY: DRH DATE: 7/16/99

SCALE: 1"= 300 PRIOR INSTRUMENT: DV 1396/747