PARENT PARCEL: 06-24-040-101-003

CHILD PARCEL: 06-24-040-101-049, -050, -051, -052

STARTING POINT: CL ADELBERT INT WESTERLY LINE OF ORCHARD GROVE ALLOT

NO. 00179

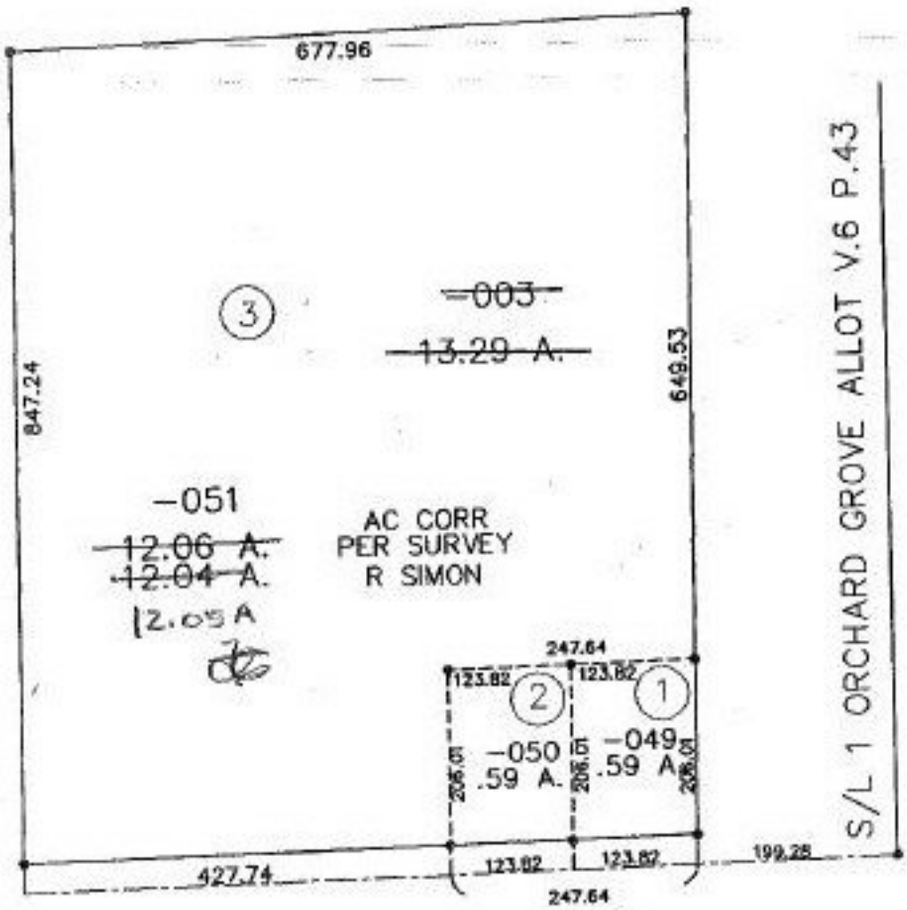

SPLITS/DEEDS PROCESSED

LORAIN COUNTY TAX MAP DEPARTMENT

226 MIDDLE AVE. ELYRIA, OHIO

SURVEYED BY: RODGER G. SIMON

CLOSURE: 0.05 : 10,000

MAP PAGE(S): 6-40 & 6-41

APPROVED BY: DRH DATE: 8/6/99

SCALE: 1" = 200 PRIOR INSTRUMENT: DV 829/531