PARENT PARCEL: 10-00-003-131-053 & -058
CHILD PARCEL: 10-00-003-131-059 & -060
STARTING POINT: INTERSECTION OF THE NORTH LINE OF WANDA AVE. & THE EAST LINE OF LAGRANGE RD.

NO. 00186

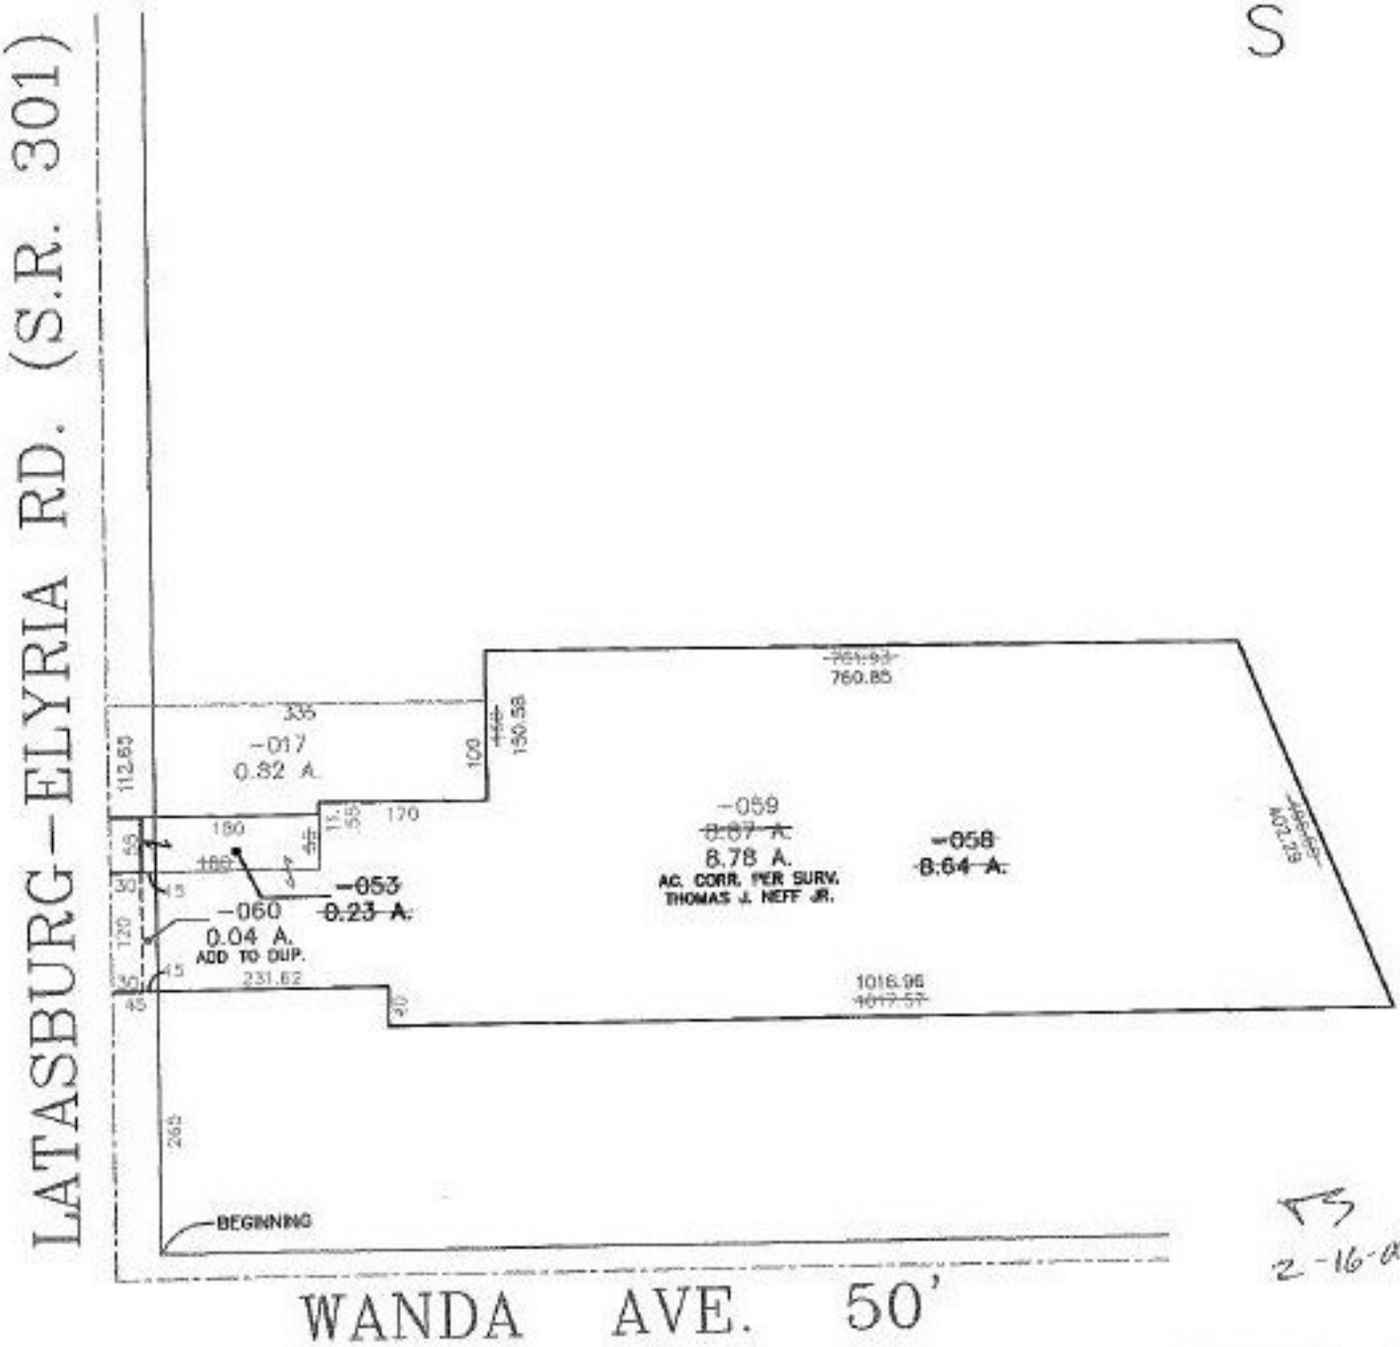

2-16-00

SPLITS/DEEDS PROCESSED
LORAIN COUNTY TAX MAP DEPARTMENT
226 MIDDLE AVE. ELYRIA, OHIO

SURVEYED BY: THOMAS J. NEFF JR.
CLOSURE: 0.01 : 10.000
MAP PAGE(S): 10-00-003-C
APPROVED BY: T. SPILLMAN DATE: 09/10/99
SCALE: 1" = 200 PRIOR INSTRUMENT: OR 1219/561