PARENT PARCEL: 01-00-056-000-044, -047 01-00-057-000-013, 01-00-058-000-018

CHILD PARCEL: 01-00-056-000-048 THRU -053, 01-00-057-000-014 THRU -018
01-00-058-000-020, -021

STARTING POINT: C.L. MIDDLE RIDGE INT E LINE O.L. 56

NO. 00188

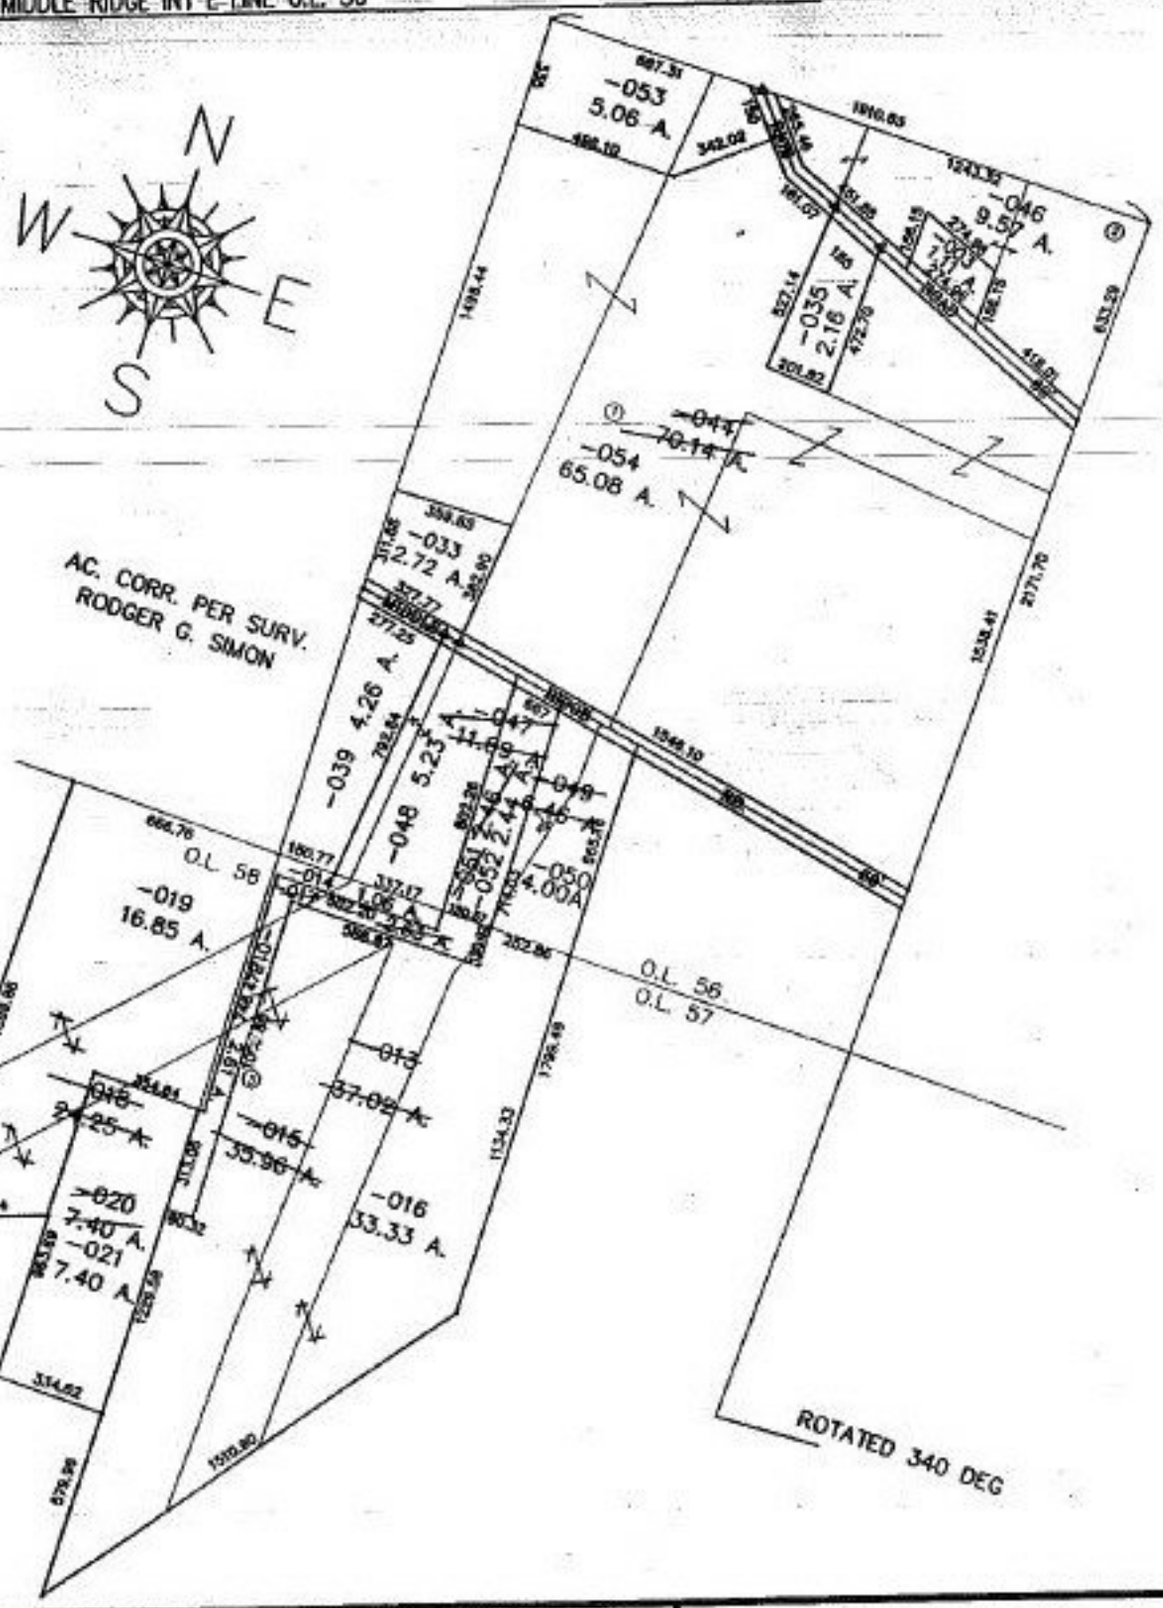

SPLITS/DEEDS PROCESSED

LORAIN COUNTY TAX MAP DEPARTMENT
226 MIDDLE AVE. ELYRIA, OHIO

SURVEYED BY: RODGER G. SIMON
CLOSURE: 0.02 : 10,000
MAP PAGE(S): 1-1
APPROVED BY: DRH &TJS DATE: 8/12/99
SCALE: 1" = 600 PRIOR INSTRUMENT: #990627545