PARENT PARCEL: 09-00-071-000-003

CHILD PARCEL: 09-00-071-000-010 THRU -013

STARTING POINT: I.P. MON. BOX, S.E. CORNER OF O.L. 71

NO. 00203

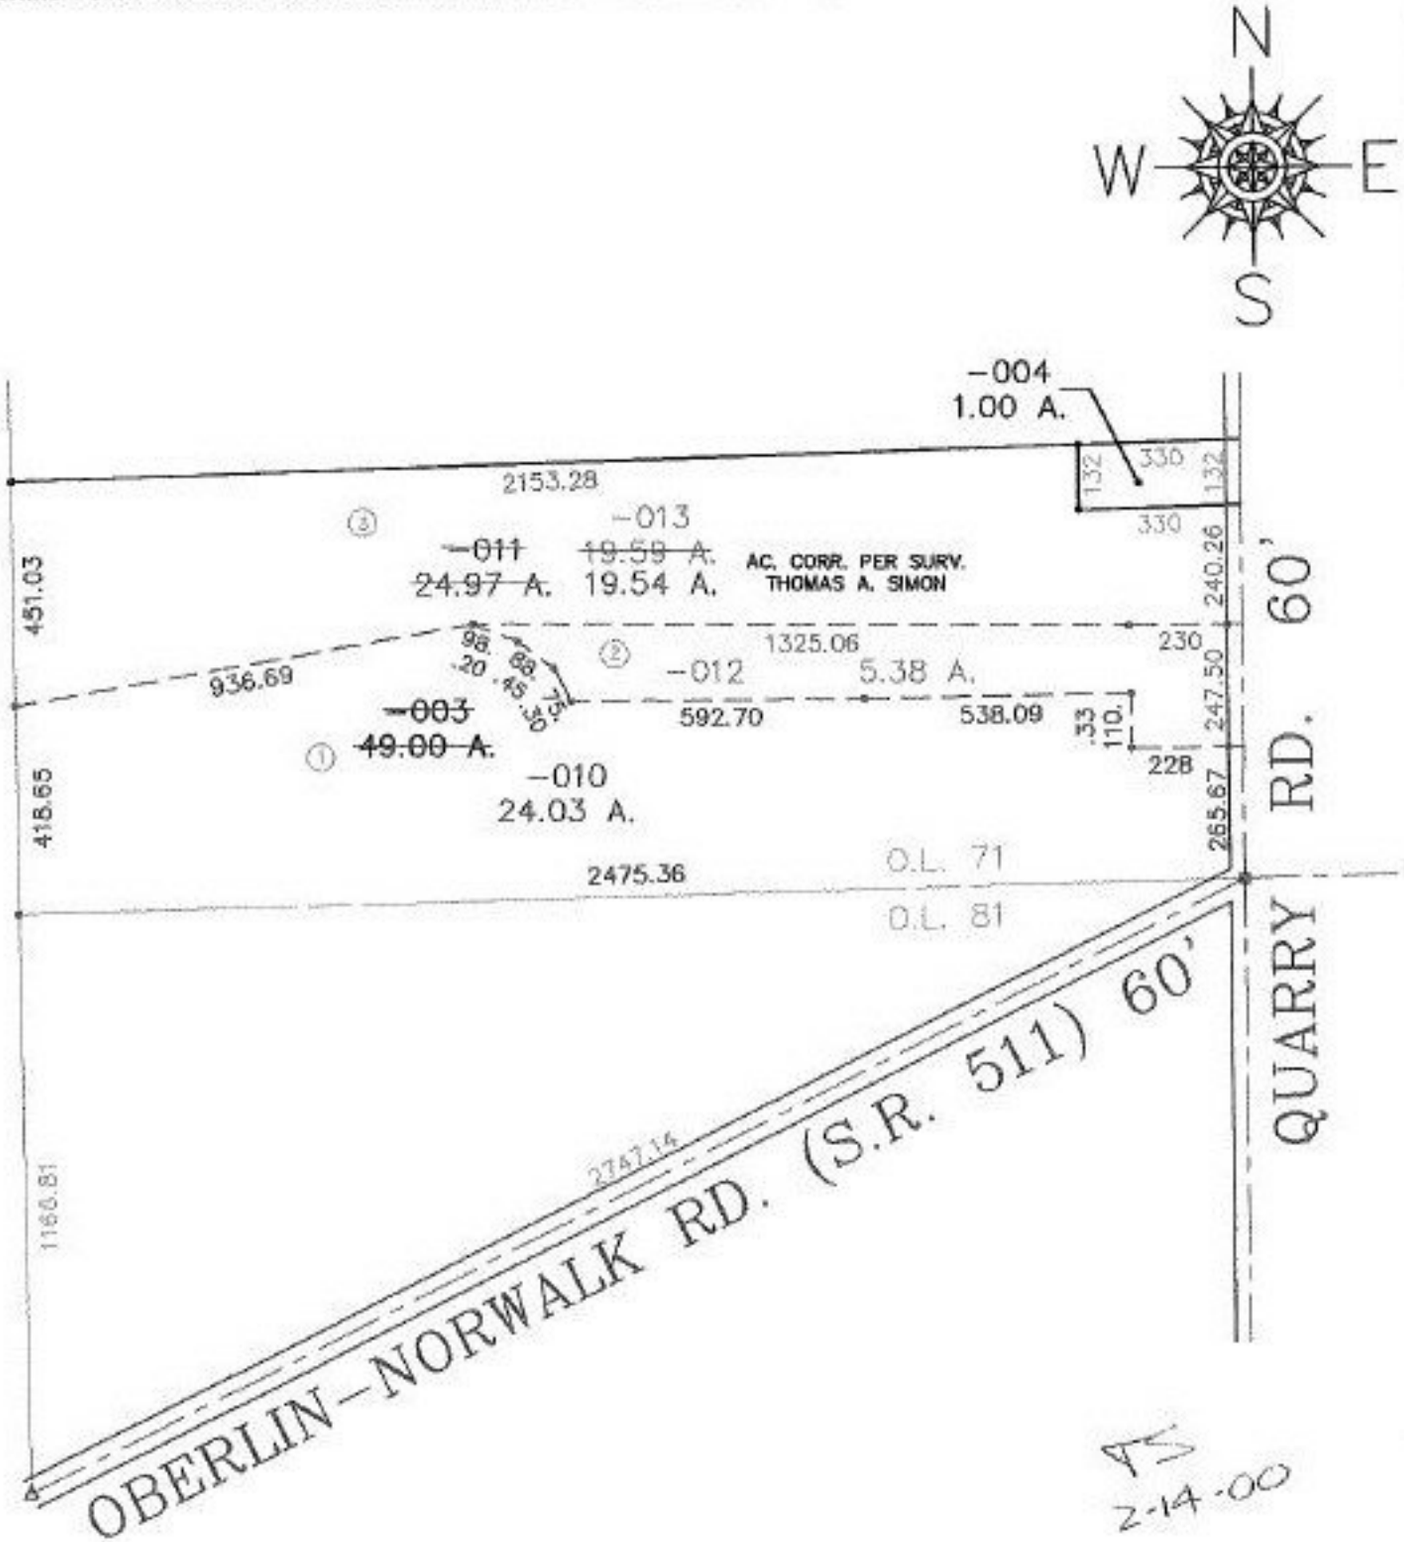

AS
2-14-00

SPLITS/DEEDS PROCESSED

LORAIN COUNTY TAX MAP DEPARTMENT
226 MIDDLE AVE. ELYRIA, OHIO

SURVEYED BY: THOMAS A. SIMON

CLOSURE: 0.01 : 10,000

MAP PAGE(S): 9-E

APPROVED BY: T. SPILLMAN DATE: 09/07/99

SCALE: 1"= 400 PRIOR INSTRUMENT: OR 1112/36