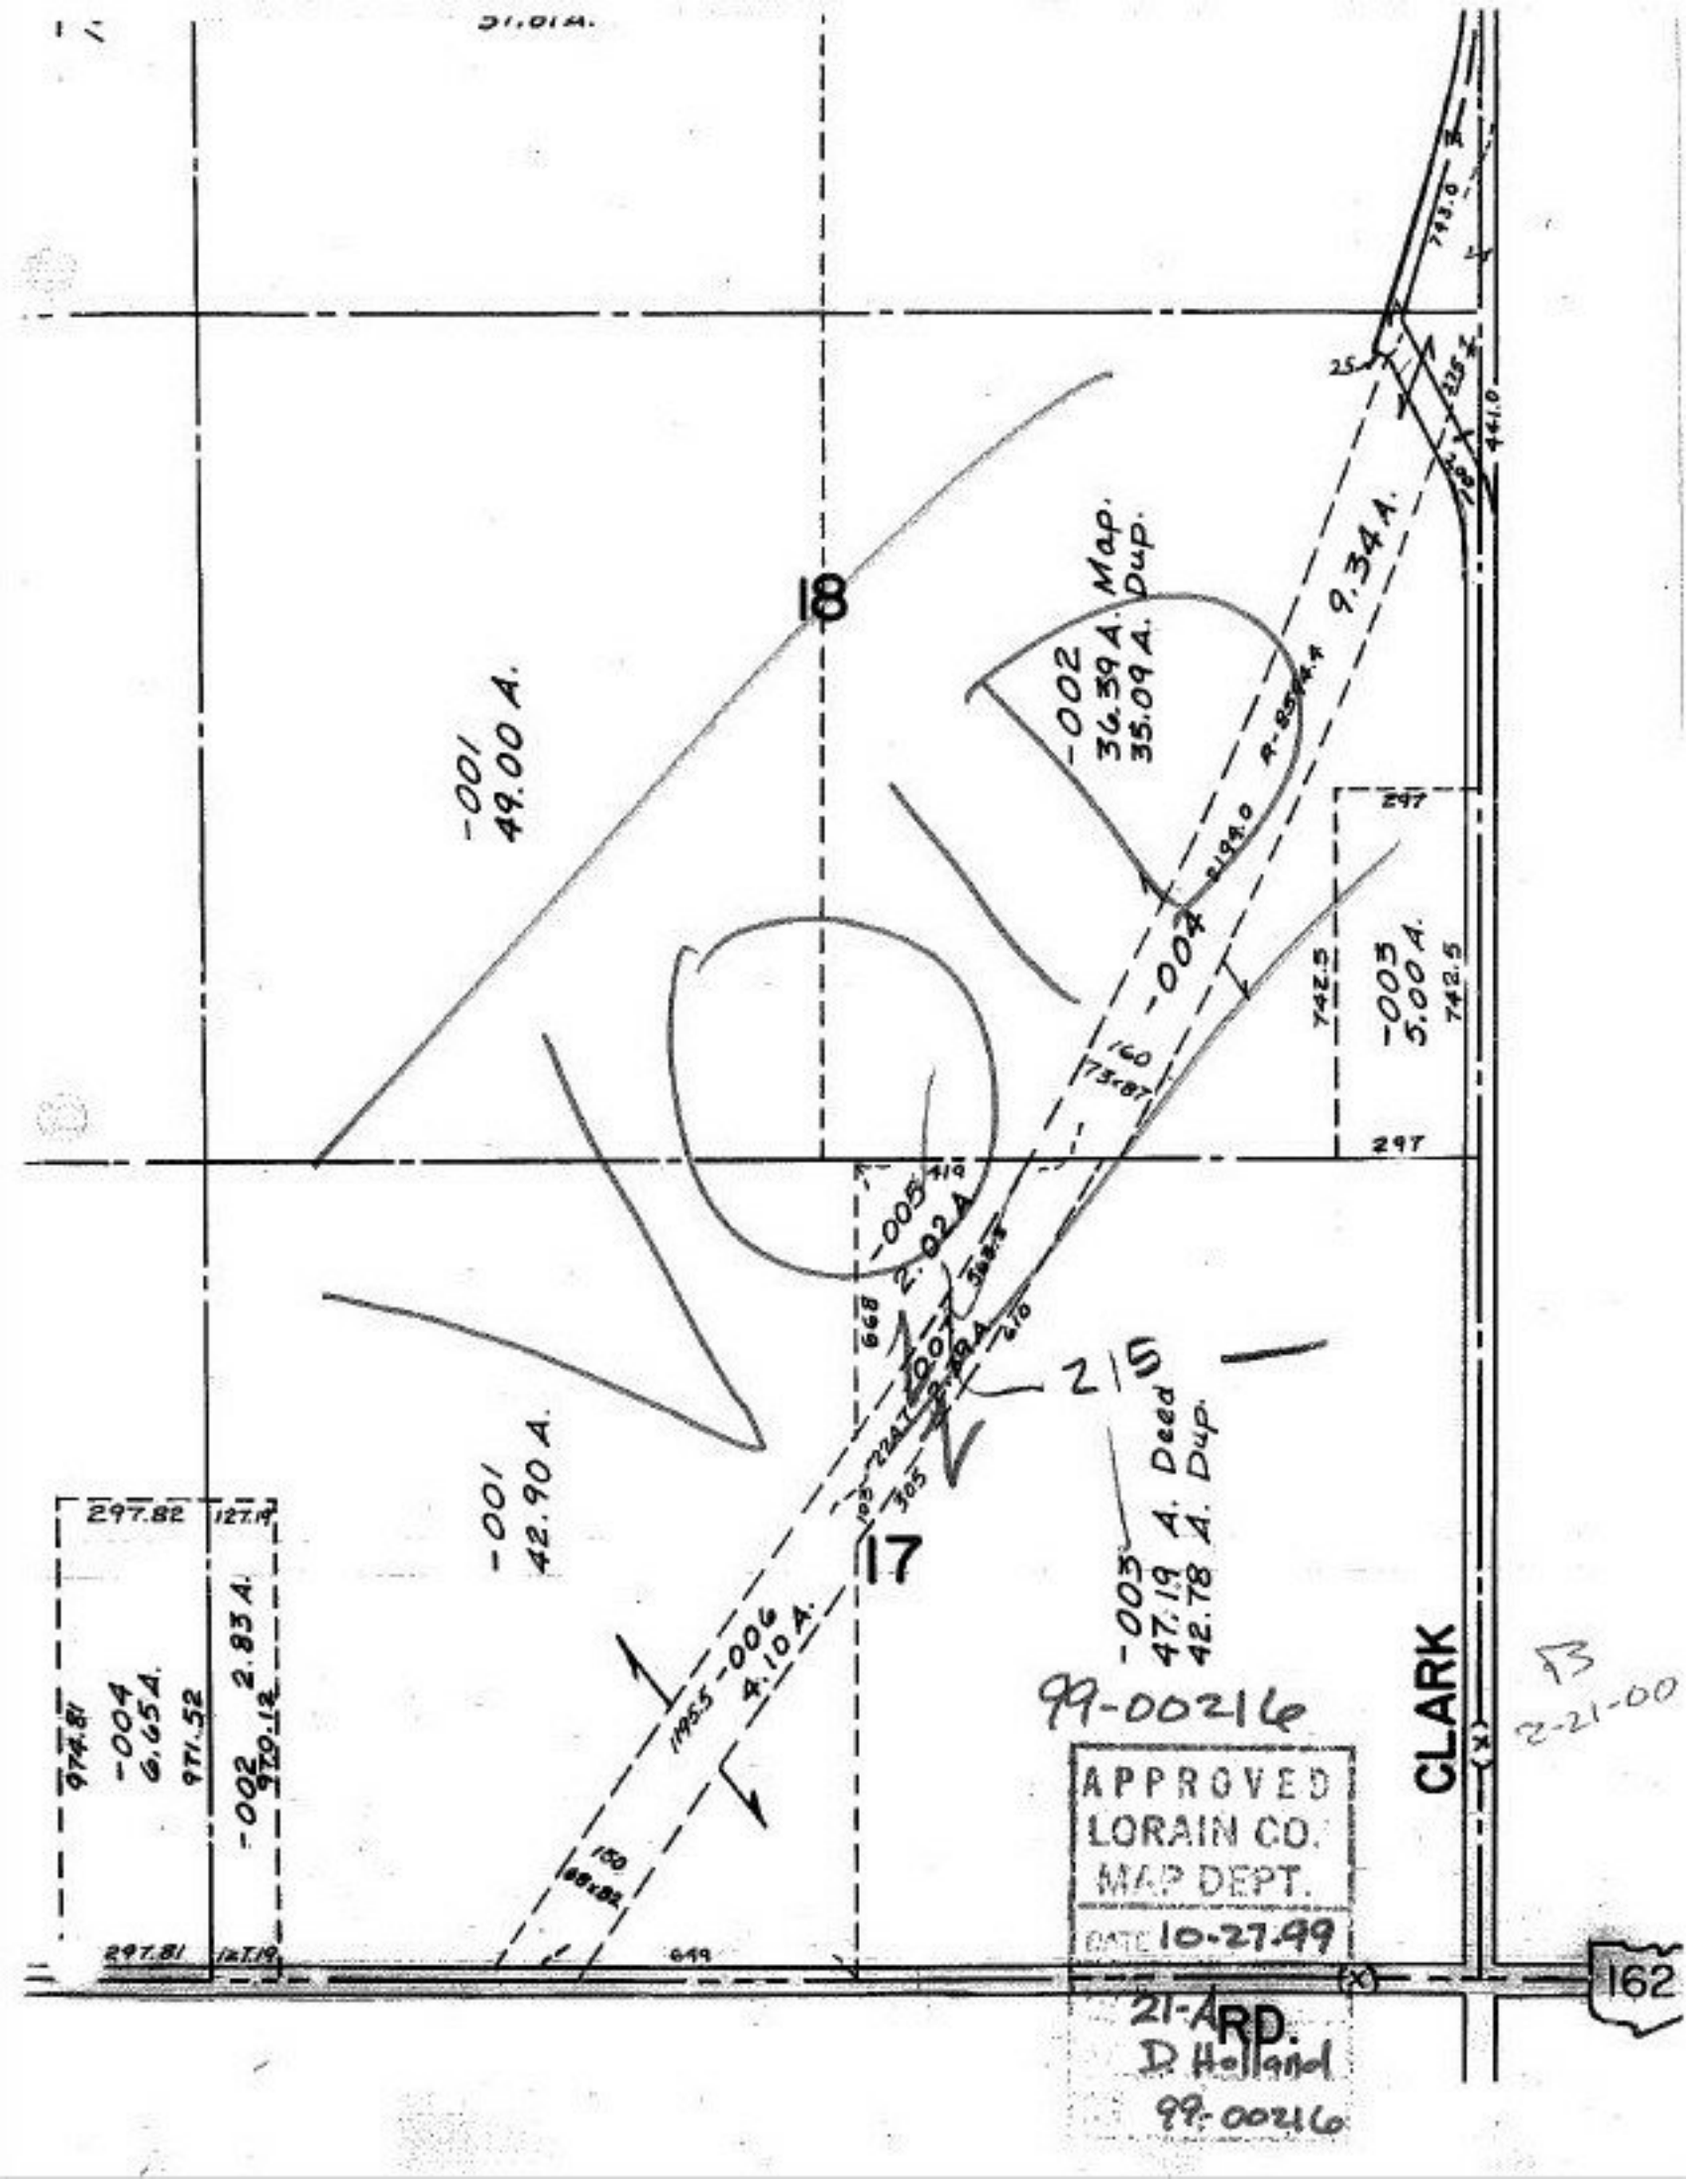
31.01A.
18
-001
49.00 A.
-002
36.39 A. Map.
35.09 A. Dup.
9.34 A.
-004
-003
5.00 A.
742.5
-005
2.02 A.
-001
42.90 A.
17
-003
47.19 A. Deed
42.78 A. Dup.
-006
4.10 A.
99-00216
APPROVED
LORAIN CO.
MAP DEPT.
DATE 10-27-99
CLARK
162
21-ARD.
D Holland
99-00216
2-21-00