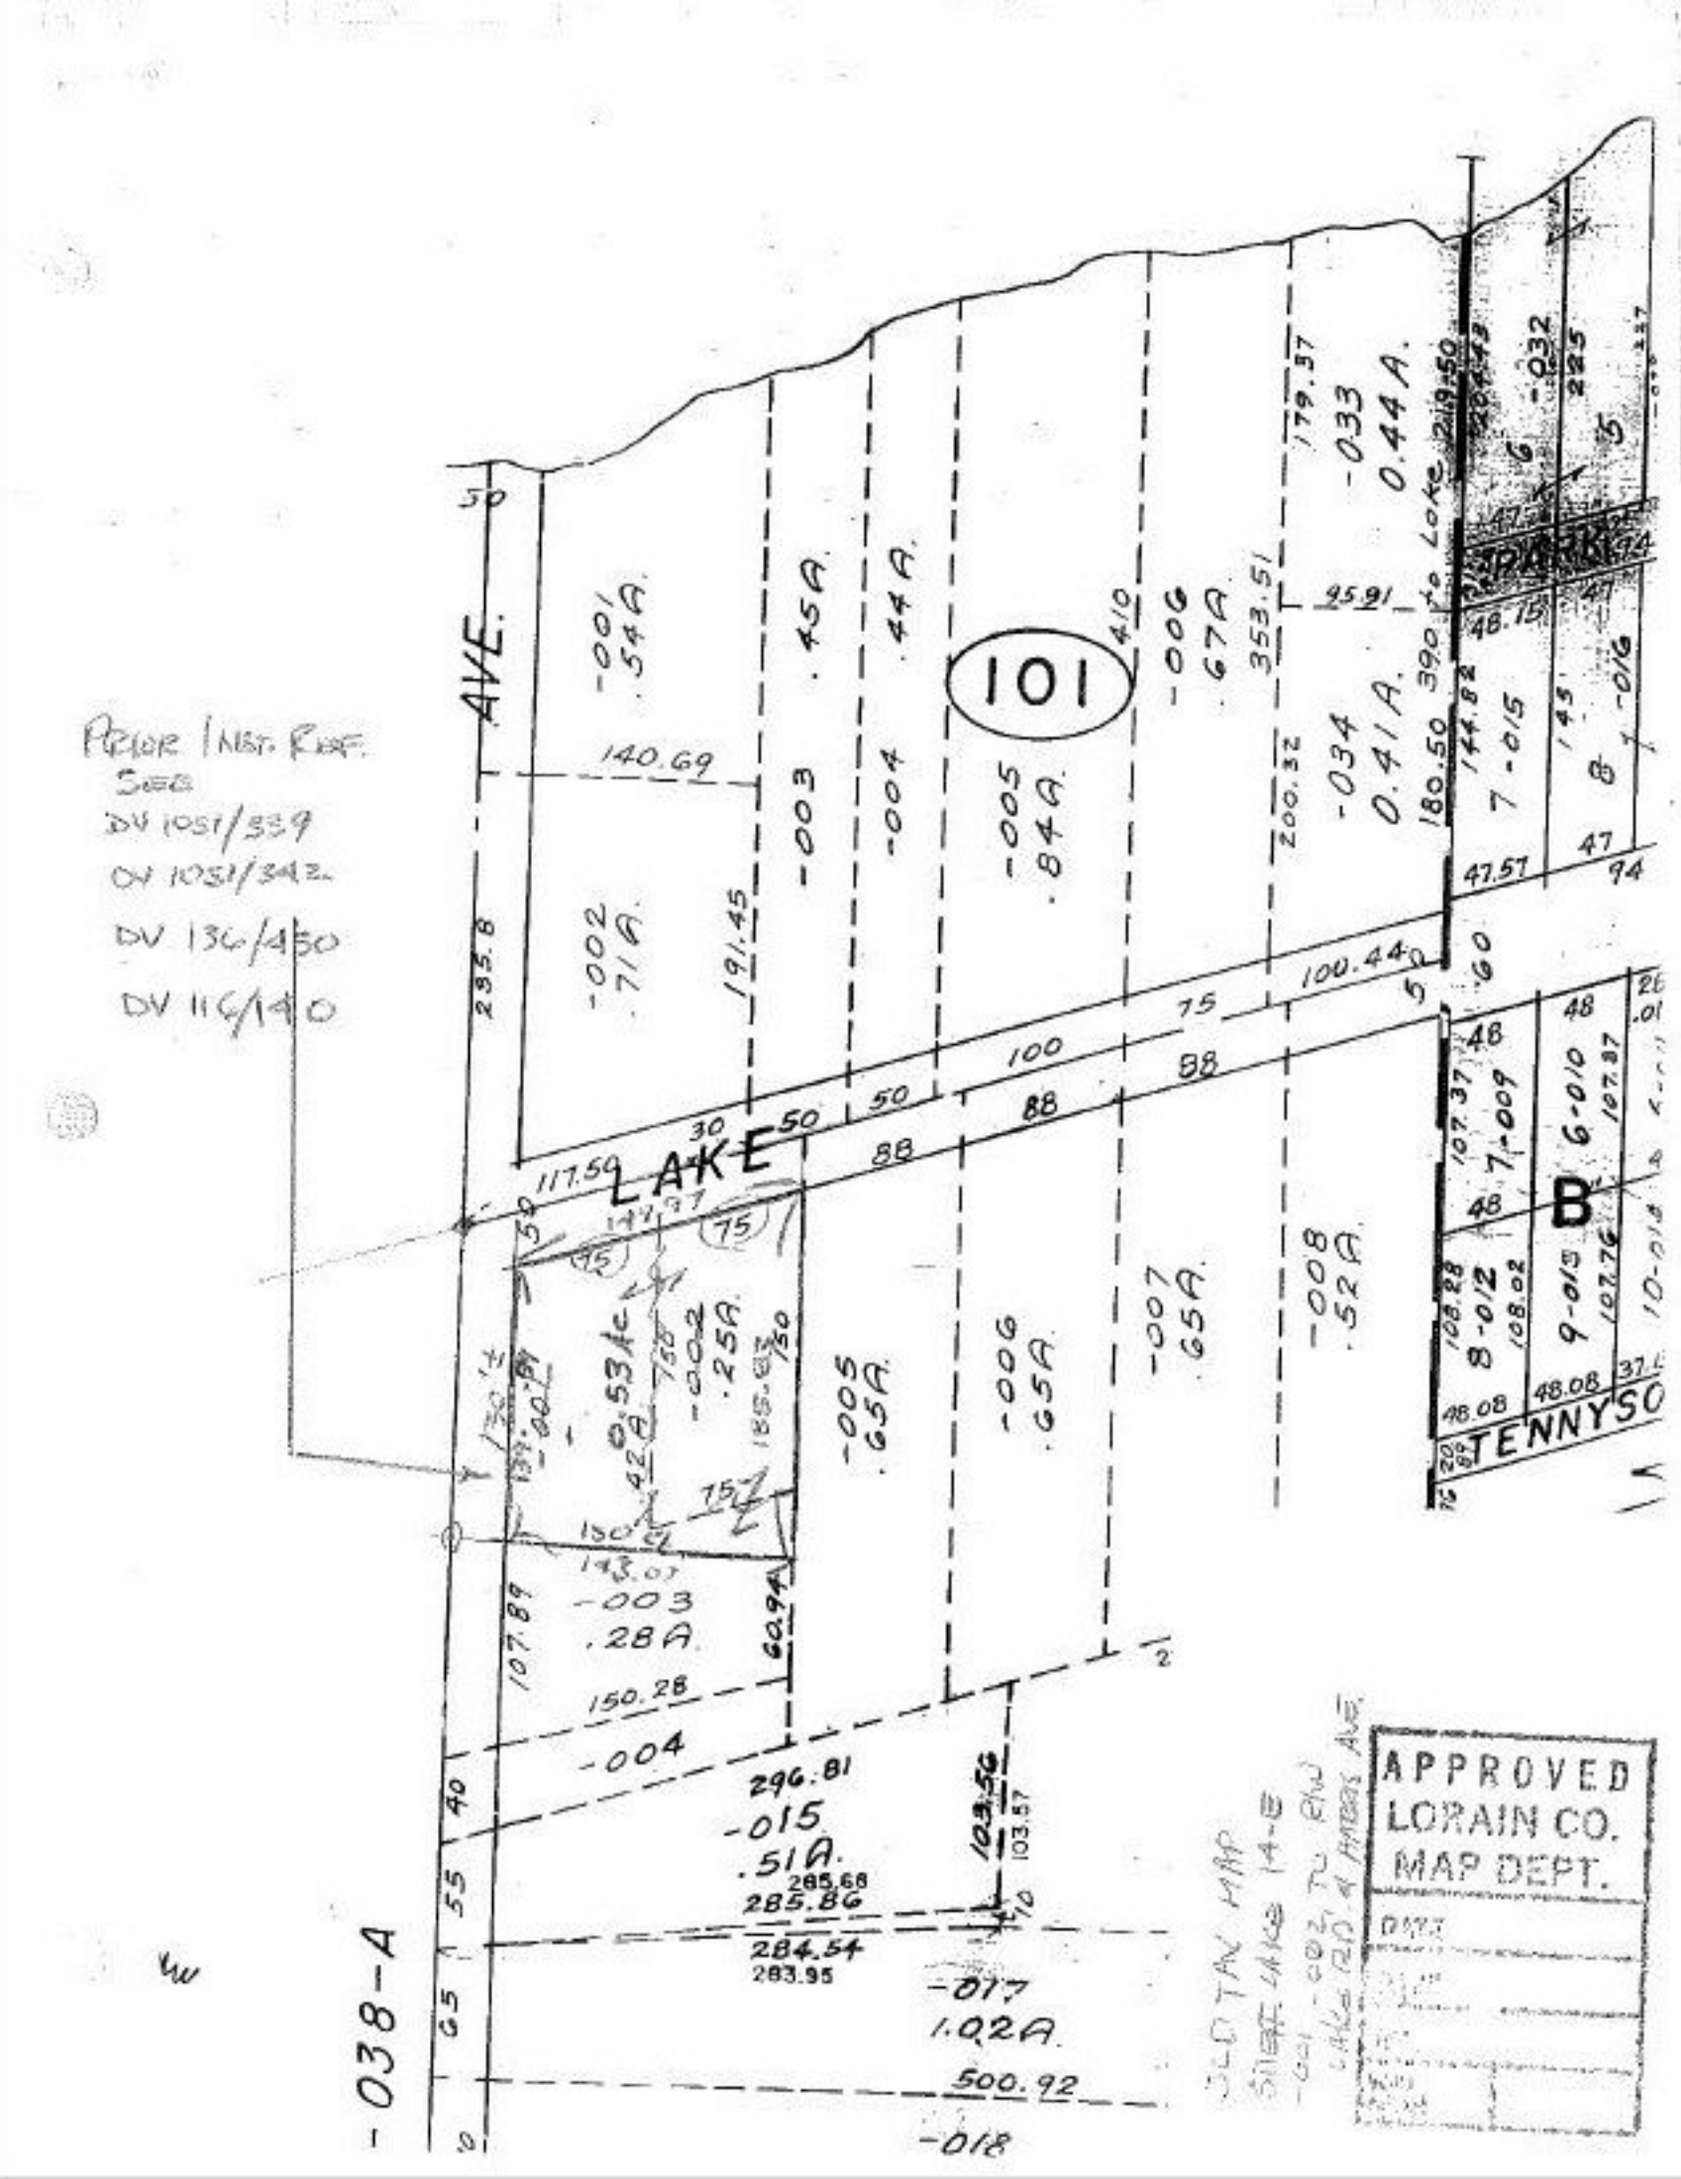
PRIOR INST. REF.
See
DV 1051/339
DV 1051/342
DV 130/450
DV 116/140
AVE.
LAKE
101
-001
.54A.
-002
.71A.
-003
.45A.
-004
.44A.
-005
.84A.
-006
.67A.
-007
.65A.
-008
.52A.
-033
0.44A.
-034
0.41A.
-032
-016
7-015
7-009
6-010
8-012
9-015
B
TENNYSO
0.53Ac
.25A.
-002
.28A.
-003
-004
.51A.
-015
1.02A.
-017
-018
-038-A
500.92
296.81
285.86
284.54
283.95
150.28
140.69
191.45
179.57
353.51
200.32
180.50
144.82
107.89
117.59
APPROVED
LORAIN CO.
MAP DEPT.
DATE