PARENT PARCEL: 04-00-023-105-078
CHILD PARCEL: 04-00-023-105-259 & -260
STARTING POINT: CL OF SCHWARTZ RD. & CL OF LEAR NAGLE RD.

NO. 00237

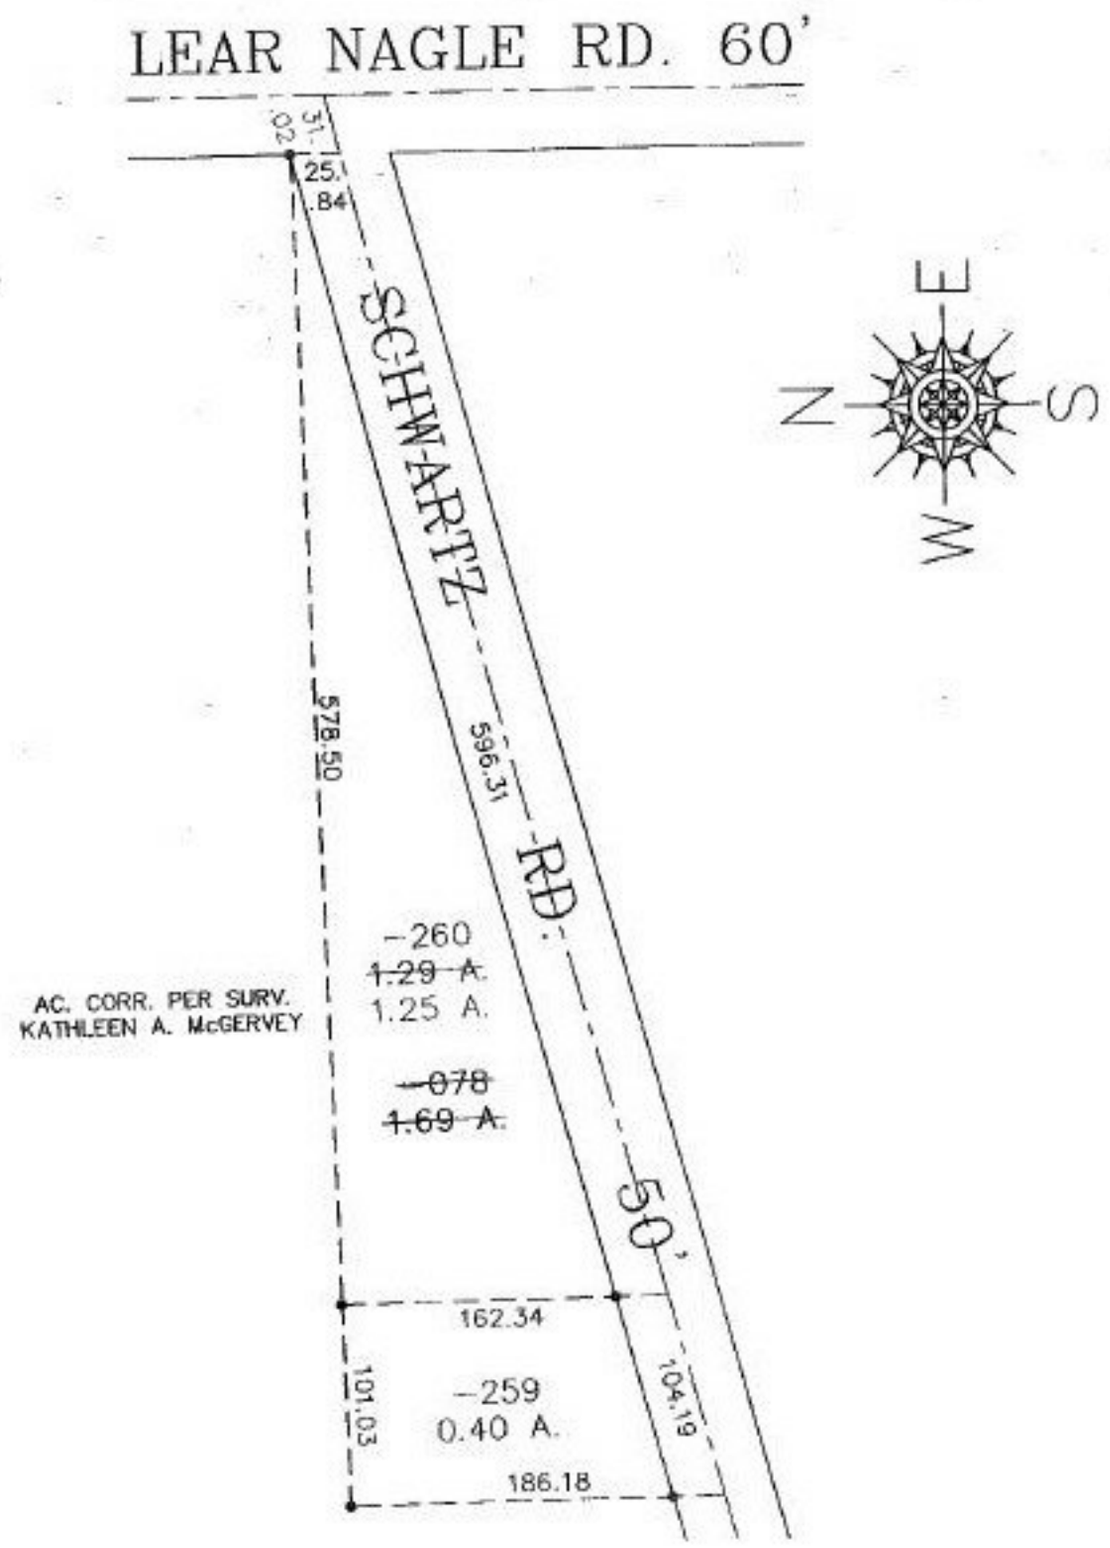

SPLITS/DEEDS PROCESSED

LORAIN COUNTY TAX MAP DEPARTMENT
226 MIDDLE AVE. ELYRIA, OHIO

SURVEYED BY: KATHLEEN A. McGERVEY
CLOSURE: 0.19 : 10,000
MAP PAGE(S): 04-00-023-H
APPROVED BY: T. SPILLMAN DATE: 10/13/99
SCALE: 1" = 100 PRIOR INSTRUMENT: OR 1050/490