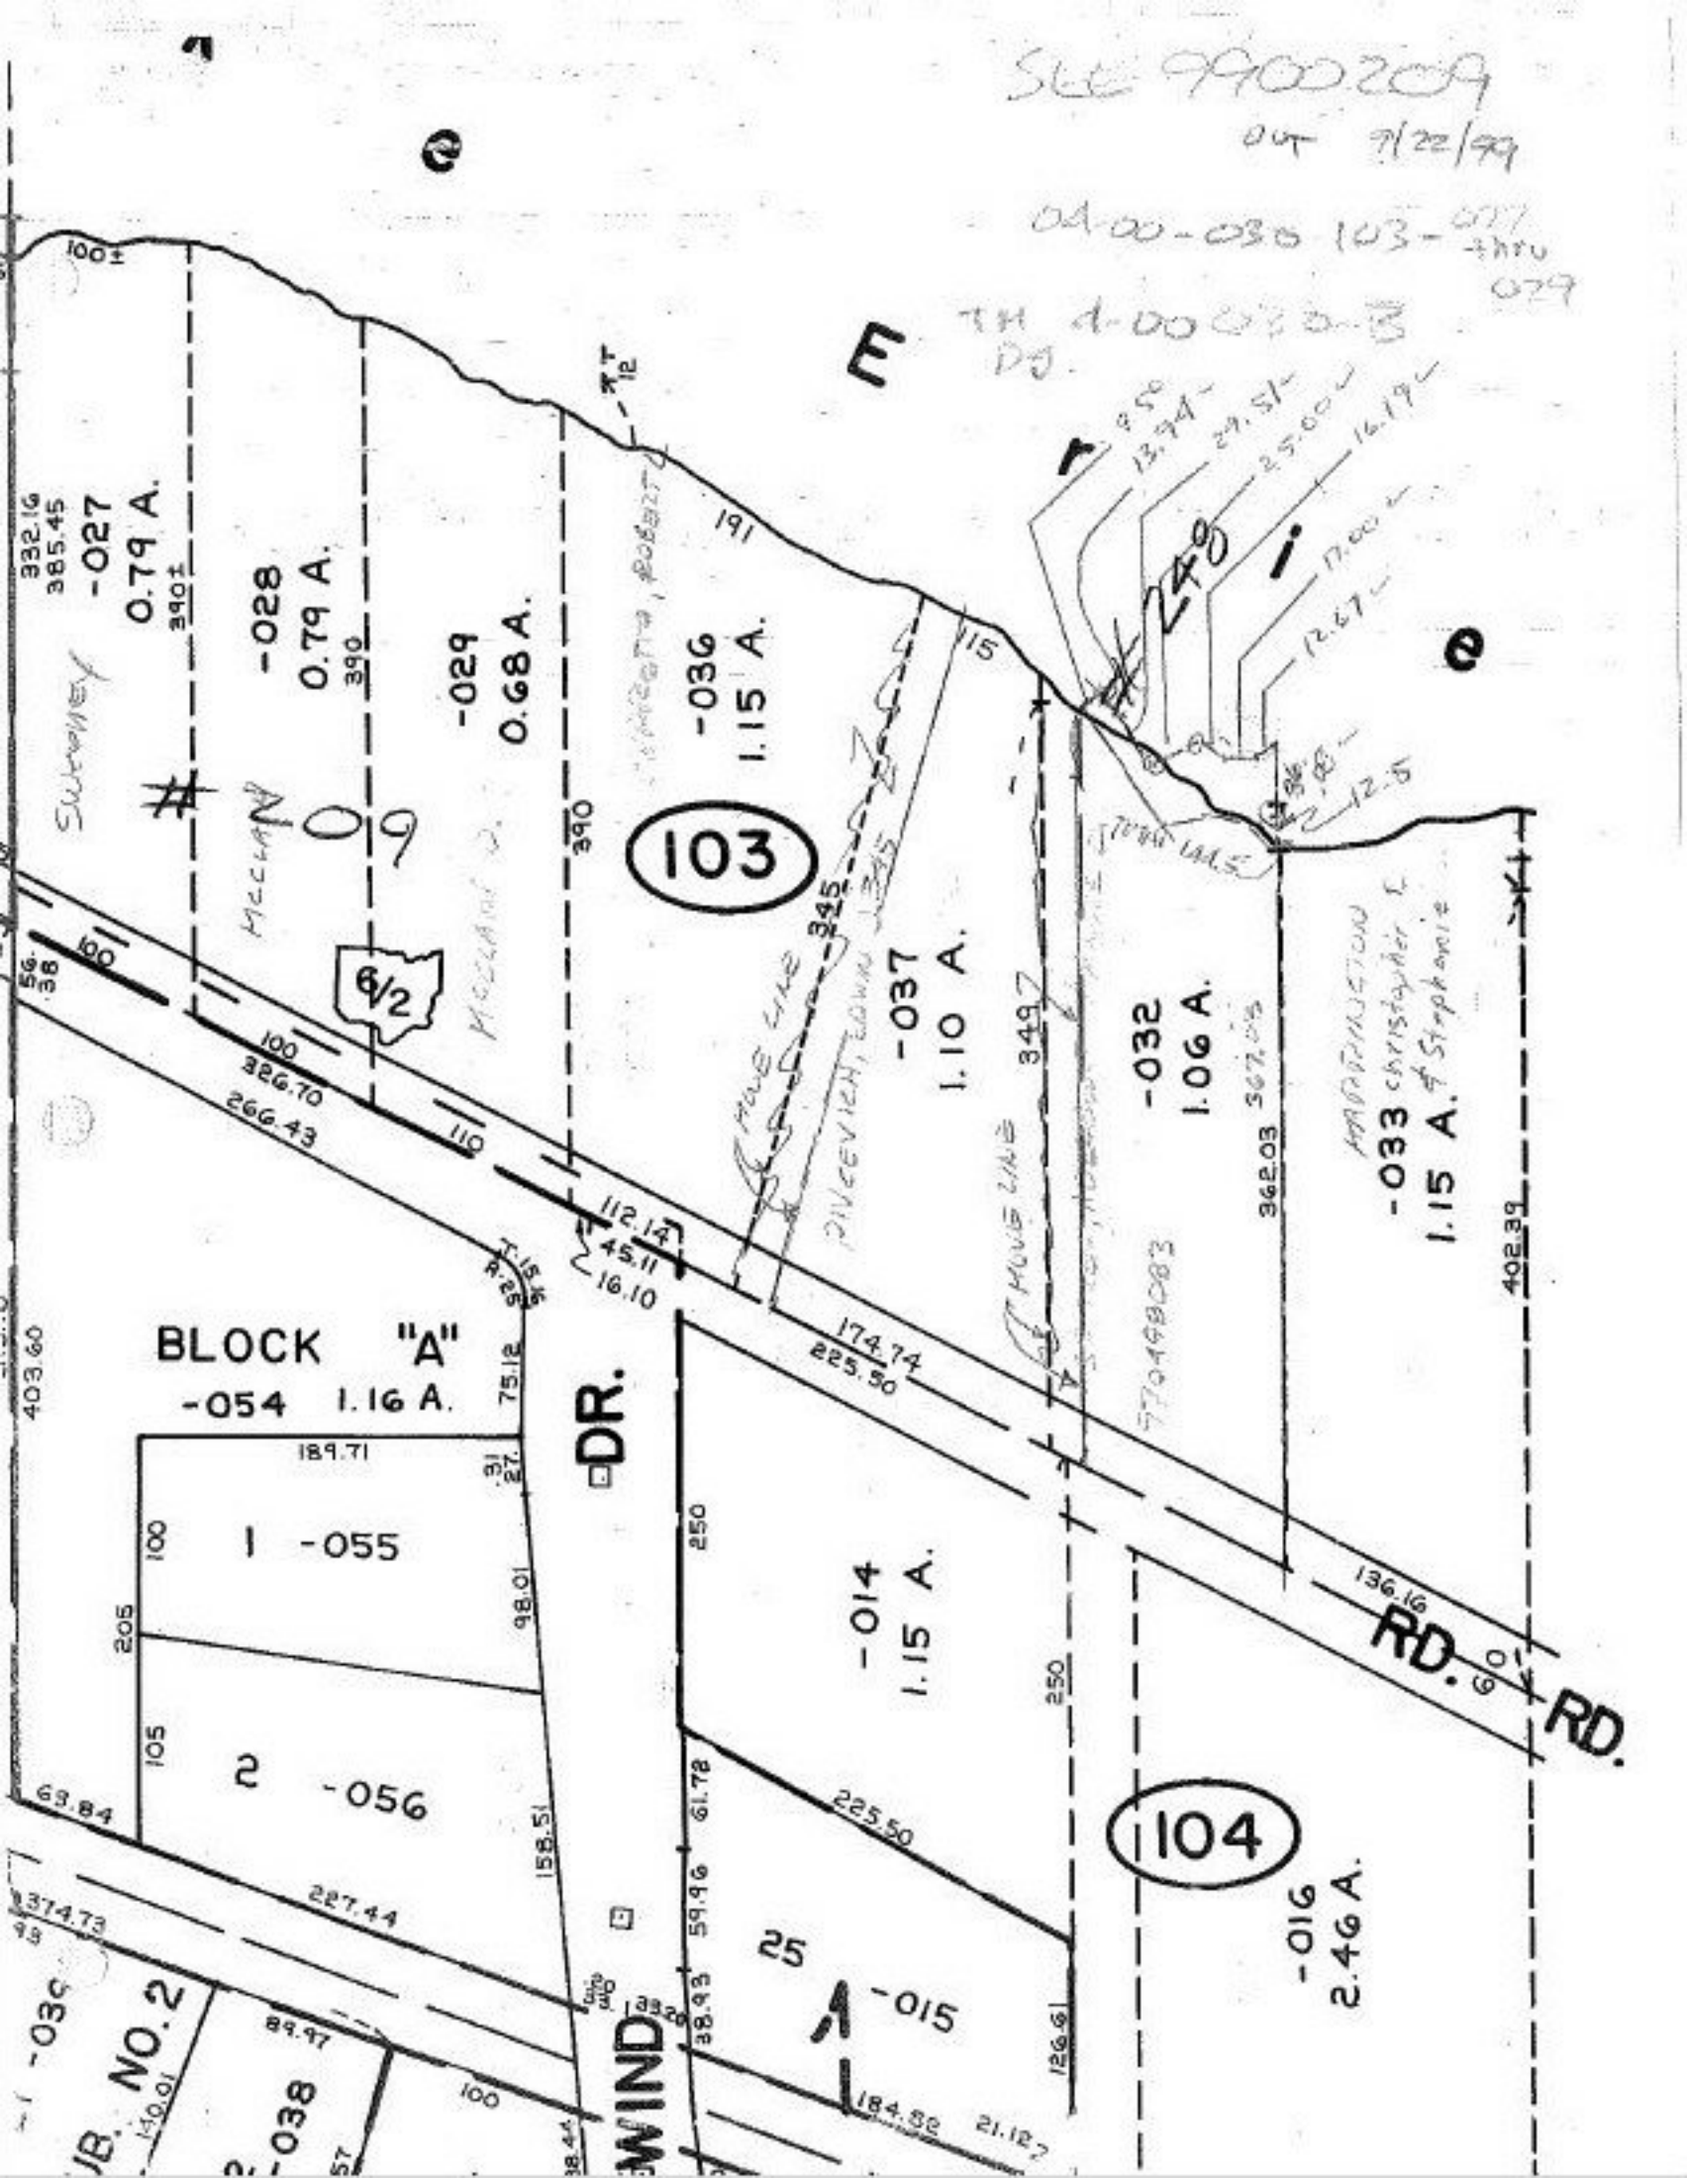

SLE 9900209
OUT 9/22/99
04-00-030 103-077 thru 079
TH 4-00 030-B
DJ.
E
r
i
e
e
-027
0.79 A.
-028
0.79 A.
-029
0.68 A.
-036
1.15 A.
103
-037
1.10 A.
-032
1.06 A.
-033
1.15 A.
6/2
BLOCK "A"
-054 1.16 A.
1 -055
2 -056
DR.
-014
1.15 A.
104
-016
2.46 A.
25
-015
RD.
RD.
WIND
NO. 2
-038