PARENT PARCEL: 21-05-038-000-007
CHILD PARCEL: 21-05-038-000-008, 009, 010
STARTING POINT: C/Ls GRIGGS ROAD & BAKER ROAD

NO. 00249

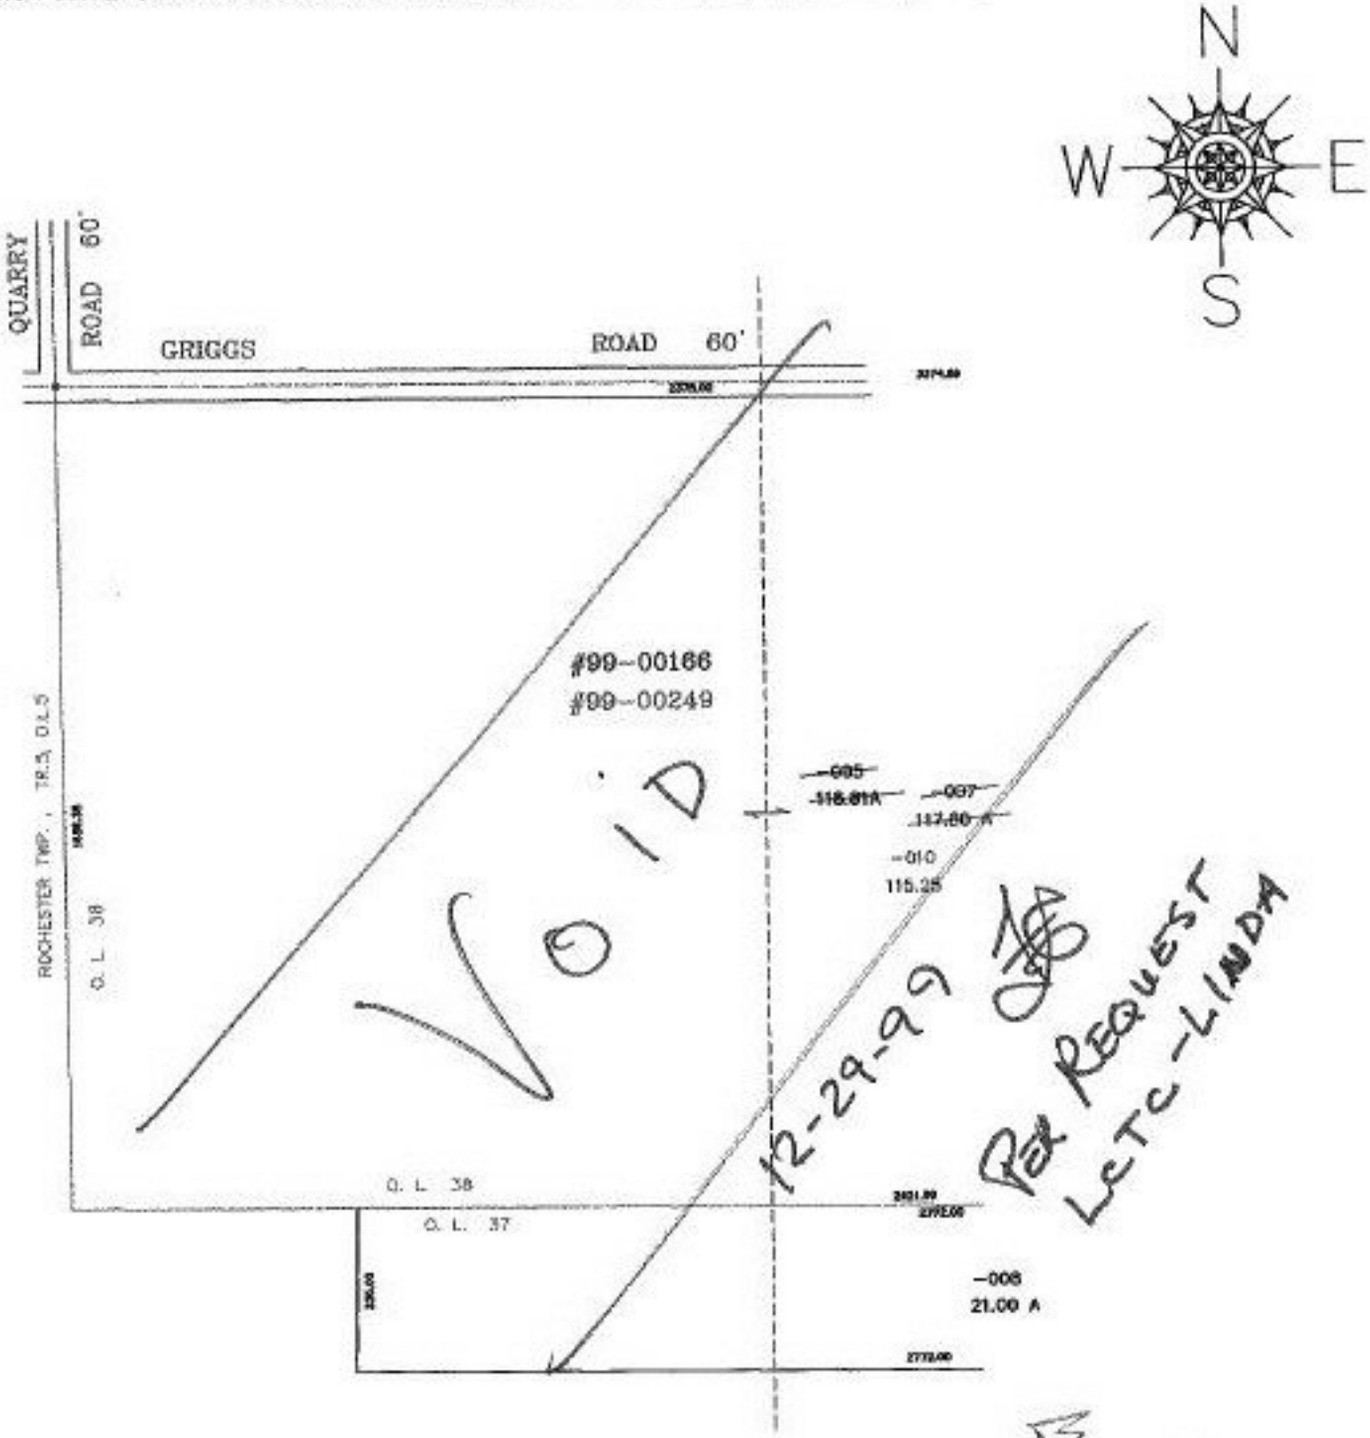

SHEET (1) OF (2)

SPLITS/DEEDS PROCESSED
LORAIN COUNTY TAX MAP DEPARTMENT
226 MIDDLE AVE. ELYRIA, OHIO

SURVEYED BY: DANE A HAPONEK
CLOSURE: 0.08 / 10,000
MAP PAGE(S): 21-A
APPROVED BY: F. COLBERT DATE: 11-29-99
SCALE: 1"= 400 PRIOR INSTRUMENT: 990628883