PARENT PARCEL: 05-00-054-000-043

CHILD PARCEL: 05-00-054-000-045 & -046

STARTING POINT: CL OF OBERLIN RD. & SOUTH LINE OF O.L. 54

NO. 00250

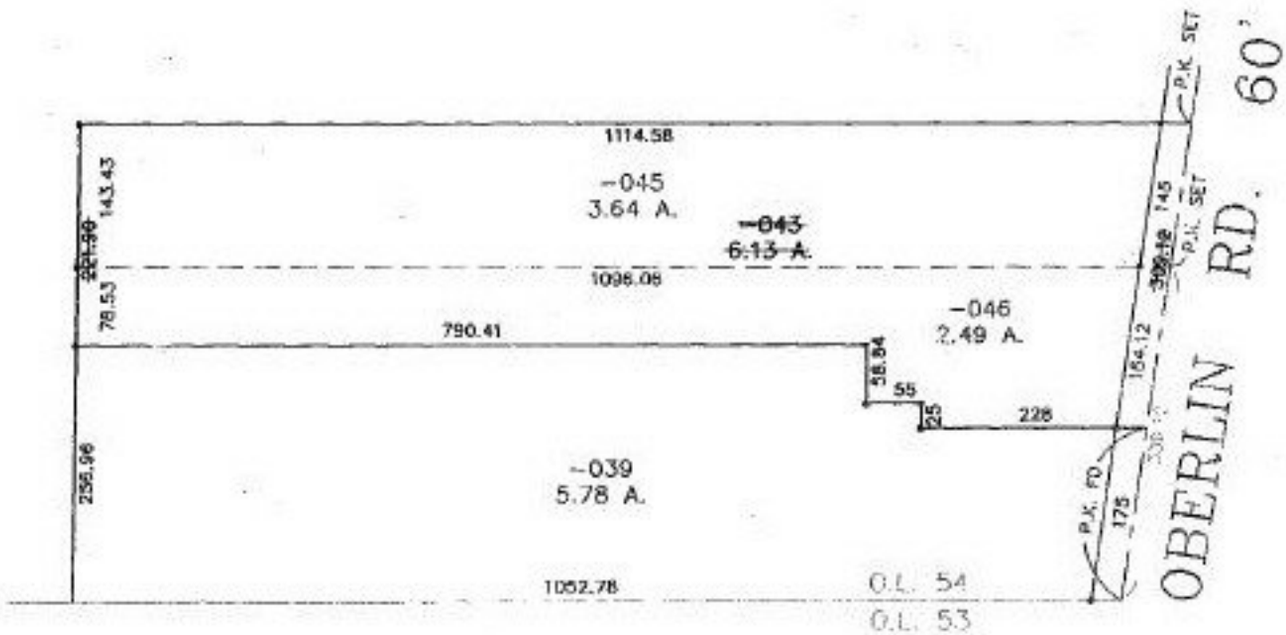

SPLITS/DEEDS PROCESSED

LORAIN COUNTY TAX MAP DEPARTMENT

226 MIDDLE AVE. ELYRIA, OHIO

SURVEYED BY: CHARLE P. WARYU

CLOSURE: 0.15 : 10,000

MAP PAGE(S): 5-G

APPROVED BY: T. SPILLMAN DATE: 10/25/99

SCALE: 1" = 200 PRIOR INSTRUMENT: OR 1216/336