PARENT PARCEL: 04-00-015-103-007, 038, 040, 037, 009, 010

CHILD PARCEL: 04-00-015-103-044, 045, 046, 047, 048, 049, 050, 051, 052, 053

STARTING POINT: C/Ls OF DETROIT ROAD & CENTER ROAD

NO. 00251

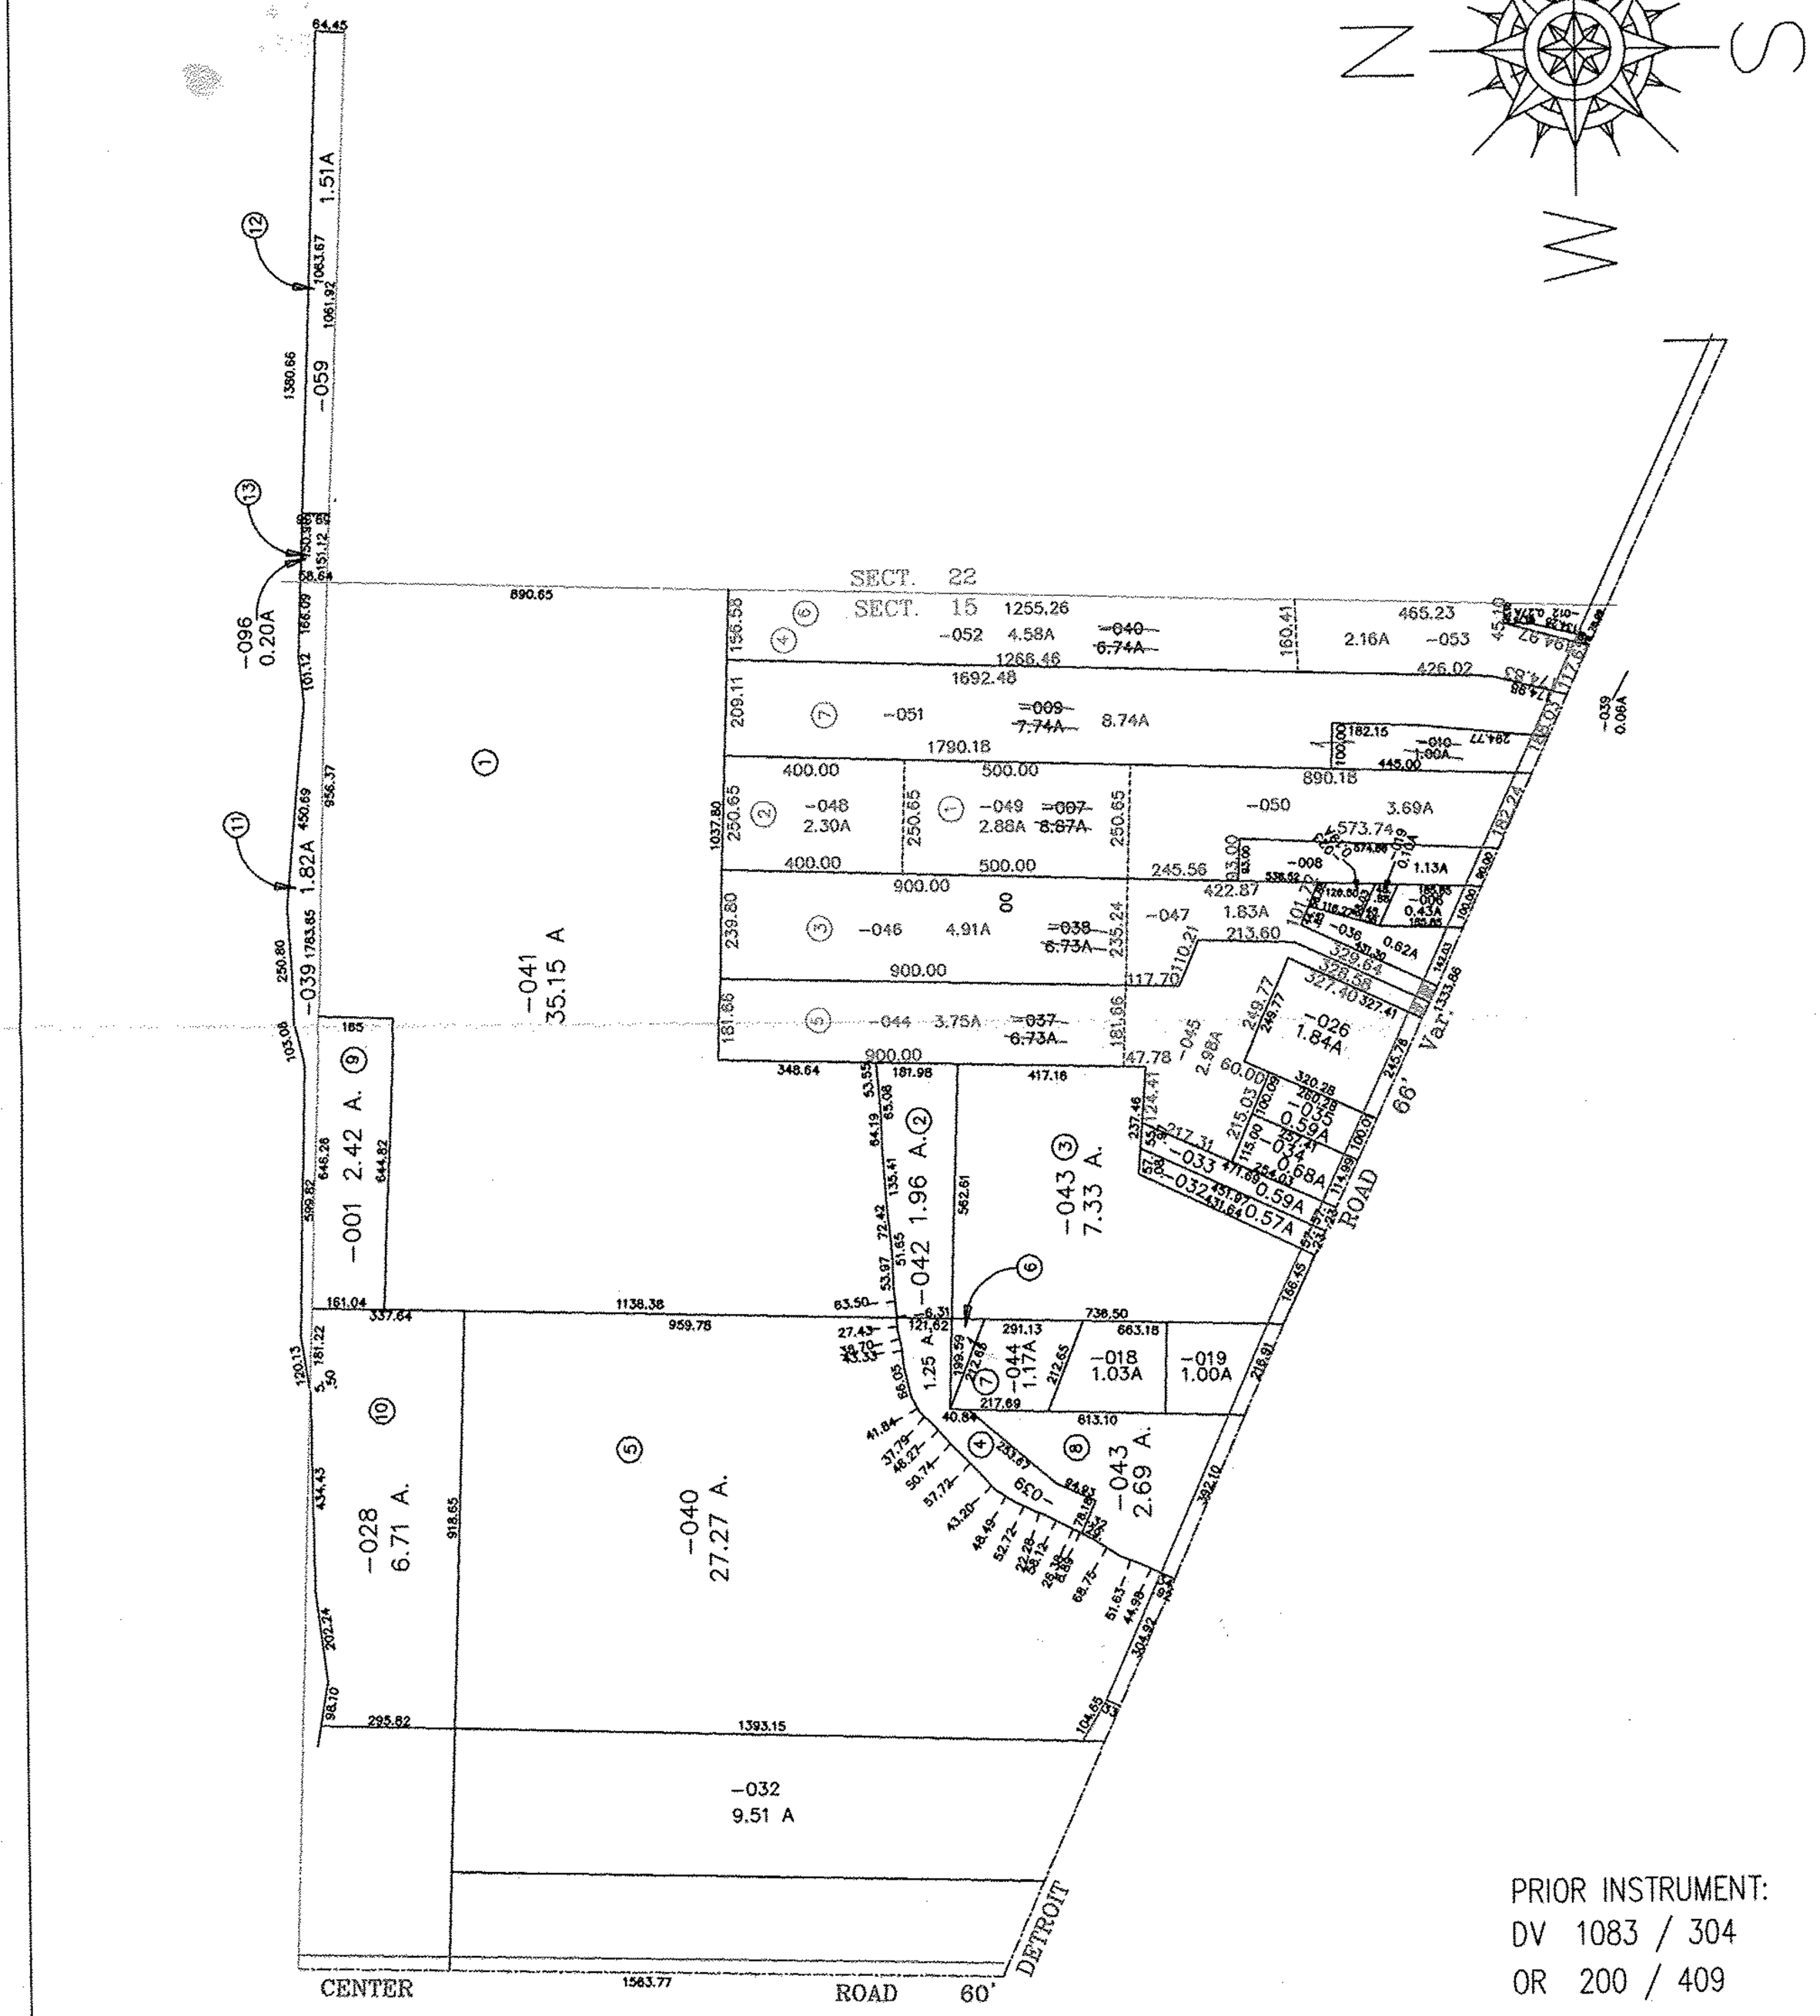

PRIOR INSTRUMENT:
DV 1083 / 304
OR 200 / 409
OR 45 / 887
OR 63 / 129

SPLITS/DEEDS PROCESSED

LORAIN COUNTY TAX MAP DEPARTMENT
226 MIDDLE AVE. ELYRIA, OHIO

SURVEYED BY: THOMAS J NEFF JR.
CLOSURE: 0.03 / 10,000
MAP PAGE(S): 4-00-015-D
APPROVED BY: F. COLBERT DATE: 10-28-99
SCALE: 1"= 400'