PARENT PARCEL: 09-00-021-000-012, -014, & -038

CHILD PARCEL: 09-00-021-000-039 THRU -043

STARTING POINT: MON. BOX , CL OF QUARRY RD. & CL OF RUSSIA RD.

NO. 00258

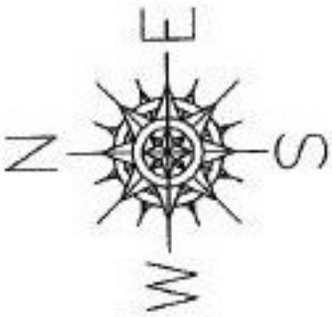

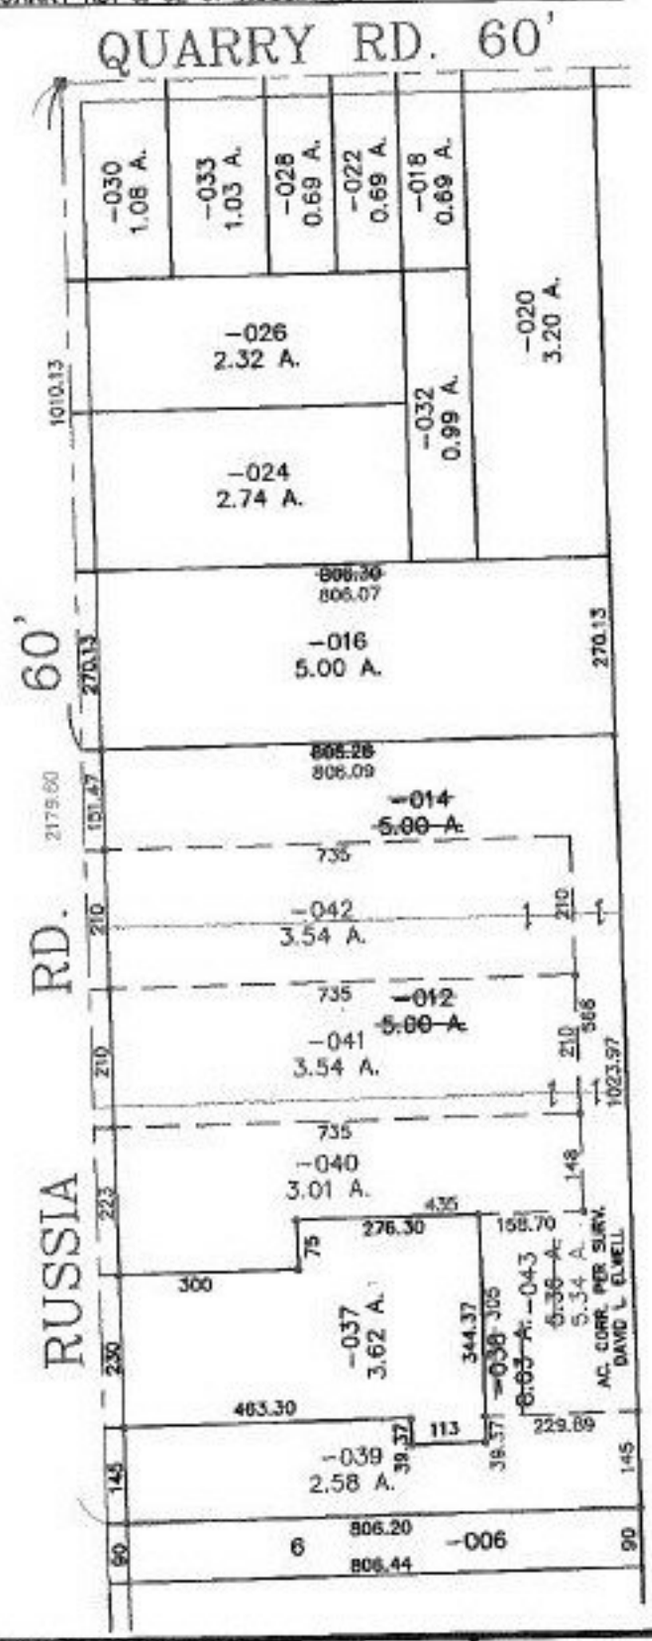

PRIOR INSTRUMENT: 990621535

PRIOR INSTRUMENT: 990621795

2-14-00

SPLITS/DEEDS PROCESSED

LORAIN COUNTY TAX MAP DEPARTMENT

226 MIDDLE AVE. ELYRIA, OHIO

SURVEYED BY: DAVID L. ELWELL

CLOSURE: 0.02 : 10,000

MAP PAGE(S): 09-00-021-A & B

APPROVED BY: T. SPILLMAN DATE: 11/24/99

SCALE: 1" = 300