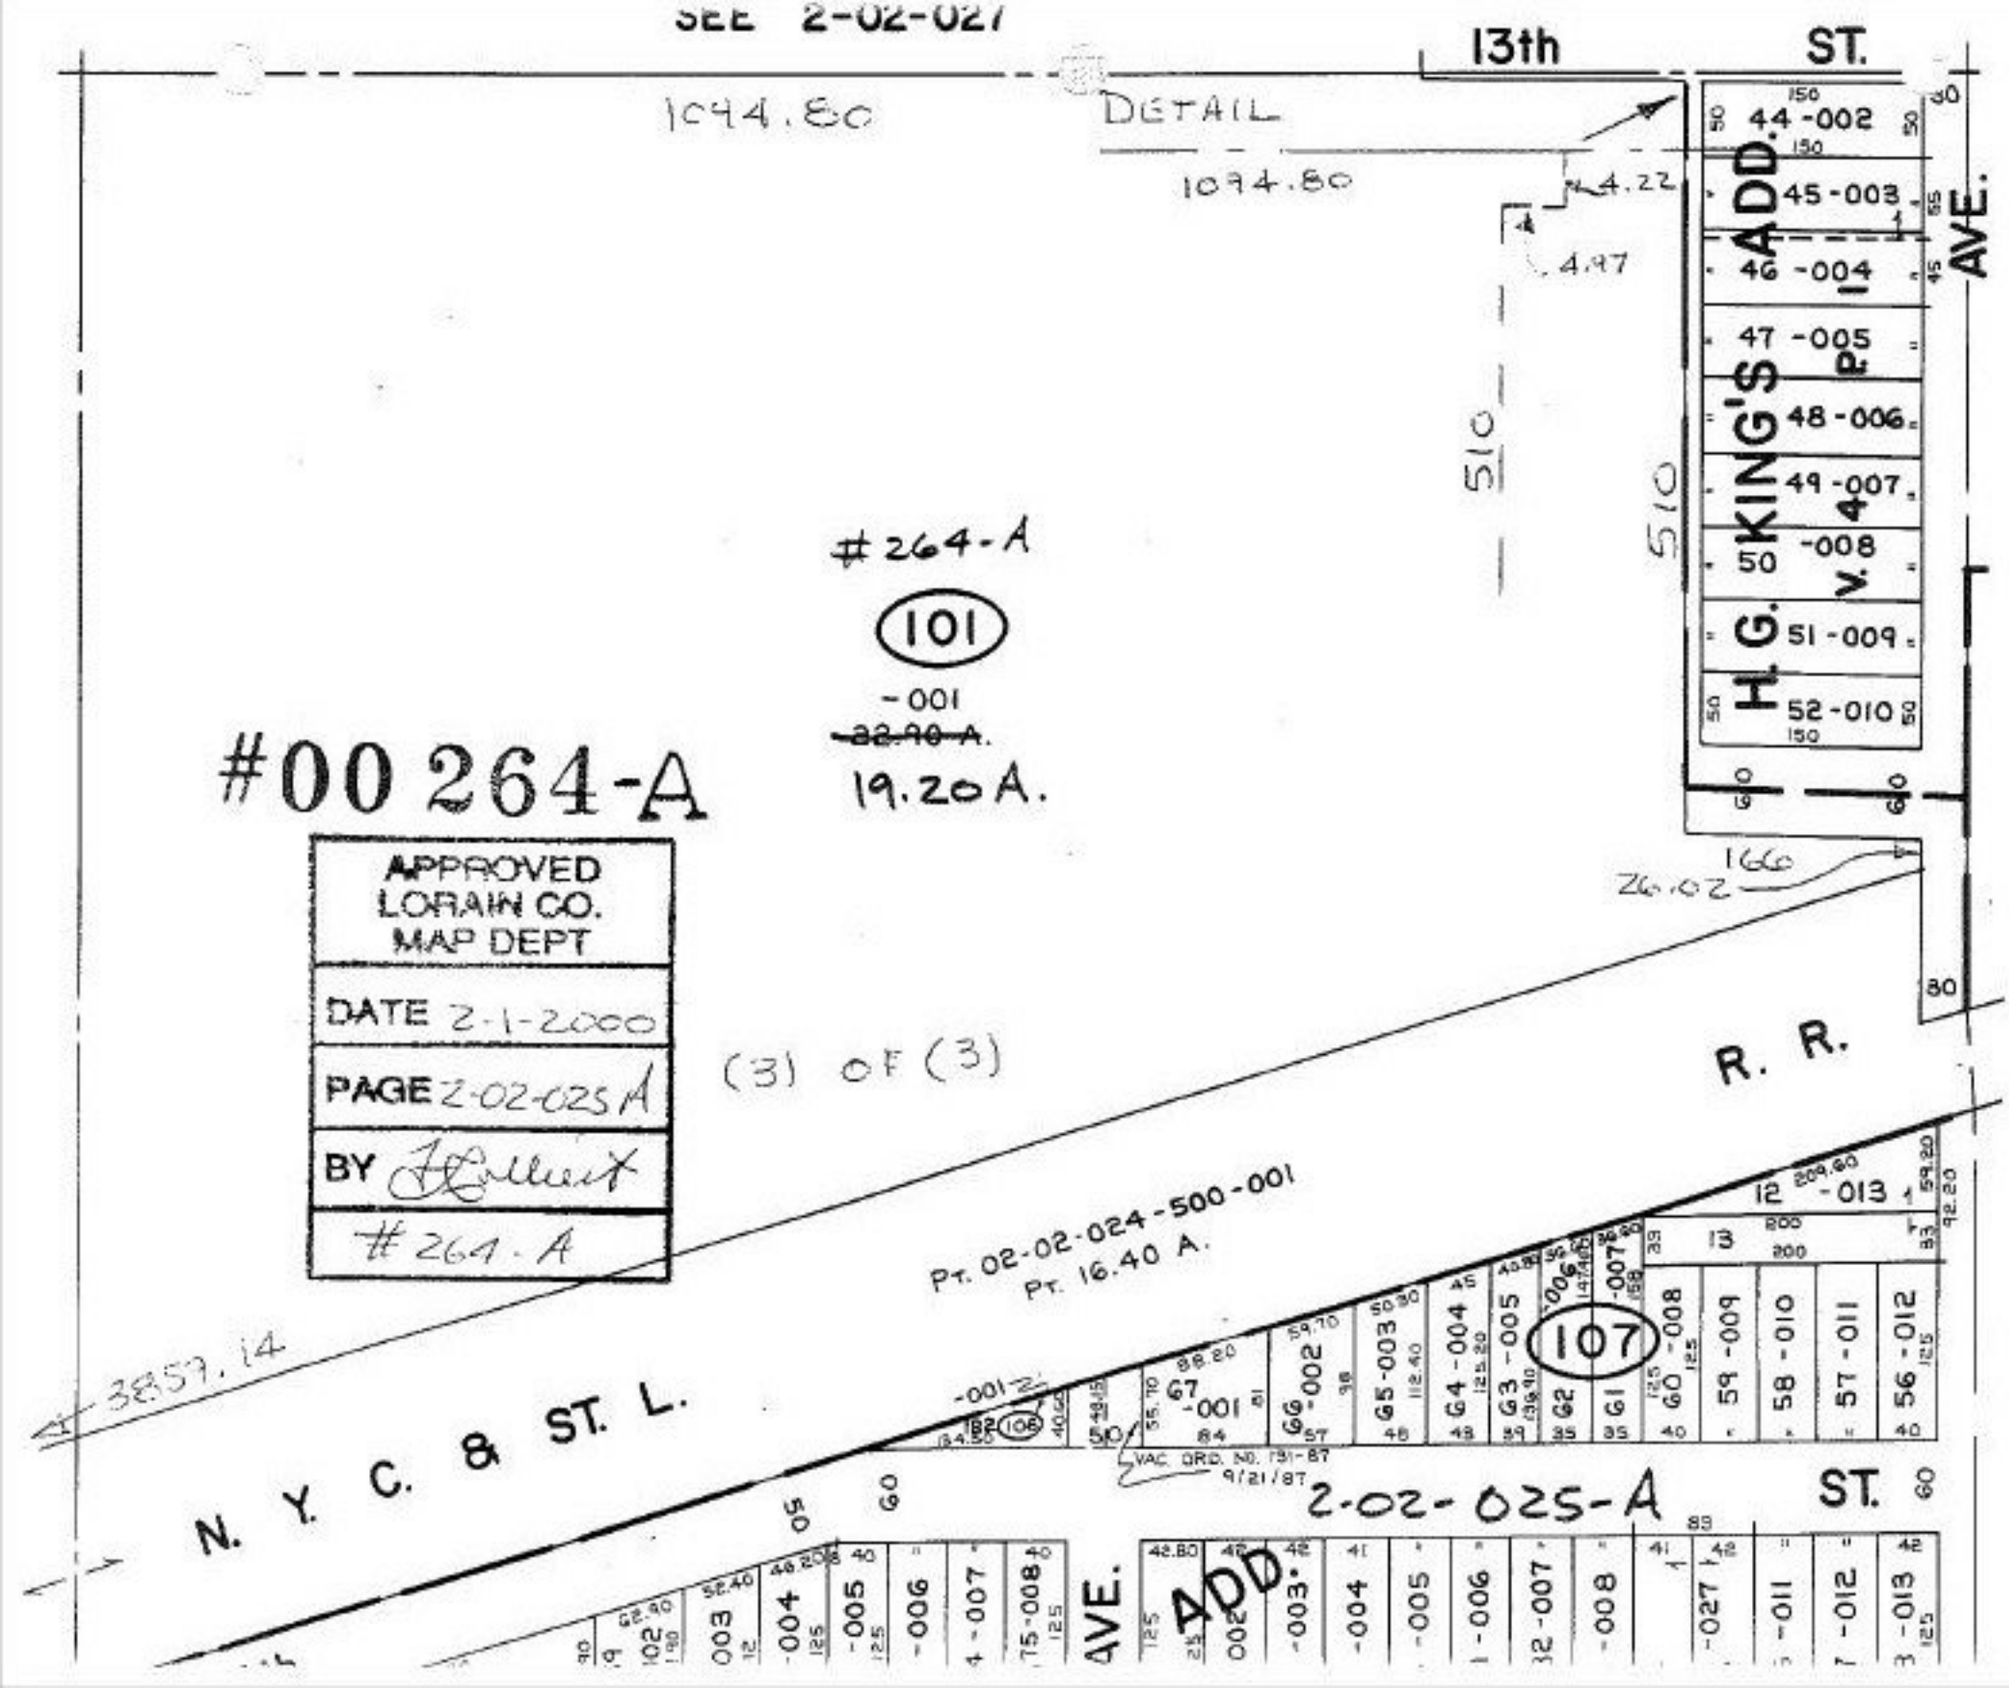
SEE 2-02-027
13th ST.
1094.80
DETAIL
1094.80
4.22
4.97
510
510
H. G. KING'S 4TH ADD.
44-002
45-003
46-004
47-005
48-006
49-007
50-008
51-009
52-010
AVE.
#264-A
101
-001
~~22.90 A.~~
19.20 A.
#00 264-A
APPROVED
LORAIN CO.
MAP DEPT
DATE 2-1-2000
PAGE 2-02-025A
BY
#264-A
(3) OF (3)
166
26.02
80
R. R.
Pt. 02-02-024-500-001
Pt. 16.40 A.
12 -013
107
60-008
59-009
58-010
57-011
56-012
G5-003
G4-004
G3-005
G2
G1
67-001
66-002
-001
106
VAC. ORD. NO. 731-87
9/21/87
2-02-025-A
ST.
3857.14
N. Y. C. & ST. L.
AVE.
ADD