PARENT PARCEL: 02-03-006-105-016 & -020
CHILD PARCEL: 02-03-006-105-024
STARTING POINT: BEING S\L 32 IN OAKHILL FARMS SUB. NO. 2

NO. 00268-X

COMBINATION

~~02-03-006-105-016~~
~~93.81 X 134~~

~~02-03-006-105-020~~
~~45.23 X 100.97~~

02-03-006-105-024
139.04 X 134.19

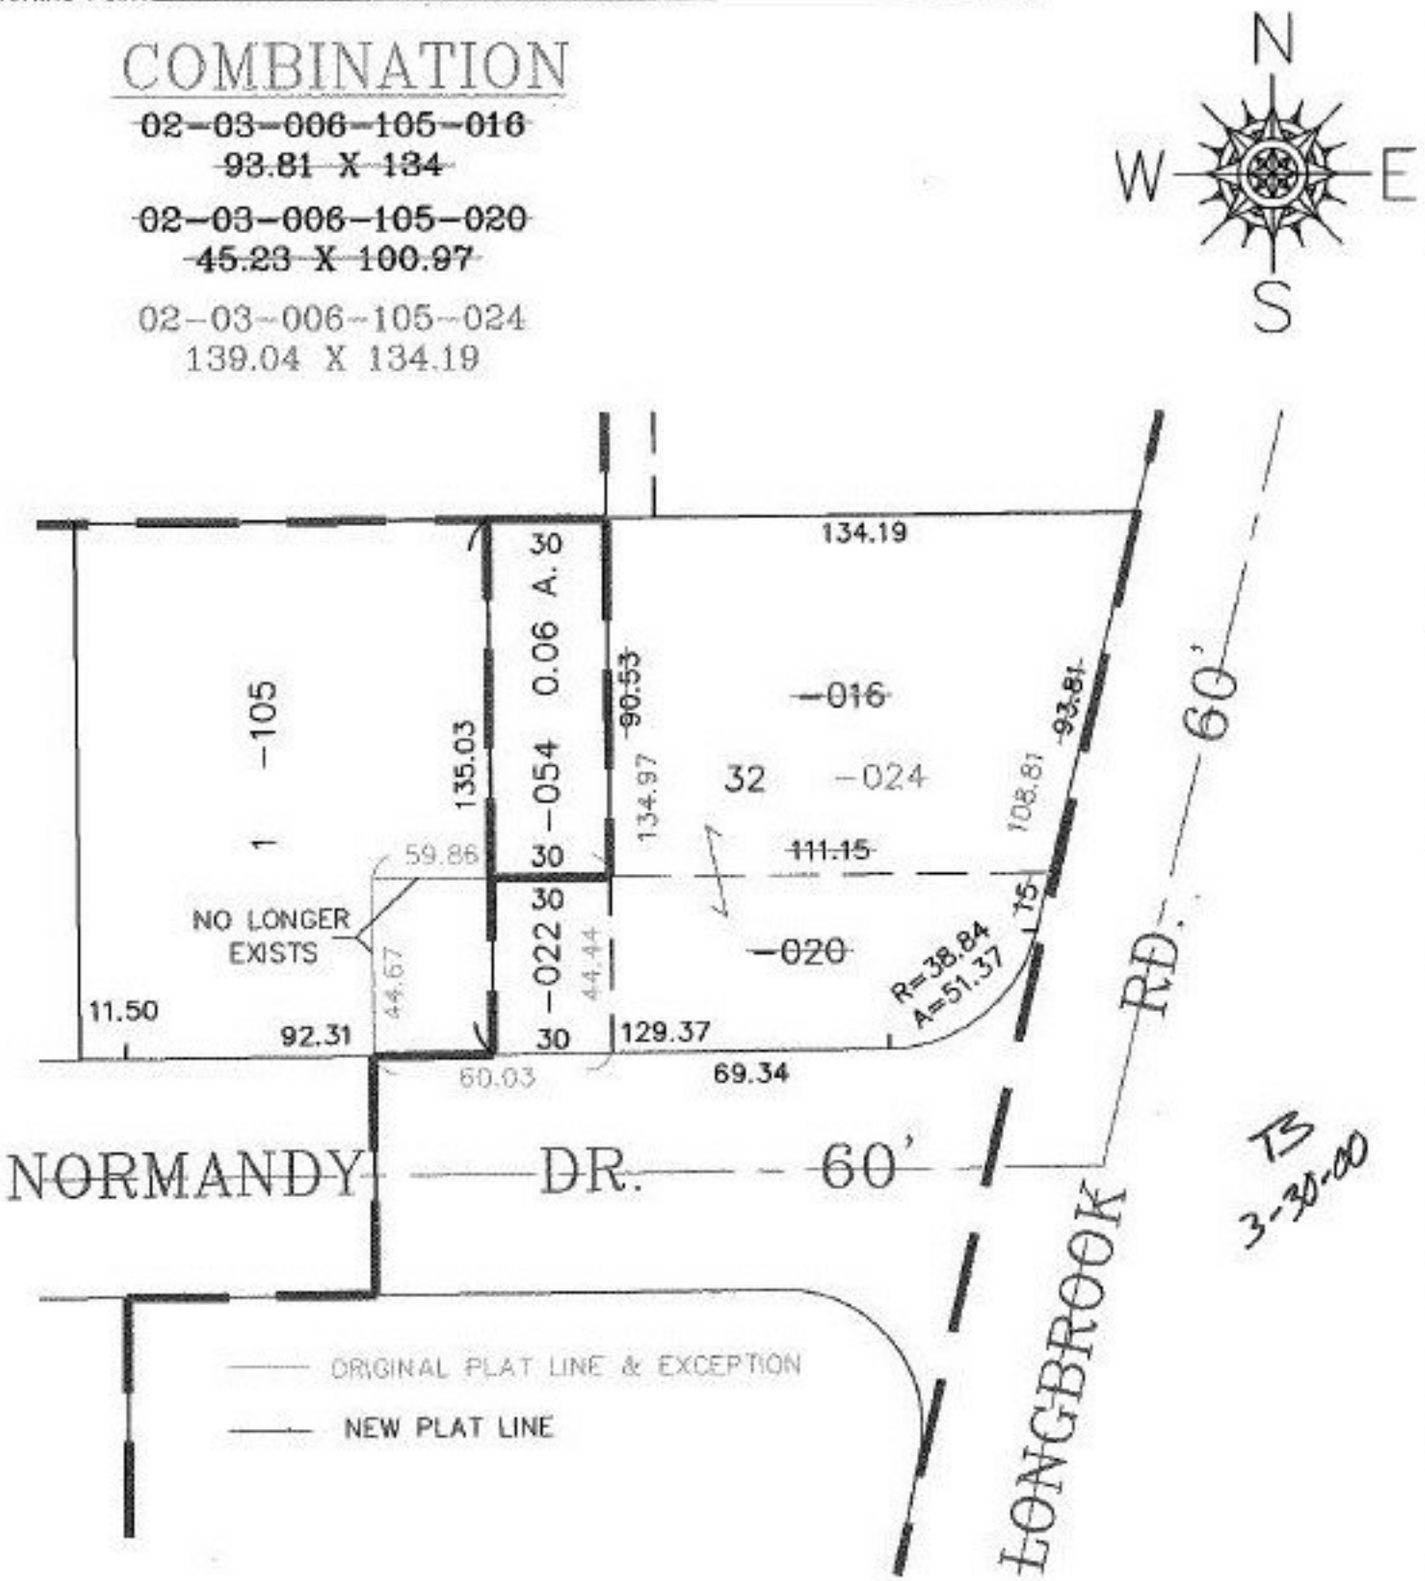

SPLITS/DEEDS PROCESSED
LORAIN COUNTY TAX MAP DEPARTMENT
226 MIDDLE AVE. ELYRIA, OHIO

SURVEYED BY: RAY HOLLIS
CLOSURE: CAN'T RUN
MAP PAGE(S): 02-03-006-A
APPROVED BY: T. SPILLMAN DATE: 02/11/00
SCALE: 1" = 50' PRIOR INSTRUMENT: DV 1041/805