PARENT PARCEL: 05-00-056-000-042 & -052
CHILD PARCEL: 05-00-056-000-056 THRU -058
STARTING POINT: NAIL , CL OF OBERLIN RD. & THE NORTH LINE OF O.L. 56

NO. 00284

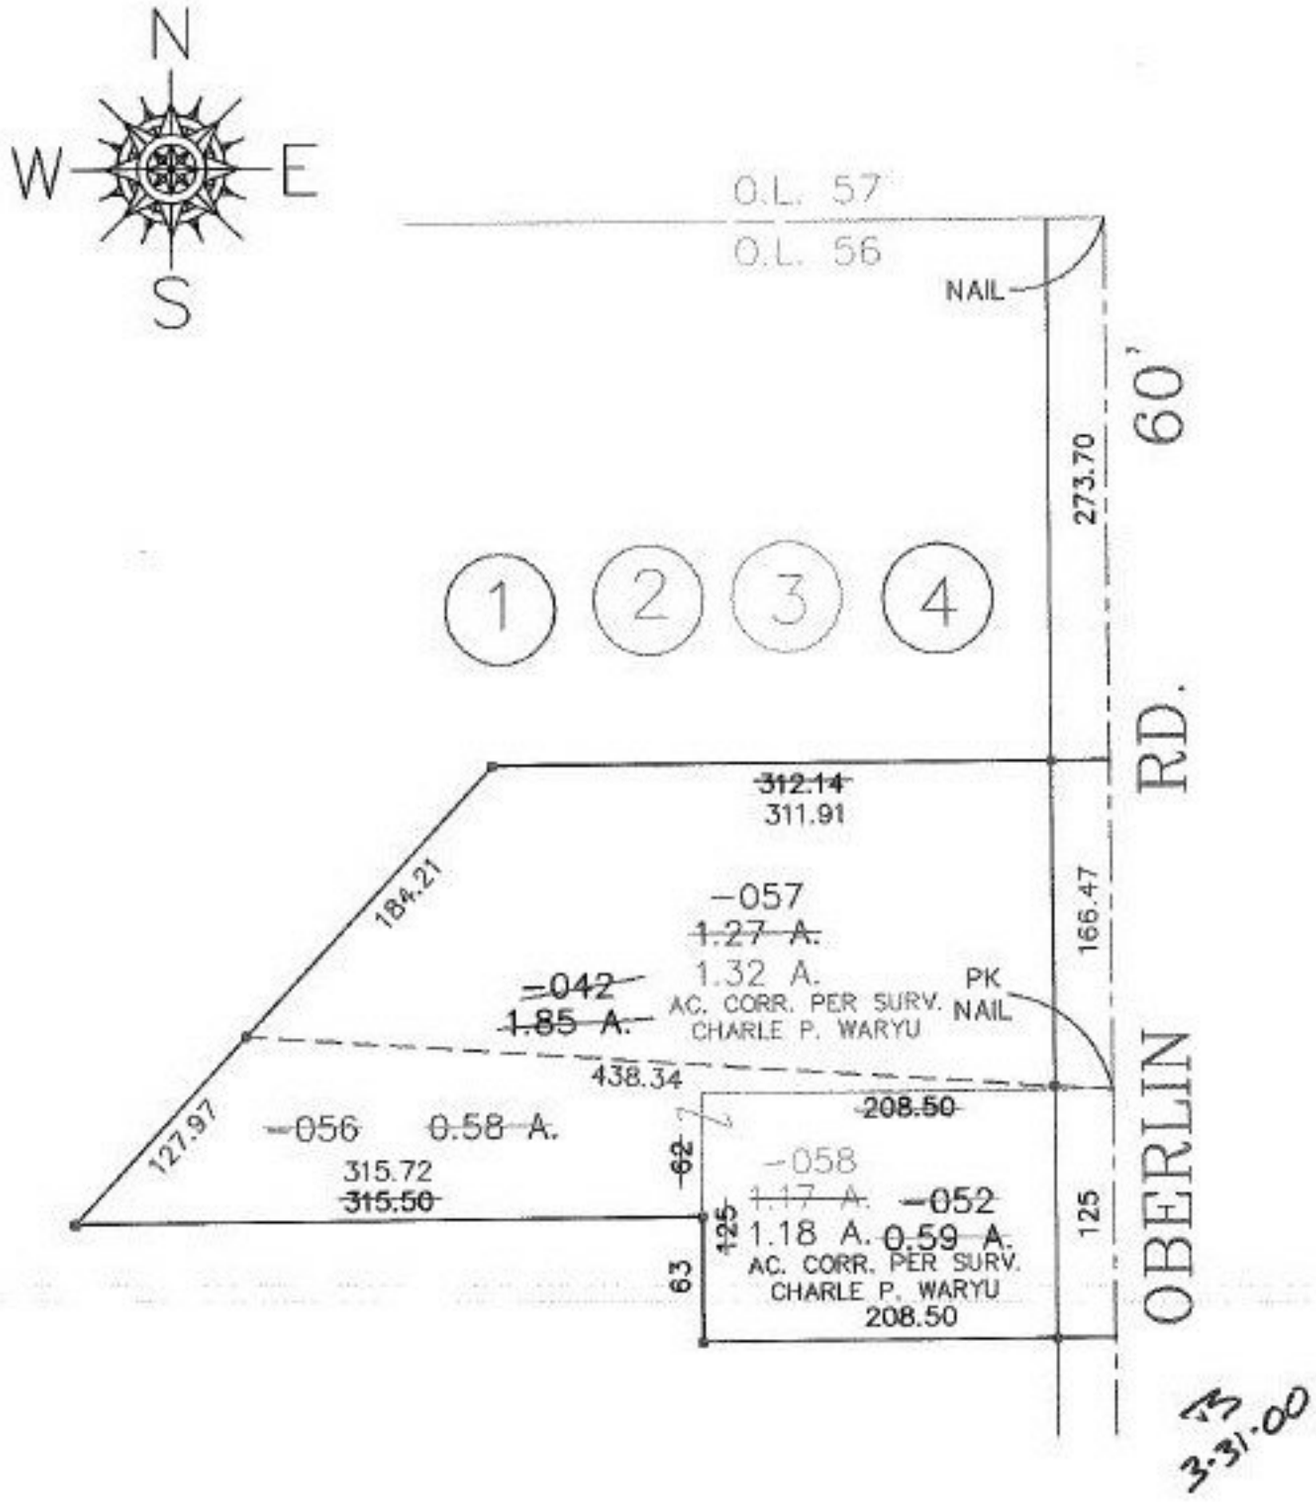

SPLITS/DEEDS PROCESSED

LORAIN COUNTY TAX MAP DEPARTMENT
226 MIDDLE AVE. ELYRIA, OHIO

SURVEYED BY: CHARLES P. WARYU
CLOSURE: 0.23 : 10,000
MAP PAGE(S): 05-00-056-B
APPROVED BY: T. SPILLMAN DATE: 12/13/99
SCALE: 1"= 100 PRIOR INSTRUMENT: OR 1093/327