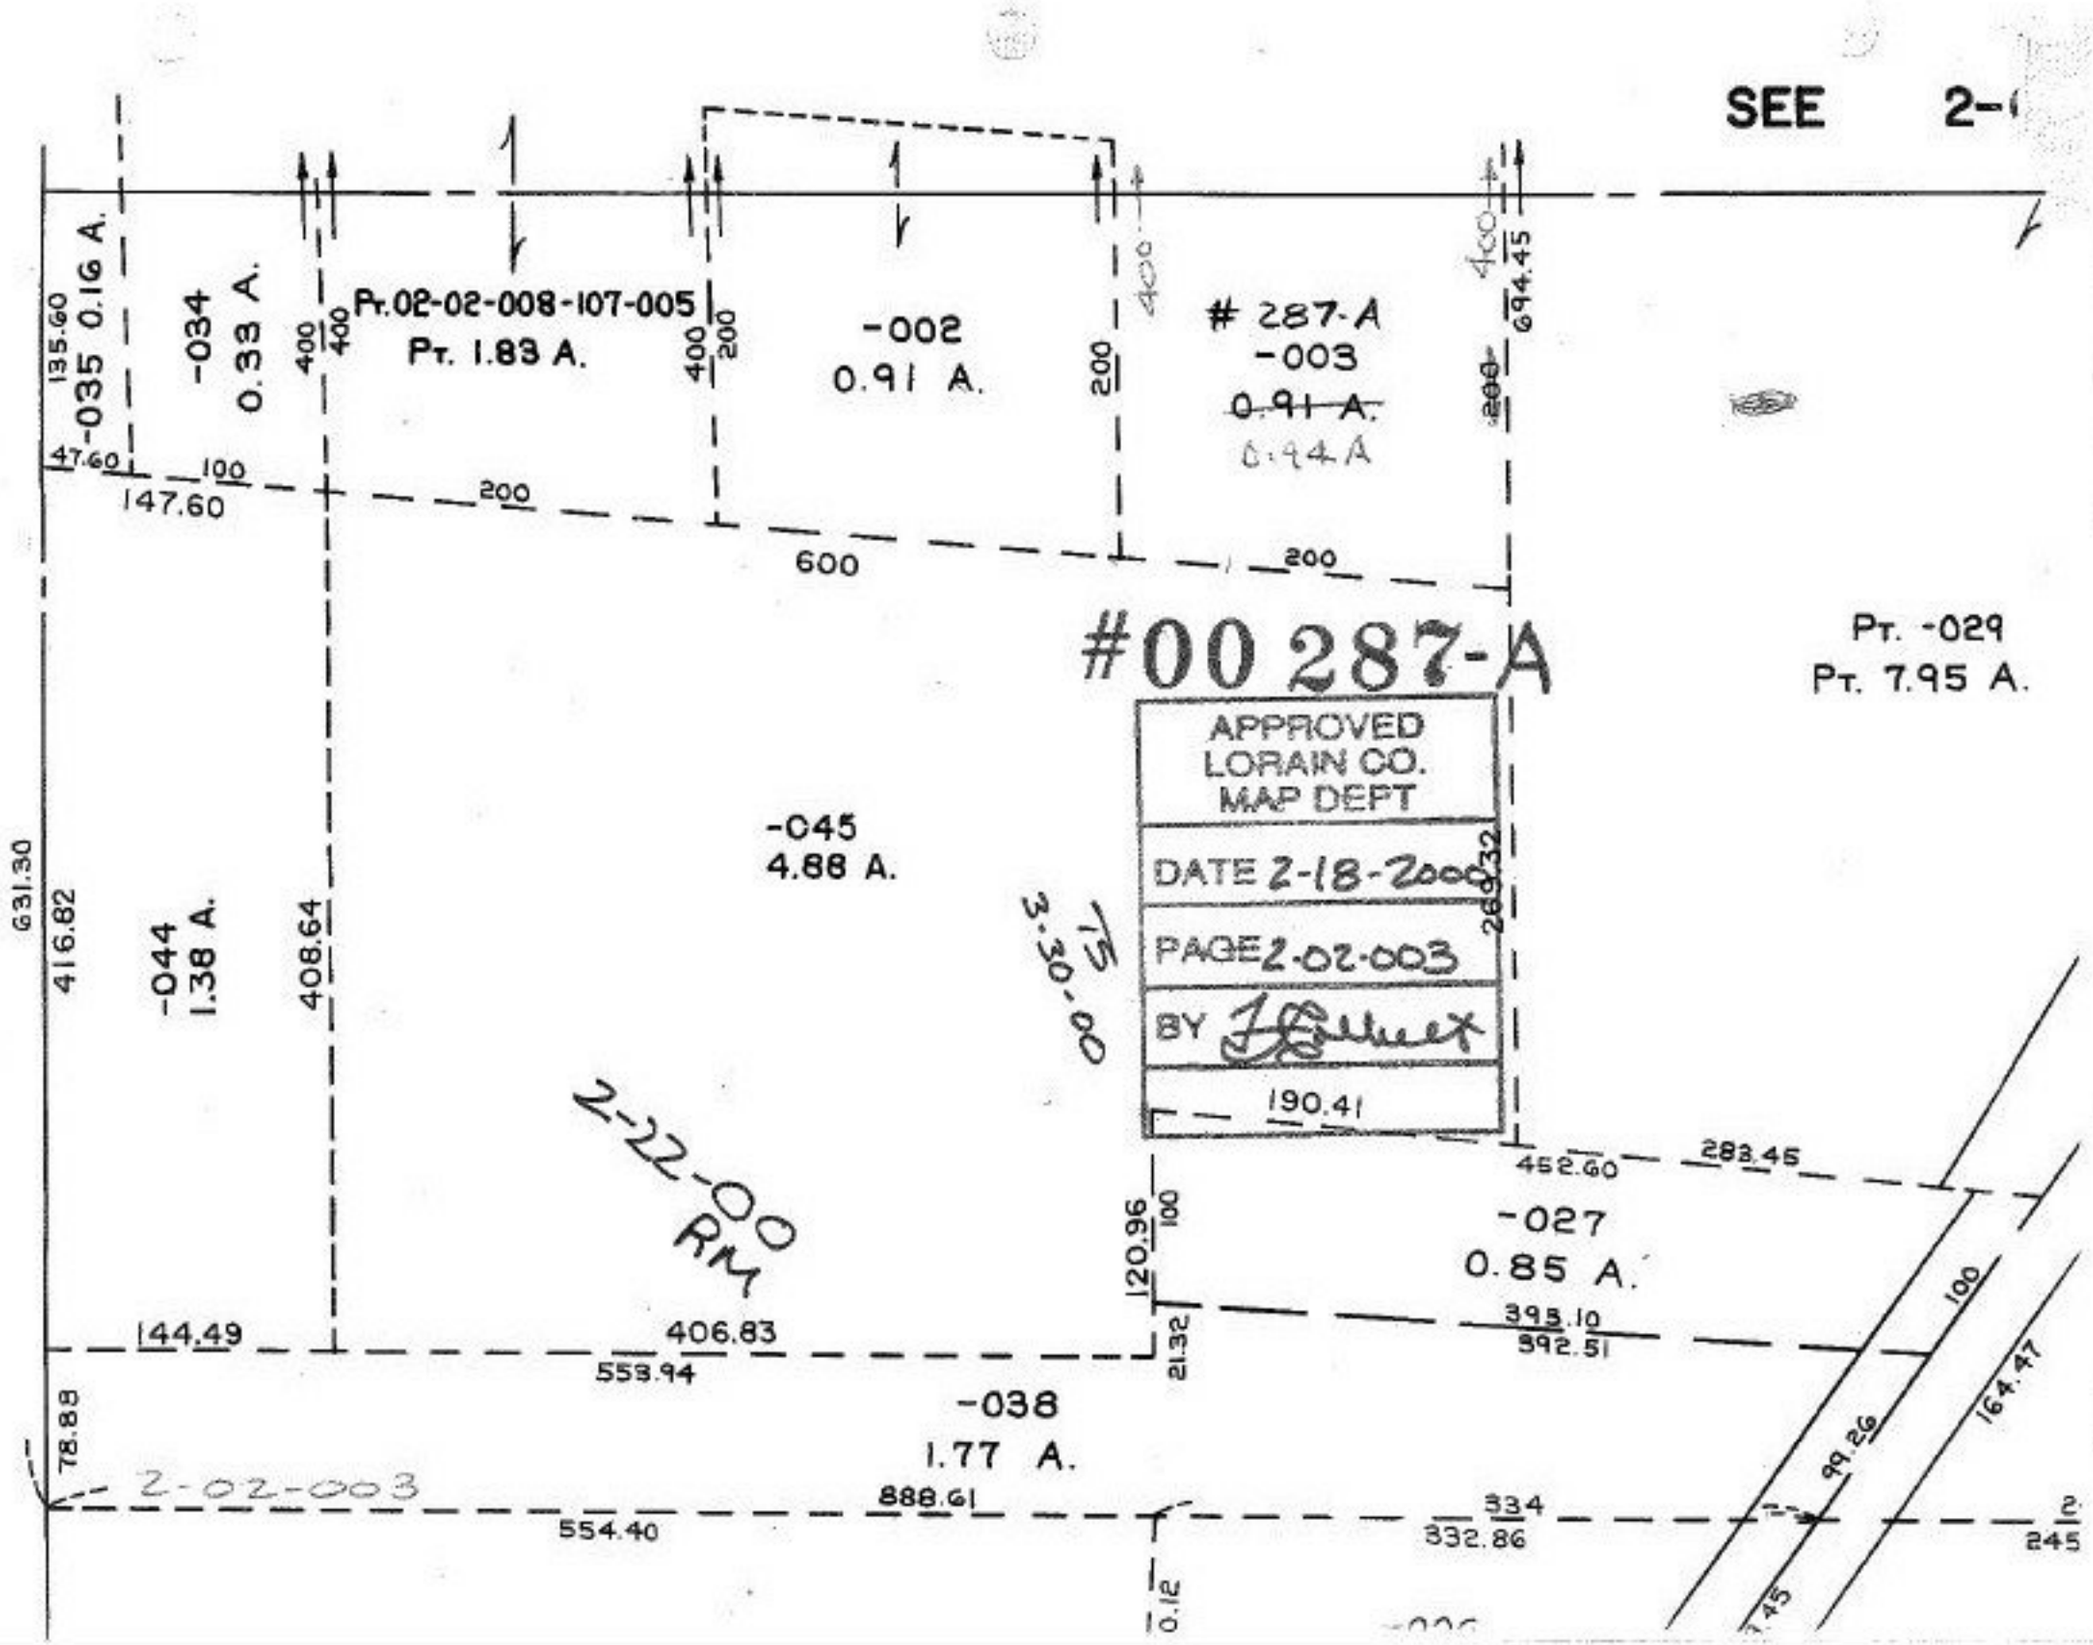
SEE 2-(
-035 0.16 A.
-034
0.33 A.
Pt. 02-02-008-107-005
Pt. 1.83 A.
-002
0.91 A.
287-A
-003
0.91 A.
0.94 A
#00 287-A
APPROVED
LORAIN CO.
MAP DEPT
DATE 2-18-2000
PAGE 2-02-003
BY
Pt. -029
Pt. 7.95 A.
-045
4.88 A.
-044
1.38 A.
3-30-00
2-22-00
RM
-027
0.85 A.
-038
1.77 A.
2-02-003
135.60
47.60
147.60
600
631.30
416.82
408.64
144.49
406.83
553.94
78.88
554.40
888.61
332.86
190.41
452.60
283.45
120.96
395.10
392.51
99.26
164.47
245