PARENT PARCEL: 10-00-015-108-062

CHILD PARCEL: 10-00-015-104-038, 10-00-015-108-065, 066

STARTING POINT: C/Ls ELYRIA-GRAFTON ROAD & WATERFALL DRIVE

NO. 00292

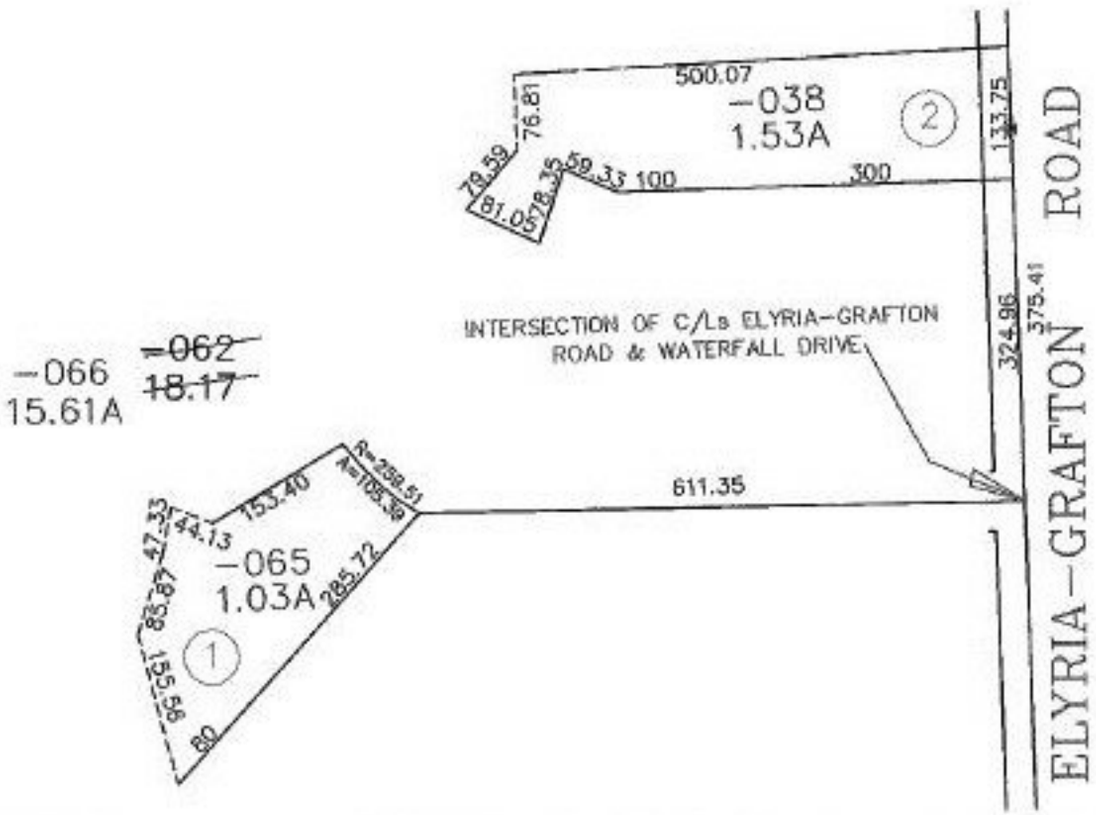

AN
2-15-00

SPLITS/DEEDS PROCESSED

LORAIN COUNTY TAX MAP DEPARTMENT

226 MIDDLE AVE. ELYRIA, OHIO

SURVEYED BY: DOUGLAS H MOSLEY

CLOSURE: 0.06 / 10,000

MAP PAGE(S): 10-00-015-0

APPROVED BY: F. COLBERT DATE: 12/30/99

SCALE: 1"= 200 PRIOR INSTRUMENT: 484/124