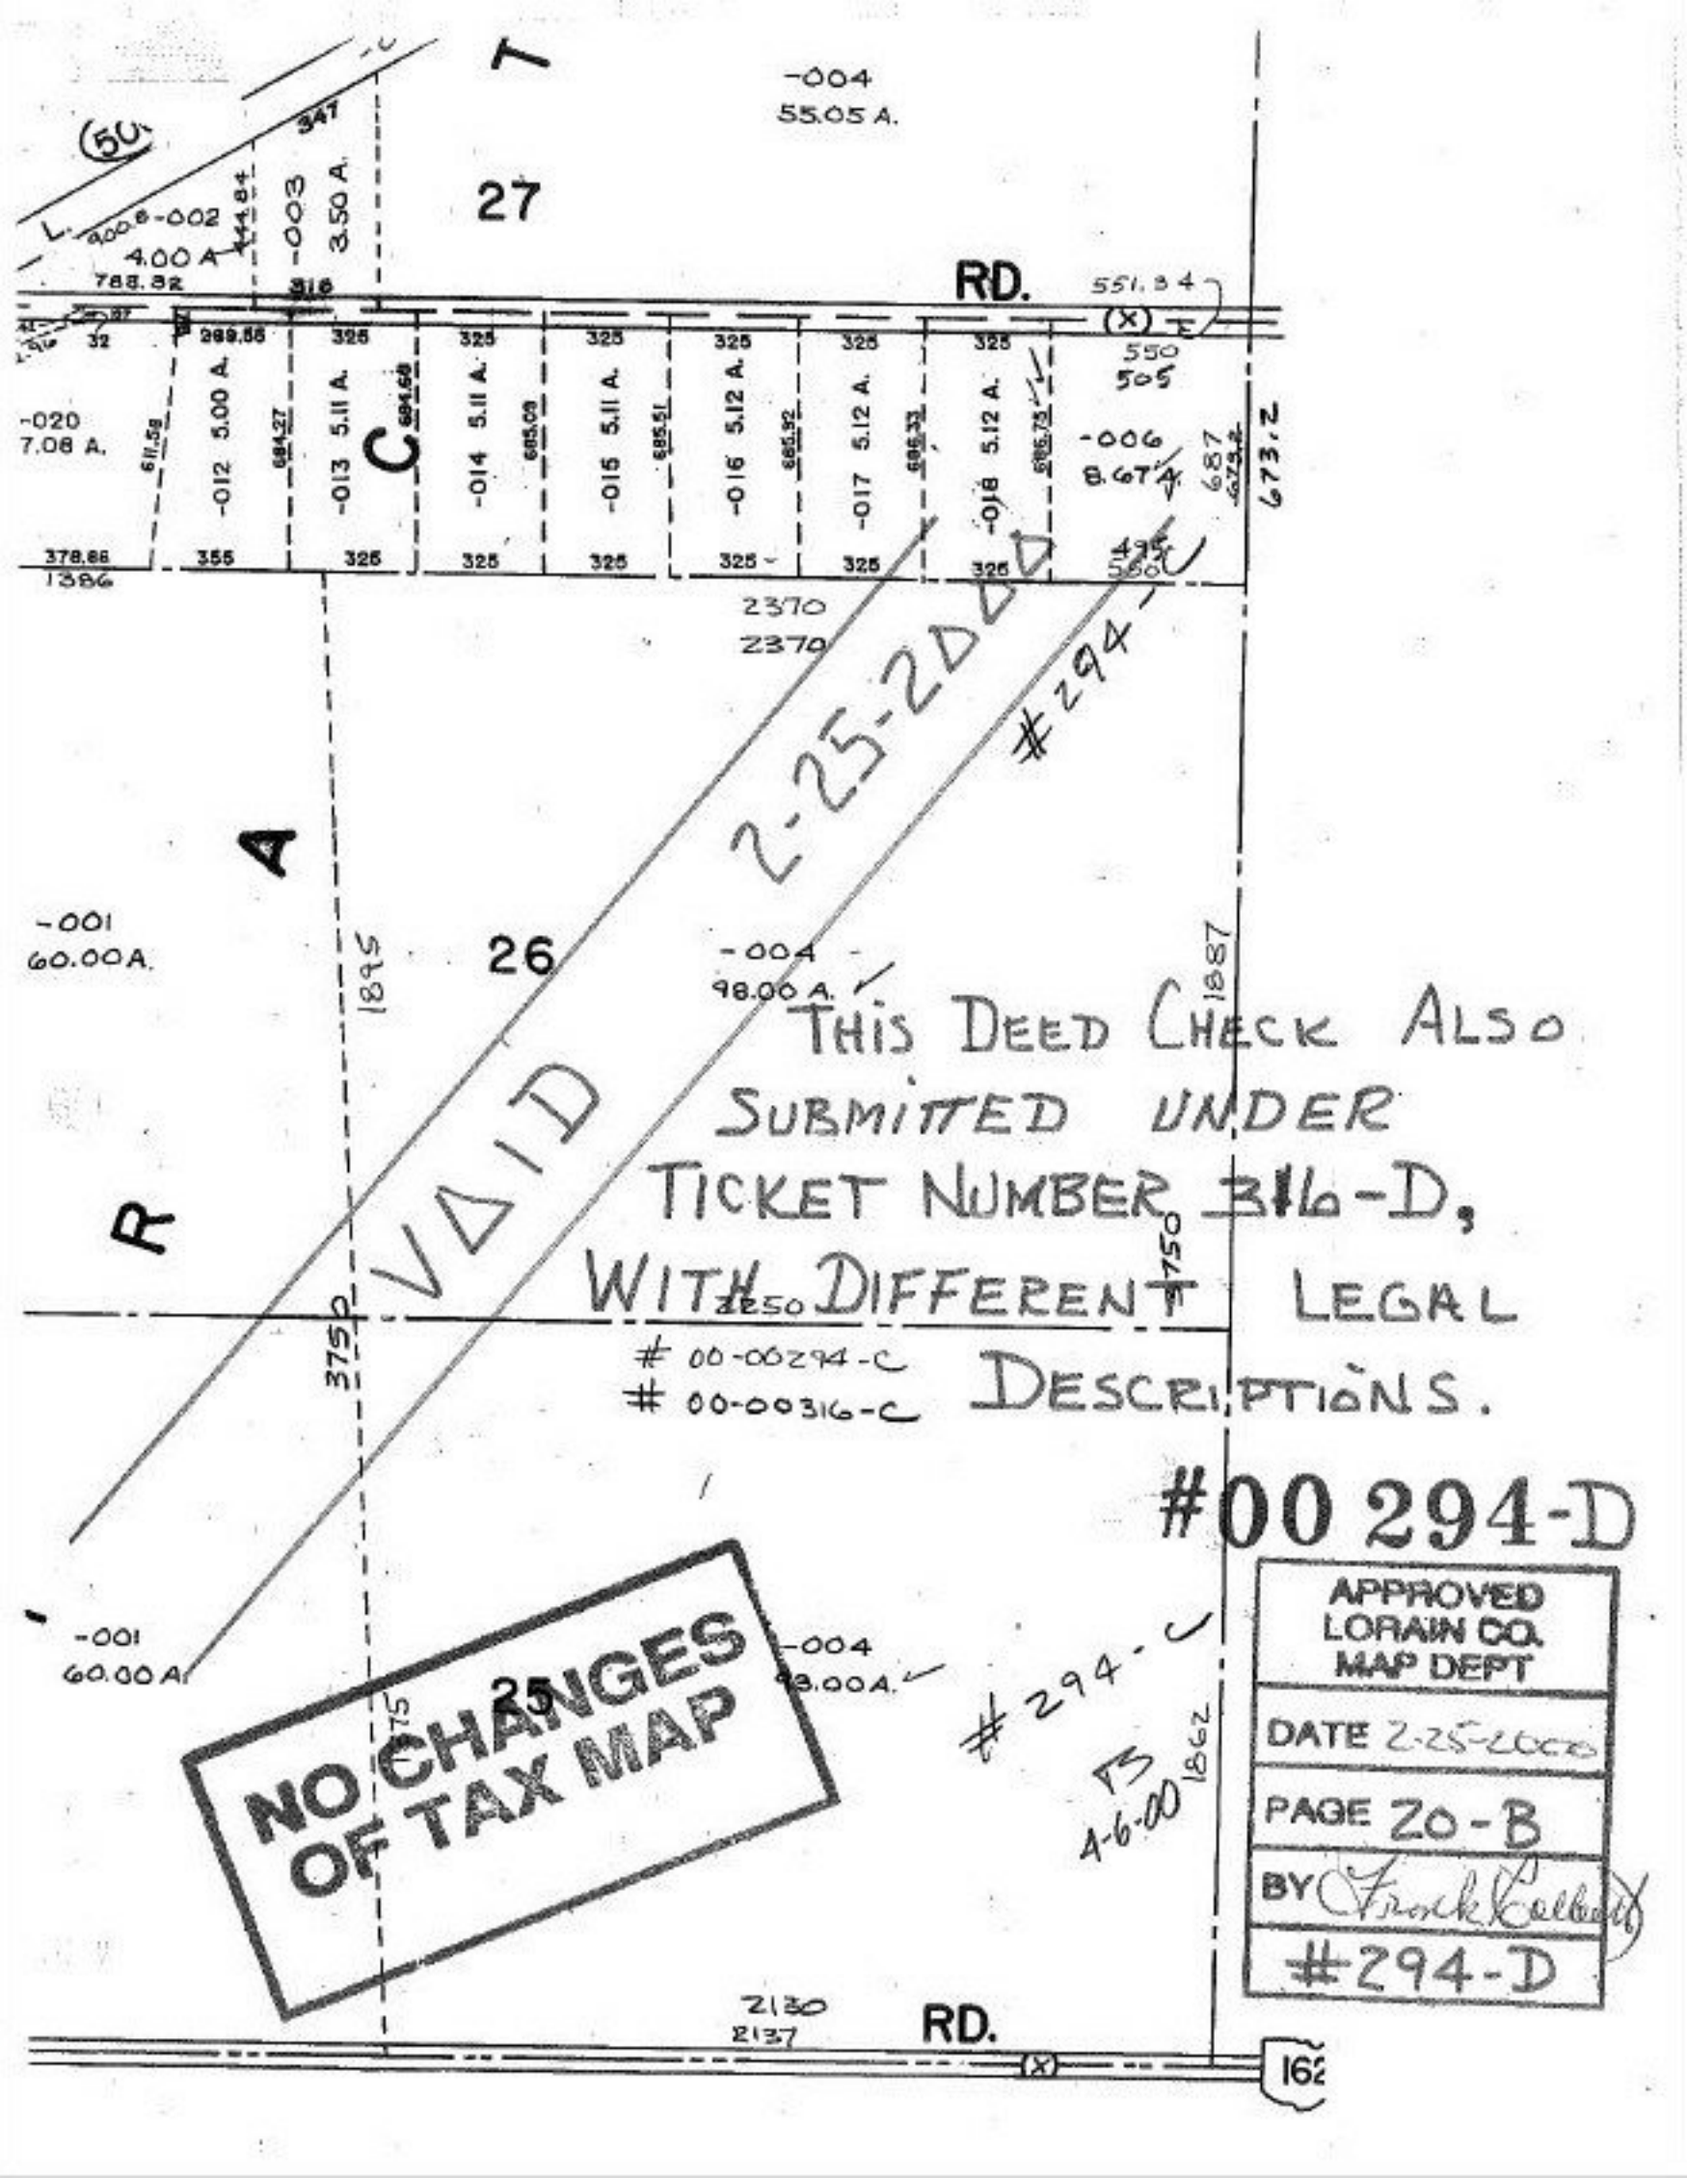
-004
55.05 A.
27
-002
4.00 A.
-003
3.50 A.
RD.
-020
7.08 A.
-012 5.00 A.
-013 5.11 A.
-014 5.11 A.
-015 5.11 A.
-016 5.12 A.
-017 5.12 A.
-018 5.12 A.
-006
B.G.T.
2370
2370
#294
2-25-2000
VOID
A
-001
60.00 A.
26
-004
98.00 A.
1895
1887
THIS DEED CHECK ALSO
SUBMITTED UNDER
TICKET NUMBER 316-D,
WITH DIFFERENT LEGAL
DESCRIPTIONS.
00-00294-C
00-00316-C
R
#00 294-D
APPROVED
LORAIN CO.
MAP DEPT
DATE 2-25-2000
PAGE 20-B
BY Frank Colbert
#294-D
NO CHANGES
OF TAX MAP
-001
60.00 A.
25
-004
98.00 A.
#294-C
FB
4-6-00
1862
2130
2137
RD.