PARENT PARCEL: 09-00-067-000-025, 028, 029

CHILD PARCEL: 09-00-067-000-033, 034, 035

STARTING POINT: SOUTHEASTERLY CORNER OF O.L. 67

NO. 00294

TS
2-14-00

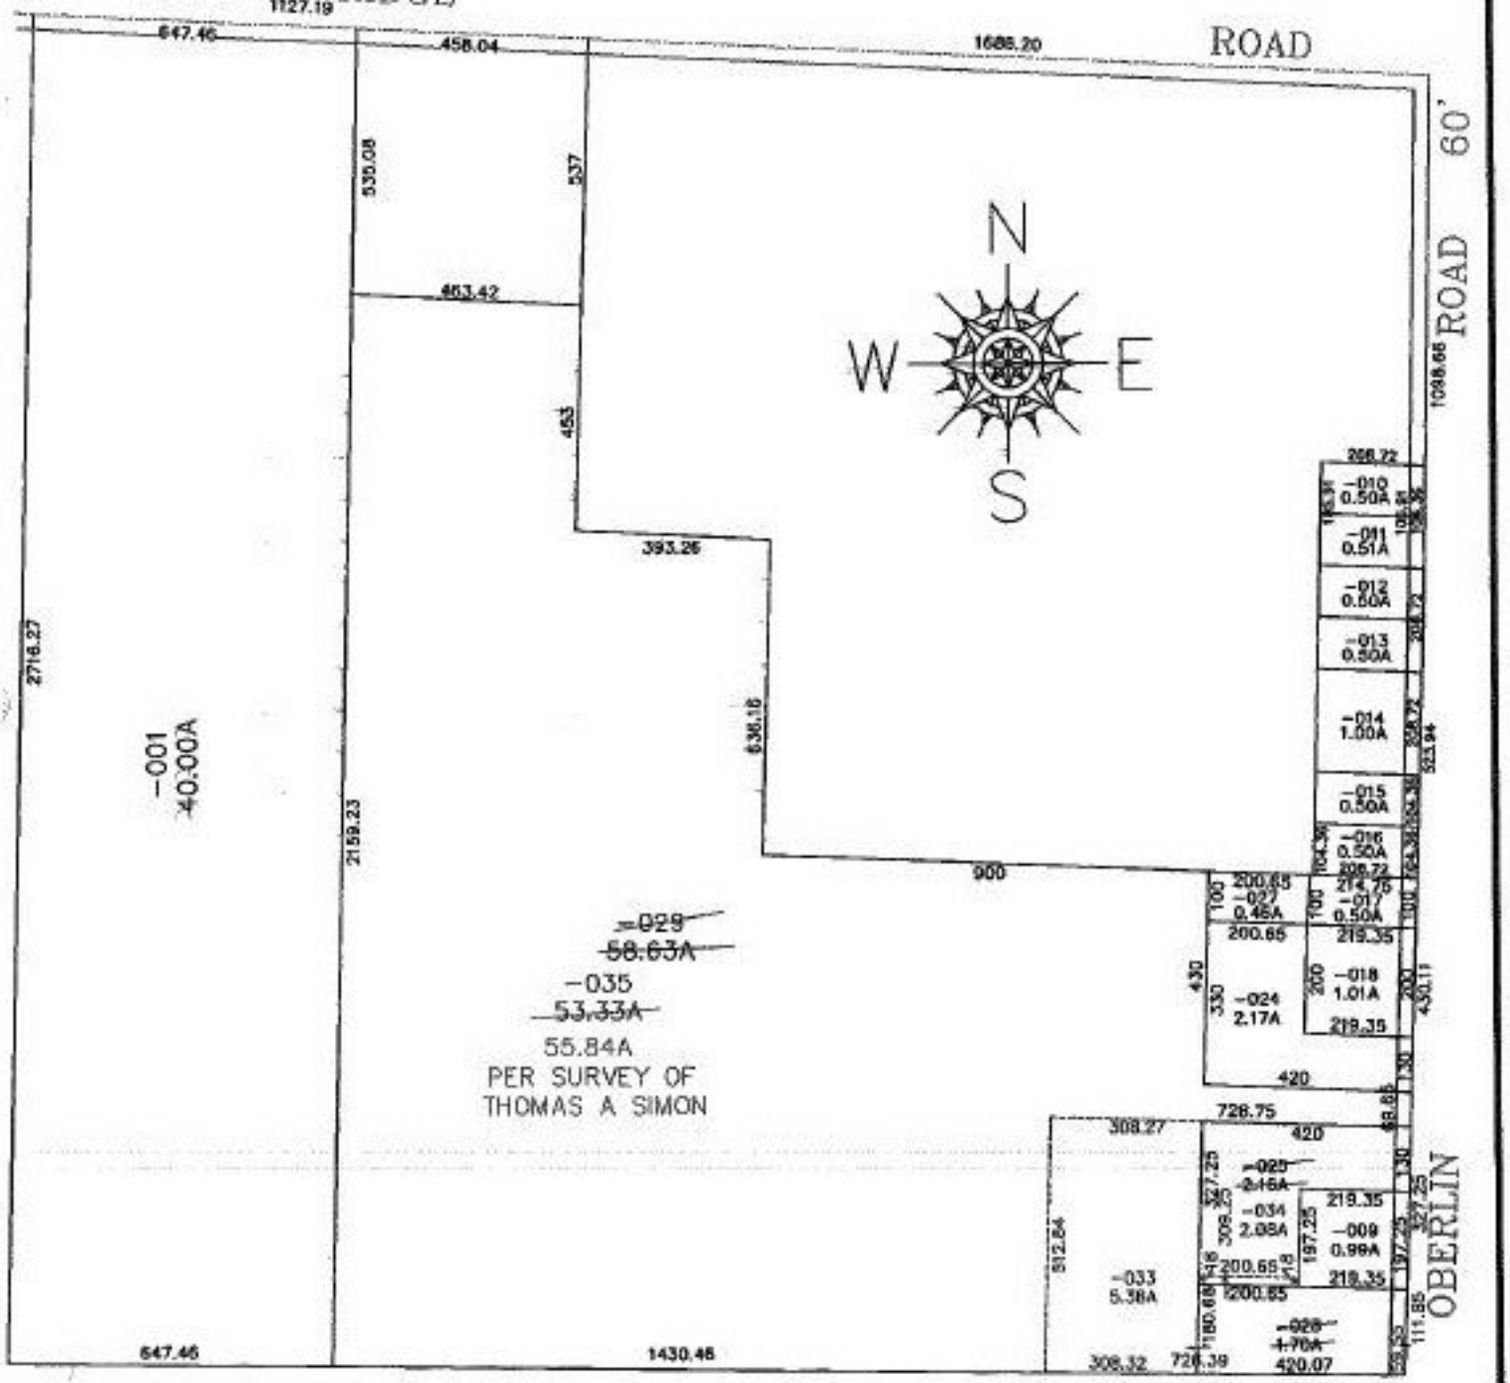

SPLITS/DEEDS PROCESSED

LORAIN COUNTY TAX MAP DEPARTMENT
226 MIDDLE AVE. ELYRIA, OHIO

SURVEYED BY: THOMAS A SIMON

CLOSURE: 0.02 / 10,000

MAP PAGE(S): 9-00-067-A & B

APPROVED BY: F. COLBERT DATE: 12/13/99

SCALE: 1" = 400 PRIOR INSTRUMENT: DV XXXX/XXX